



ADDENDUM 03

Date: June 30, 2023

Project: Johnson County Administration and Health & Human Services Buildings Remodeling Project

Project number: 21212000

Client: Johnson County, Iowa

Project Location: Iowa City Iowa

This Addendum forms a part of the contract documents and modifies the original bidding documents dated 6/6/2023 as noted below. Acknowledge receipt of this Addendum in the space provided on the bid form. Failure to do so may subject the bidder to disqualification.

To: All Plan Holders

Contents: (9) Addendum Narrative and Bidders Questions
(22) Specifications
(10) Drawing Sheets

SEALS AND SIGNATURES

I hereby certify that the portion of this technical submission described below was prepared by me or under my direct supervision and responsible charge. I am a duly licensed Professional Architect under the laws of the State of Iowa.

Signature

Date

Justin Bishop, AIA
Iowa license number 06497
My license renewal date is June 30, 2024

Pages or sheets covered by this seal:
Architectural Drawings and Divisions 0-13, except sections listed
under other seals



I hereby certify that the portion of this technical submission described below was prepared by me or under my direct supervision and responsible charge. I am a duly licensed Professional Engineer under the laws of the State of Iowa.

Signature

Date

Brent W. Jackman
Iowa license number 18193
My license renewal date is June 30, 2024

Pages or sheets covered by this seal:
Civil Drawings

I hereby certify that the portion of this technical submission described below was prepared by me or under my direct supervision and responsible charge. I am a duly licensed Professional Landscape Architect under the laws of the State of Iowa.

Signature

Date

Bradley C. Hill
Iowa license number 19593
My license renewal date is June 30, 2024

Pages or sheets covered by this seal:
033000, 042000, 051200, 053100, 055000, 316600

I hereby certify that the portion of this technical submission described below was prepared by me or under my direct supervision and responsible charge. I am a duly licensed Professional Engineer under the laws of the State of Iowa.

Signature

Date

Dwight Clopton Schumm
Iowa license number 13694
My license renewal date is December 31, 2021
Pages or sheets covered by this seal:
Mechanical, Plumbing, Electrical, Technology Drawings and
Divisions 21, 22, 23, 26, 27, 28

SPECIFICATIONS

*Unless noted below, individual specification sections are reissued in full as part of this addendum.
Additions to the specification language are indicated by a bold underline and deletions are crossed out.*

1. **071400—FLUID APPLIED WATERPROOFING**
 - a. ADD Soprema Colphene Barr to acceptable manufacturers.
2. **072100 THERMAL INSULATION**
 - a. Add Atlas Energy Shield XR to acceptable manufacturers.
3. **072500 WEATHER BARRIERS**
 - a. ADD Soprema Sopreseal LM 203 to acceptable manufacturers.
 - b. ADD Soprema Sopreseal Stick 1100T to acceptable manufacturers.
 - c. ADD Soprema Sopreseal LM 202 VP to acceptable manufacturers.
4. **092116 – GYPSUM BOARD ASSEMBLIES**
 - a. ADD clarification to high abuse corner trim specification.
5. **087100 – DOOR HARDWARE (revise section as noted below, spec section is not reissued)**
 - 2.2 HANGING DEVICES
 - A. Hinges
 5. Manufacturers:
ADD Ives (IV)
 - B. Continuous Geared Hinges
 1. Manufacturers:
ADD Ives (IV)
 - 2.3 POWER TRANSFER DEVICES
 - A. Concealed Quick Connect Electric Power Transfers
 1. Manufacturers:
ADD Von Duprin (VD) EPT
 - B. Electric Door Wire Harnesses
 1. **ADD Allegion CONN/Molex - Connection Kit - Tool**
 2. Manufacturers:
ADD "CONN System" Schlage/Von Duprin
 - 2.4 DOOR OPERATING TRIM
 - A. Flush Bolts and Surface Bolts
 5. Manufacturers:
ADD Ives (IV)
 - B. Door Push Plates and Pulls
 5. Manufacturers:
ADD Ives (IV)
 - 2.7 MECHANICAL LOCKS AND LATCHING DEVICES
 - A. Mortise Locksets, Grade 1
 2. Manufacturers:
ADD Schlage (SC) L9000 Series
DELETE: No Substitution – Facility Standard

- B. Multi-Point Locksets
 - 1. Manufacturers:
ADD Schlage (SC) LM9000 Series
DELETE: No Substitution – Facility Standard
- 2.8 ELECTROMECHANICAL LOCKING DEVICES
 - A. Electromechanical Mortise Locksets, Grade 1
 - 3. Manufacturers:
ADD Schlage (SC) L9000 EL/EU/RX Series
DELETE: No Substitution – Facility Standard
 - B. Electromechanical Multi-Point Locks
 - 2. Manufacturers:
ADD Schlage (SC) LM9000 Series
DELETE: No Substitution – Facility Standard
- 2.10 CONVENTIONAL EXIT DEVICES
 - B. Conventional Push Rail Exit Devices
 - 1. Manufacturers:
ADD Von Duprin (VD) 35A/99 Series
DELETE: No Substitution – Facility Standard
- 2.11 ELECTROMECHANICAL EXIT DEVICES
 - A. Electromechanical Push Rail Exit Devices
 - 4. Manufacturers:
ADD Von Duprin (VD) 35A/99 Series
DELETE: No Substitution – Facility Standard
- 2.12 DOOR CLOSERS
 - B. Door Closers, Surface Mounted
 - 1. Manufacturers:
ADD LCN (LC) 4040XP Series
DELETE: No Substitution – Facility Standard
- 2.13 ELECTROHYDRAULIC DOOR OPERATORS
 - A. Low Energy Operators
 - I. Manufacturers:
ADD LCN (LC) 4600 Series
- 2.14 ARCHITECTURAL TRIM
 - A. Door Protective Trim
 - 6. Manufacturers:
ADD Ives (IV)
- 2.15 DOOR STOPS AND HOLDERS
 - B. Door Stops and Bumpers
 - 1. Manufacturers:
ADD Ives (IV)
 - C. Overhead Door Stops and Holders
 - 1. Manufacturers:

ADD Glynn-Johnson (GJ)

- 2.16 ARCHITECTURAL SEALS
 - A. Thresholds, Weatherstripping and Gasket Seals
 - F. Manufacturers:

ADD Zero Products (ZE)

- 2.17 ELECTRONIC ACCESSORIES
 - A. Door Position Switches
 - 1. Manufacturers:
- ADD Schlage Electronics (SE) 679 Series**

**6. 26 0533 – RACEWAYS AND BOXES FOR ELECTRICAL SYSTEMS
(revise section as noted below, spec section is not reissued)**

- a. **CHANGE** 2.01, B. Rigid Conduit: Full weight, threaded, rigid steel conduit, galvanized inside and out by hot dip or electro galvanized process. Additional protection by electrostatically applied baked coating. Thread protective caps and couplings. Use where subject to physical damage, exterior exposed locations, and where underground PVC raceway transitions through concrete.

DRAWINGS

CIVIL

None

STRUCTURAL

- 1. S-001 – STRUCTURAL NOTES
 - a. Under foundation parameters, REMOVE note FP2.1

ARCHITECTURAL

- 1. AD-101A – ADM DEMO FLOOR PLANS AND ELEVATIONS
 - a. DRAWING 1:
 - i. REVISE callout as shown in attached drawing.
 - b. DRAWING 2:
 - i. REVISE callout as shown in attached drawing.
 - c. ADD Drawings 12 and 13.
- 2. AD-101B – HHS LEVEL THREE DEMO FLOOR PLAN AND RCP
 - a. DRAWING 1:
 - i. ADD demountable wall to be salvaged and returned to owner as shown in attached drawing.
- 3. A-121A – ADM FINISH PLANS
 - a. DRAWING 4:
 - i. REVISE vestibule finishes to walk off mat as shown in attached drawing.
 - b. KEYNOTES:

- i. REVISE keynotes to coordinate with vestibule finish change.
- 4. A-441 – VERTICAL CIRCULATION – ENLARGED PLANS
 - a. DRAWING 14 AND 15:
 - i. REMOVE demo notes from new plans as shown in attached drawing.
 - b. DRAWING 21:
 - i. REVISE demo and new tags as shown in attached drawing.
- 5. A510 – ADM MILLWORK DETAILS
 - a. DRAWING 1
 - i. ADD quartz wrapper to HHS column as shown in attached drawing.
 - b. DRAWING 4
 - i. ADD quartz wrapper to HHS column as shown in attached drawing.
- 6. A608 – FINISH SCHEDULE AND SPECS
 - a. FINISH SCHEDULE
 - i. REVISE VF-1 to be “3M Scotchcal Clearview graphic film or equal.” as shown in attached drawing.

PLUMBING

None

MECHANICAL

None

ELECTRICAL

- 1) E-101A ADM ELECTRICAL LIGHTING PLANS
 - a) Adm Level 1 Lighting Plan. Refer to Cust 144. CHANGE light switch to occupancy sensor type “OS-B”.
 - b) ADM – Mechanical Mezzanine Plan. ADD lighting sequence ‘1’ to all type LL2 light fixtures.
- 2) E-201A ADM ELECTRICAL POWER PLANS
 - a) ADM- Level 2 Electrical Plan. Refer to Open Office 220. CHANGE tag ABF-6 tag to ABF-5.
- 3) E-201A ADM ELECTRICAL POWER PLANS
 - a) ADM – Level 1 Electrical Power Plan. Refer to Workroom 130E. ADD ‘GFI’ designation to one above counter receptacle south of the sink. This receptacle is within 6’ of the sink.
- 4) E-400 ENLARGED ELECTRICAL PLANS
 - a) HHS – BOARD ROOM 301 ENLARGED POWER PLAN – PHASE 2.
 - i) ADD ABF designations and circuits for unlabeled floor boxes. Refer to attached revised sheet E-400.

TECHNOLOGY

None

ARCHITECTURAL SIGNAGE

- 1. AS001 – SIGN LOCATION PLANS HHS BUILDING
 - a. DRAWING 2:
 - i. DELETE door mounted restroom sign.



2. AS002 – SIGN LOCATION PLANS ADMIN BUILDING
 - a. DRAWING 1 AND 2:
 - i. DELETE door mounted restroom sign.
3. AS003 – SIGN TYPE DRAWINGS A-H
 - a. SIGN TYPE C, E, F AND H
 - i. ADD Lexan backer at glass mounted locations, see drawings.

BIDDER QUESTIONS:

Question: Can additional building access be provided?

Answer: The Admin and HHS buildings are public buildings and can be accessed during regular business hours. Access to restricted areas can be arranged, pending availability, by contacting:

Dave Curtis
Johnson Country Facilities Director
319-688-5851

Questions: On sheet AS003 Sign Type B - Two sizes are shown. How are the sizes to be counted/appropriated per the location plans?

Answer: Sign size will need to be determined based on final content. A sign message schedule with content for each sign will be completed during construction, and would need to be compiled as part of production process.

Question: On sheet AS003 Sign Type C - Sidelight panels - will these need a glass back up on the opposite side of the glass and if so what material and finish?

Answer: The design intent is to fit the width of each sidelight location, and mount the sign panel within the window frame, at these locations, install a 0.020" 8B35 Lexan backer.

Question: On sheet AS003 Sign Type G – Is the second door-mounted sign required at restrooms?

Answer: The second restroom sign is not required, delete per revised drawings.

Question: On sheet AS003 Sign Type K – is called out as VF-1 on the Finish Schedule (A608) as 3M Fasara. Sheet AS004 notes 3M Scotchcal Clear View Graphic Film or equal, please clarify.

Answer: The vinyl will have a custom design and need to be produced as a large format print. The appropriate specification is “3M Scotchcal Clear View Graphic Film or equal.” The reference on A608 will be corrected.

Question: Per Spec 26 0533 2.01 all feeders larger than 2-1/2” are to be Galvanized rigid conduit. The Admin and HHS building are all EMT, will the GRC be enforced on this or is EMT acceptable for the feeders larger than 2-1/2” .



Answer: 2 ½" reference will be removed in Addendum 3

Question Admin Bldg. Conference room 150B shows a floor box but no floor box type.

Answer: See Addendum 2 for clarification.

Question: Admin Bldg. Office 220 shows a type ABF-6 floor box, this is an on grade floor box. Should this have been an ABF-5 like the other floor box in this office.

Answer: Yes, ABF-5. See Addendum 3 for clarification.

Question; Admin Bldg. Open office 230- there are two floor boxes shown on the two most southern tables with floor boxes but no types.

Answer: See Addendum 2 for clarification.

Question; What type of tile base is going in the restrooms?

Answer: None. Wall tile to extend to floor, floor tile to extend to wall.

Question: The steps and ramp in the corridor just outside of the NW side of 210A, is showing PCT-1. I need to know if the ramp will be concrete and to confirm that tile is to be put on both the ramp and the steps to the right of the ramp. If so, does the ramp edge(s) need a Schluter trim piece?

Answer: The ramp is concrete. The tile should be installed on both the ramp and the steps to the right of the ramp. The steps should be finished with a PCT-1 tread profile per detail 16/A-441

Question: Board Room 301 shows CPT-4 on the drawing but the Legend shows CPT-2 as the carpet tile. I need to know which carpet is used in this room.

Answer: The legend indicates that Board Room 301 should have CPT-2 carpet in CPT Pattern 4 (Herringbone)

Question: What material is existing on the floors of areas; S1-3 Stair 1-3 Landing (meets CPT 2,3,4), 304B, 305B and 306

Answer: S1-3: Ceramic tile
304B: Ceramic tile
305B Ceramic tile
306: Concrete



Question: WOGs are on the spec for Vestibules 155 and 100. These are EXTREMELY pricy and cannot be cleaned and are also known to look tired and weathered after 5 years. Walk-off tiles might be a better solution. Please advise.

Answer: Walk off grilles have been changed to walk off carpet tile. See revised drawings for locations and specifications.

Question: Do the high abuse corner guards/beads only go where they are shown on the details, or are they supposed to be on all the outside corners? How high do they go? The spec calls them out at corner beads, but the details say corner guards.

Answer: The high abuse corner guards (Fry Reglet DMCT-1250) are only required at locations noted on the drawings. The corner guards should be installed full height from floor to ceiling.

Question: The pre-bid agenda under item 3, notes that the Owner will be performing separate AV and Technology work. Is any of the owner's separate scope in the bid documents and will be removed?

Answer: No, the owner's AV and Technology work is separate from the scope described in the bid documents.

Question: On S-001, helical piers are noted to be required at the HHS building. Is this in the scope?

Answer: The reference to helical piers is related to scope that has been taken out of the project. There will be no foundation work at the HHS building. See addendum item for sheet S-001

Question: Will a new server and software need to be included in bid for additional doors and credentialing?

Answer: No.

END OF ADDENDUM #3

**SECTION 07 14 00
FLUID-APPLIED WATERPROOFING**

PART 1 GENERAL

1.01 SECTION INCLUDES

- A. Fluid-Applied Waterproofing.

1.02 REFERENCE STANDARDS

- A. ASTM D412 - Standard Test Methods for Vulcanized Rubber and Thermoplastic Elastomers-- Tension 2016 (Reapproved 2021).
- B. ASTM D746 - Standard Test Method for Brittleness Temperature of Plastics and Elastomers by Impact 2020.
- C. ASTM E96/E96M - Standard Test Methods for Gravimetric Determination of Water Vapor Transmission Rate of Materials 2021.

1.03 ADMINISTRATIVE REQUIREMENTS

- A. Coordinate with the installation of other components that comprise the exterior building envelope.

1.04 SUBMITTALS

- A. Shop Drawings: Indicate special joint or termination conditions and conditions of interface with other materials.
- B. Warranty: Submit manufacturer warranty and ensure forms have been completed in Owner's name and registered with manufacturer.
- C. Compatibility: Submit letter from manufacturer stating that materials proposed for use are permanently chemically compatible and adhesively compatible with adjacent materials proposed for use. Submit letter from manufacturer stating that cleaning materials used during installation are chemically compatible with each of the adjacent materials proposed for use.

1.05 QUALITY ASSURANCE

- A. Manufacturer: System shall be manufactured and marketed by a firm with a minimum of 20 years experience in the production and sales of waterproofing and air barrier products. Manufacturers proposed for use but not named in these specifications shall submit evidence of ability to meet all requirements specified, and include a list of projects of similar design and complexity completed within the past 5 years.
- B. Installer Qualifications:
 - 1. Company specializing in performing the work of this section as a primary occupation, which has at least 3 years of documented experience and is certified in writing by the manufacturer.
 - 2. Installer must show evidence of adequate equipment and trained field personnel to successfully complete the project in a timely manner.
 - 3. Company performing the work of this section will also perform the work of all other related air and weather barrier sections including, but not limited to:
 - a. Section 07 25 00 - Weather Barriers
- C. Materials: Fluid applied waterproofing material shall be cold vulcanized two part synthetic rubber based system free of isocyanates and bitumen. For each type of material required for the work of this section and related sections of performance, provide primary materials, associated materials, and material assemblies which are the products of one manufacturer.
- D. Pre-Installation Conference: A pre-installation conference shall be held two weeks prior to commencement of field operations to establish procedures to maintain optimum working conditions and to coordinate this work with related and adjacent work. Attendance shall include the contractors of adjacent systems and substrates, and the waterproofing manufacturer representative. Agenda for meeting shall include but not be limited to the following:

1. Review of submittals.
2. Review of surface preparation, minimum curing period and installation procedures.
3. Review of special details and flashings.
4. Sequence of construction, responsibilities and schedule for subsequent operations.
5. Review of mock-up requirements.
6. Review of inspection, testing, protection and repair procedures.

1.06 MOCK-UP

- A. Construct mock-up to represent finished work including inside and outside corners. Incorporating back-up wall, cladding, window and doorframe and sill, insulation, flashing and any other critical junction (roof, foundation, etc).

1.07 DELIVERY, STORAGE AND HANDLING

- A. Deliver materials and products in labeled packages. Store and handle in strict compliance with manufacturer's instructions, recommendations and material safety data sheets. Protect from damage from sunlight, weather, excessive temperatures and construction operations. Remove damaged material from the site and dispose of in accordance with applicable regulations.
- B. Do not double-stack pallets of fluid applied membrane components on the job site. Provide cover on top and all sides, allowing for adequate ventilation.
- C. Protect fluid-applied membrane components from freezing and extreme heat.
- D. Sequence deliveries to avoid delays, but minimize on-site storage.

1.08 PROJECT CONDITIONS

- A. Perform work only when existing and forecasted weather conditions are within the limits established by the manufacturer of the materials and products used.
- B. Proceed with installation only when substrate construction and preparation work is complete and in condition to receive membrane waterproofing.

1.09 WARRANTY

- A. Fluid Applied Waterproofing Membrane: Provide written 5 year material warranty issued by the membrane manufacturer upon completion of the work.
- B. Contractor shall correct defective work within a two year period after date of substantial completion, remove and replace materials concealing waterproofing at no extra cost to the Owner. Bentonite grouting shall not be acceptable.

PART 2 PRODUCTS

2.01 MATERIALS

- A. Fluid applied membrane, self-curing, synthetic rubber based material:
 1. Basis-of-Design: Provide W.R. Grace; Procor System or a comparable product by one of the following:
 - a. Henry Company. Aqua-Bloc System.
 - b. Carlisle, Barricoat System.
 - c. TK Products, TK-Hydromax 2002 VOC.
 - d. Tremco, TREMproof 260.
 - e. **Soprema Colphene Barr [ADD 3]**
 - f. Note that the same manufacturer of material used for Section 07 25 00 Weather Barriers of this project, shall be the same manufacturer of material used for this section. Written manufacturer compatibility and adhesion certification shall be required.

2.02 FLUID APPLIED WATERPROOFING MATERIALS

- A.
- B. Synthetic Rubber Waterproofing: Cold-applied synthetic polymer complying with ASTM D3468; one or two component, quick setting.

1. Suitable for installation over concrete substrates.
2. Volatile Organic Compound content: < 75 g/L.
3. Elongation: 500 percent, measured in accordance with ASTM D 412.
4. Water Vapor Permeability: 0.08 perm inch, max., measured in accordance with ASTM E96/E96M.
5. Peel Adhesion to Concrete: 5 lb./inch, according to ASTM D 903 Modified.
6. Minimum Application Temperature: 20 deg. F.
7. Brittleness Temperature: minus 40 degrees F, measured in accordance with ASTM D746.

2.03 INSULATION

- A. Rigid Insulation: Specified in Section 07 21 00 Thermal Insulation.

2.04 ACCESSORIES

- A. Prefabricated Drainage Composite: Hydroduct 660 Drainage Composite by Grace Construction Products for horizontal surfaces **or approved equal [ADD 2]** Hydroduct 220 Drainage Composite by Grace Construction Products for all vertical surfaces **or approved equal.[ADD 2]** Drainage composite shall be designed to promote positive drainage while serving as a protection course.
- B. Miscellaneous Materials: Tape and other accessories specified or acceptable to manufacturer of fluid applied waterproofing membrane.

PART 3 EXECUTION

3.01 EXAMINATION

- A. The installer shall examine conditions of substrates and other conditions under which this work is to be performed and notify the contractor, in writing, of circumstances detrimental to the proper completion of the work. Do not proceed with work until unsatisfactory conditions are corrected.

3.02 PREPARATION OF SUBSTRATE

- A. Protect adjacent surfaces from damage not designated to receive waterproofing.
- B. Tie-holes and "bugholes" larger than 1/2 inch in diameter or deeper than 1/8 inch, or both, should be either pretreated per manufacturer's instructions or repaired with with a lean concrete mix or grout. See ASTM D 5295, Preparation of Concrete Surfaces for Adhered Membrane Waterproofing Systems, for further details on substrate preparation.
- C. Cracked, pitted, honeycombed or heavily bugholed surfaces can be filled by spraying from close in (10" to 12") but high material usage with result. Under these circumstances it may be more efficient to fill the surface with a parge coat of lean mortar mix before application of the waterproofing. It is also acceptable to fill in gaps with a compatible sealant or caulk.
- D. Cast-In-Place Concrete Substrates:
1. Surface shall be free of any visible water, frost, or ice.
 2. Fill form tie rod holes with concrete and finish flush with surrounding surface.
 3. Repair bugholes greater than 1/2 inch in depth and 1/4 inch in diameter deep and finish flush with surrounding surface.
 4. Remove scaling to sound, unaffected concrete and repair exposed area.
 5. Grind irregular construction joints to suitable flush surface.
- E. Masonry Substrates: Apply waterproofing over concrete block and brick with smooth trowel-cut mortar joints or parge coat.

3.03 INSTALLATION

- A. Apply waterproofing in accordance with manufacturer's instructions, including, but not limited to, the following:
1. Apply minimum 0.060 in. in all areas to be waterproofed. Apply minimum 0.120 inches in all detail areas.

2. If area to be waterproofed is in direct sunlight and temperature is rising, apply "scratch coat" (a thin application of fluid applied waterproofing) prior to the full application of the waterproofing membrane.
 3. In applications where a minimum slope of 0.13 in./ft cannot be achieved, a two coat application of membrane is recommended to achieve the total thickness.
 4. Apply protection board and related materials in accordance with manufacturer's recommendations.
 5. For vertical applications, install board insulation before installing drainage panels.
- B. Install flexible flashings and seal into waterproofing material. Seal items penetrating through membrane (i.e. water piping, electrical conduit, etc.) with flashings.
- C. Seal membrane and flashings to adjoining surfaces.

3.04 CLEANING AND PROTECTION

- A. Remove any masking materials after installation. Clean any stains on materials which would be exposed in the completed work.
- B. Protect completed membrane waterproofing from subsequent construction activities as recommended by manufacturer.
- C. Do not leave installed materials exposed to weather for longer than 30 days.

END OF SECTION

**SECTION 07 21 00
THERMAL INSULATION**

PART 1 GENERAL

1.01 SECTION INCLUDES

- A. Board insulation at cavity wall construction, perimeter foundation wall, underside of floor slabs, and exterior wall behind wall finish.

1.02 RELATED REQUIREMENTS

- A. Section 07 54 00 - PVC/KEE Thermoplastic Membrane Roofing: Installation requirements for board insulation over low slope roof deck specified in this section.

1.03 REFERENCE STANDARDS

- A. ASTM C553 - Standard Specification for Mineral Fiber Blanket Thermal Insulation for Commercial and Industrial Applications 2013 (Reapproved 2019).
- B. ASTM C578 - Standard Specification for Rigid, Cellular Polystyrene Thermal Insulation 2019.
- C. ASTM E84 - Standard Test Method for Surface Burning Characteristics of Building Materials 2021a.
- D. NFPA 285 - Standard Fire Test Method for Evaluation of Fire Propagation Characteristics of Exterior Wall Assemblies Containing Combustible Components 2019.

1.04 SUBMITTALS

- A. Product Data: Provide data on product characteristics, performance criteria, and product limitations.
- B. Manufacturer's Certificate: Certify that products meet or exceed specified requirements.
- C. Manufacturer's Installation Instructions: Include information on special environmental conditions required for installation and installation techniques.

1.05 QUALITY ASSURANCE

- A. Products provided under this section and installed at part of an exterior wall assembly shall have passed NFPA 285 testing as part of a wall assembly matching those detailed on drawings

PART 2 PRODUCTS

2.01 APPLICATIONS

- A. Insulation Under Concrete Slabs: Extruded polystyrene (XPS) board.
- B. Insulation at Perimeter of Foundation: Extruded polystyrene board.
- C. Insulation Inside Masonry Cavity Walls: Polyisocyanurate board.
- D. Insulation Behind Rainscreen Panels: Mineral wool fiberboard insulation.

2.02 FOAM BOARD INSULATION MATERIALS

- A. Extruded Polystyrene (XPS) Board Insulation: Complies with ASTM C578 with either natural skin or cut cell surfaces.
 - 1. Type: ASTM C578, Type IV.
 - 2. Flame Spread Index (FSI): Class A - 0 to 25, when tested in accordance with ASTM E84.
 - 3. Smoke Developed Index (SDI): 450 or less, when tested in accordance with ASTM E84.
 - 4. Type and Thermal Resistance, R-value: Type IV, 5.0 (0.88) per 1 inch thickness at 75 degrees F mean temperature.
 - 5. Complies with fire resistance requirements as part of an exterior non-load-bearing exterior wall assembly when tested in accordance with NFPA 285.
 - 6. Board Edges: Square.
 - 7. Type and Water Absorption: Type IV, 0.3 percent by volume, maximum, by total immersion.
 - 8. Manufacturers:

- a. Dow Chemical Company: www.dow.com/#sle.
 - b. Owens Corning Corporation: www.ocbuildingspec.com/sle.
 - c. **Atlas Energy Shield XR [ADD 3]**
- B. Foil Faced Polyisocyanurate Board Insulation: Rigid cellular foam, complying with ASTM C1289.
1. Classifications:
 - a. Type I: Faced with aluminum foil on both major surfaces of the core foam.
 - 1) Class 1 - Non-reinforced core foam.
 - 2) Thermal Resistance, R-value: At 1-1/2 inch thick; 9.0 at 75 degrees F.
 2. Board Thickness: As indicated on drawings.
 3. Board Edges: Square.
 4. Manufacturers:
 - a. Atlas Roofing Corporation; EnergyShield Pro Continuous Wall Insulation: www.atlasroofing.com/sle.
 - b. Hunter Panels, LLC; Xci Foil: www.hunterxci.com/sle.
 - c. Substitutions: See Section 01 25 00 - Substitution Procedures.

2.03 FIBERBOARD INSULATION MATERIALS

- A. Mineral Wool Fiberboard Insulation for Exterior Walls: Semi-rigid mineral fiber, ASTM C612 or ASTM C553; unfaced flame spread index of 0 (zero) when tested in accordance with ASTM E84, dark color.
1. Smoke Developed Index: 0 (zero), when tested in accordance with ASTM E84.
 2. Thickness: As indicated on drawings.
 3. Thermal Resistance: R-value of 4.2 degrees F hr sq ft/Btu per inch at 75 degrees F, minimum, when tested according to ASTM C518.
 4. Maximum Density: 6.0 pounds per cubic foot, nominal.
 5. Manufacturers:
 - a. Thermafiber, Inc; RainBarrier: www.thermafiber.com.
 - b. ROCKWOOL (ROXUL, Inc); CAVITYROCK: www.rockwool.com.
 - c. Substitutions: See Section 01 25 00 - Substitution Procedures.

2.04 ACCESSORIES

- A. Continuous Insulation (CI) Support Systems (Thermal Cips): Composite framing support (CFS) system consisting of girts that support CI and provide cladding attachment support integrated with exterior wall cladding.
1. Substrate: Attach CFS system components to exterior sheathing over metal stud framing.
 2. Depth of Girts: As required for thickness of insulation.
 3. Spacing of Girts: 16 inches on center, vertically.
 4. Approved Manufacturers:
 - a. Cascadia Windows LTD.: Cascadia Clip.
 - b. Advanced Architectural Products: SMARTci.
 - c. Northern Facades, ISO Clip.
 - d. Nvelope, Eko Thermobrackets.
 5. Insulation clip system design: Thermal spacer designed for cladding system attachment.
 6. Clip System, including support angles and final furring attachment, must be coordinated with each cladding system manufacturers.
 7. All fastener penetrations through air and vapor shall be fully sealed with compatible sealant where clip system is attached to substrate.
 8. No push pin installations allowed for insulation. Insulation to be retained without fasteners.
 9. Insulation to be installed in staggered layers with no gaps or voids.
 10. Transition between the insulation clip system and the cladding final attachment will occur within the staggered layers of the insulation. Attachment of the cladding to the insulation clip may not occur at the outside face of the final layer of insulation.

11. System to be designed to accommodate the following maximum live load deflection in the plane of the exterior wall:
 - a. Verify maximum live load deflection with structural requirements or 3/8 inch, whichever is greater.
 12. All components of support system from face of insulation to supports for wall panels shall be painted black.
 13. Products:
 - a. Advanced Architectural Products, LLC; SMARTci Plus 3-in-1 System: www.smartcisystems.com.
 - b. Cascadia Windows LTD; Cascadia Clip.
 - c. Northern Facades, ISO Clip.
 - d. Nvelope, Eko Thermobrace.
 - e. Substitutions: See Section 01 25 00 - Substitution Procedures.
- B. Adhesive: Type recommended by insulation manufacturer for application.

PART 3 EXECUTION

3.01 EXAMINATION

- A. Verify that substrate, adjacent materials, and insulation materials are dry and that substrates are ready to receive insulation.
- B. Verify substrate surfaces are flat, free of honeycomb, fins, irregularities, or materials or substances that may impede adhesive bond.

3.02 BOARD INSTALLATION AT FOUNDATION PERIMETER

- A. Apply adhesive to back of boards:
- B. Install boards horizontally on foundation perimeter.
 1. Install in running bond pattern.
 2. Butt edges and ends tightly to adjacent boards and to protrusions.
- C. Cut and fit insulation tightly to protrusions or interruptions to the insulation plane.

3.03 BOARD INSTALLATION AT CAVITY WALLS

- A. Secure impane fasteners to substrate at following frequency:
- B. Install boards to fit snugly between wall ties.
- C. Install boards horizontally on walls.
- D. Cut and fit insulation tightly to protrusions or interruptions to the insulation plane.
- E. Seal joints with foil tape.

3.04 BOARD INSTALLATION USING COMPOSITE FRAMING SUPPORT (CFS) SYSTEM

- A. Install CFS system in accordance with manufacturer's installation instructions.
- B. Install CFS system in compliance with system orientation, sizes, and locations as indicated on drawings.
- C. Install CFS system to fill-in exterior wall spaces without gaps or voids, and do not compress insulation boards.
- D. No push pin installations allowed for insulation. Insulation to be retained without fasteners.
- E. Insulation to be installed in staggered layers with no gaps or voids.
- F. Trim insulation neatly to fit spaces, and insulate miscellaneous gaps and voids with approved expandable foam sealant.
- G. Transition between the insulation clip system and the cladding final girt attachment will occur within the staggered layers of the insulation. Attachment of the cladding to the insulation clip may not occur at the outside face of the final layer of insulation.

3.05 BOARD INSTALLATION UNDER CONCRETE SLABS

- A. Place insulation under slabs on grade after base for slab has been compacted.
- B. Cut and fit insulation tightly to protrusions or interruptions to the insulation plane.
- C. Prevent insulation from being displaced or damaged while placing vapor retarder and placing slab.

3.06 PROTECTION

- A. Do not permit installed insulation to be damaged prior to its concealment.

END OF SECTION

**SECTION 07 25 00
WEATHER BARRIERS**

PART 1 GENERAL

1.01 SECTION INCLUDES

- A. Vapor Retarders: Materials to make exterior walls, joints between exterior walls and roof, and joints around frames of openings in exterior walls water vapor resistant and air tight.
- B. Air Barriers: Materials that form a system to stop passage of air through exterior walls, joints between exterior walls and roof, and joints around frames of openings in exterior walls.

1.02 DEFINITIONS

- A. Weather Barrier: Assemblies that form either water-resistive barriers, air barriers, or vapor retarders.
- B. Air Barrier: Air tight barrier made of material that is relatively air impermeable but water vapor permeable, both to the degree specified, with sealed seams and with sealed joints to adjacent surfaces. Note: For the purposes of this specification, vapor impermeable air barriers are classified as vapor retarders.
- C. Vapor Retarder: Air tight barrier made of material that is relatively water vapor impermeable, to the degree specified, with sealed seams and with sealed joints to adjacent surfaces.
 - 1. Water Vapor Permeance: For purposes of conversion, $57.2 \text{ ng}/(\text{Pa s sq m}) = 1 \text{ perm}$.

1.03 REFERENCE STANDARDS

- A. 40 CFR 59, Subpart D - National Volatile Organic Compound Emission Standards for Architectural Coatings; U.S. Environmental Protection Agency current edition.
- B. ASTM D1970/D1970M - Standard Specification for Self-Adhering Polymer Modified Bituminous Sheet Materials Used as Steep Roofing Underlayment for Ice Dam Protection 2021.
- C. ASTM E96/E96M - Standard Test Methods for Gravimetric Determination of Water Vapor Transmission Rate of Materials 2022.

1.04 PERFORMANCE REQUIREMENTS

- A. Air barrier shall be capable of performing as a continuous vapor-permeable air barrier and as a liquid-water drainage plane flashed to discharge to the exterior incidental condensation or water penetration. Air barrier assemblies shall be capable of accommodating substrate movement and of sealing substrate expansion and control joints, construction material changes, and transitions at perimeter conditions without deterioration and air leakage exceeding specified limits.
- B. Water barrier shall be capable of performing as a continuous non-vapor-permeable air and water barrier flashed to discharge to exterior condensation and water penetration. Water barrier membrane assemblies shall be capable of accommodatng substrate movement and of sealing substrate expansion and control joints, construction material changes, and transitions at perimeter conditions without deterioration and air leakage exceeding specified limits.

1.05 SUBMITTALS

- A. Product Data: Provide data on material characteristics.
- B. Shop Drawings: Provide drawings of special joint conditions.
 - 1. Include details of interface between air barriers and water barriers.
- C. Manufacturer's Installation Instructions: Indicate preparation and installation methods.
- D. Compatibility Certification: Provide certification of compatibility of all products to be provided in this section and adjacent products that are part of the building envelope system.
- E. Testing agency reports.

1.06 QUALITY ASSURANCE

- A. Provide products for all components specified in the section from the same manufacturer, or provide certification of compatibility of all products not provided by same manufacturer.
- B. Products provided under this section and installed at part of an exterior wall assembly shall have passed NFPA 285 testing as part of a wall assembly matching those detailed on drawings

1.07 MOCK-UP

- A. Mockups: Before beginning installation of air/moisture barrier, build mockups of exterior wall assembly, 150 sq. ft., incorporating backup wall construction, external cladding, window, door frame and sill, insulation, and flashing to demonstrate surface preparation, crack and joint treatment, and sealing of gaps, terminations, and penetrations of air barrier membrane.
 - 1. Coordinate construction of mockup to permit inspection by Owner's testing agency of air barrier before external insulation and cladding is installed.
 - 2. Include junction with roofing membrane, building corner condition, and foundation wall intersection.
 - 3. If Architect determines mockups do not comply with requirements, reconstruct mockups and apply air barrier until mockups are approved.
 - 4. Approved mockups may become part of the completed Work if undisturbed at time of Substantial Completion.

1.08 FIELD CONDITIONS

- A. Maintain temperature and humidity recommended by the materials manufacturers before, during and after installation.

1.09 DELIVERY, STORAGE AND HANDLING

- A. Store liquid materials in their original undamaged packages in a clean, dry, protected location and within temperature range required by manufacturer.
- B. Remove and replace liquid materials that cannot be applied within their stated shelf life.
- C. Store rolls according to manufacturer's written instructions.
- D. Protect stored materials from direct sunlight.

1.10 PROJECT CONDITIONS

- A. Environmental Limitations: Apply weather barriers within the range of ambient and substrate temperatures recommended by weather barrier manufacturers. Protect substrates from environmental conditions that affect performance of weather barriers. Do not apply weather barriers to a damp or wet substrate or during snow, rain, fog, or mist.

PART 2 PRODUCTS

2.01 VAPOR PERMEABLE AIR BARRIER

- A. Vapor Permeable Air Barrier, Fluid Applied: Vapor permeable, elastomeric waterproofing.
 - 1. Air Barrier Membrane:
 - a. Air Permeance: 0.004 cubic feet per minute per square foot, maximum, when tested in accordance with ASTM E2178.
 - b. Water Vapor Permeance: 5 perms, minimum, when tested in accordance with ASTM E96/E96M, Procedure B.
 - c. Elongation: 300 percent, minimum, when tested in accordance with ASTM D412.
 - d. Sealants, Tapes and Accessories: As recommended by coating manufacturer.
 - e. Manufacturers:
 - 1) Carlisle Coatings and Waterproofing, Inc; Fire Resist Barritech-VP: www.carlisleccw.com/#sle.
 - 2) GCP Applied Technologies; Perm-A-Barrier VPL: www.gcpat.com/#sle.
 - 3) Henry Company; Air-Bloc 33MR: www.henry.com/#sle.
 - 4) TK Products, AirMax 2104 VP: www.tkproducts.com.
 - 5) Tremco Commercial Sealants & Waterproofing; ExoAir 230: www.tremcosealants.com.

6) **Sopraseal LM 202 VP [ADD 2]**

2.02 NON-PERMEABLE AIR AND WATER BARRIER (VAPOR RETARDER)

- A. Non-Permeable Air and Water Barrier Sheet: ASTM D1970/D1970M.
 - 1. Type: Rubberized asphalt bonded to thermoplastic sheet, self-adhesive.
 - 2. Thickness: 40 mil, 0.040 inch, nominal.
 - 3. Water Vapor Permeance: 0.05 perm, maximum, when tested in accordance with ASTM E96/E96M.
 - 4. Seam and Perimeter Tape: As recommended by sheet manufacturer.
 - 5. Manufacturers:
 - a. Carlisle Coatings and Waterproofing, Inc; CCW-705 Air and Vapor Barrier Sheet: www.carlisleccw.com/#sle.
 - b. GPC Applied Technologies (Grace), Perm-A-Barrier.
 - c. Henry Company; Blueskin SA: www.henry.com/#sle.
 - d. Tremco Sealants and Waterproofing; ExoAir 110AT.
 - e. **Soprema Sopraseal Stick 1100T [ADD 3]**
- B. Non-Permeable Air and Water Barrier Coating (Water Barrier Membrane): Liquid applied, resilient, UV-resistant coating and associated joint treatment.
 - 1. Water Vapor Permeance: Between 0.02 and 0.09 perm, when tested in accordance with ASTM E96/E96M.
 - 2. VOC Content: Less than 50 g per L when tested in accordance with 40 CFR 59, Subpart D (EPA Method 24).
 - 3. Suitable for use on concrete, masonry, plywood and gypsum sheathing.
 - 4. Joint Preparation Treatment: Coating manufacturer's recommended method, either tape or reinforcing mesh saturated with coating material.
 - 5. Basis-of-Design:
 - a. GPC Applied Technologies (Grace), Perm-A-Barrier Liquid.
 - b. Other Acceptable Products:
 - 1) Carlisle Coatings and Waterproofing, Inc; Barriseal: www.carlisleccw.com/#sle.
 - 2) Henry Company; Air-Bloc 32 MR: www.henry.com/#sle.
 - 3) TK Products, AirMax 2102 VOC; www.tkproducts.com.
 - 4) Tremco Sealants and Waterproofing, ExoAir 120 Fluid-applied Air and Vapor Retarder membrane; www.tremcosealants.com.
 - 5) **Soprema Sopraseal LM 203 [ADD 3]**
 - 6) Substitutions: See Section 01 25 00 - Substitution Procedures.
 - 6. Joint Filler: As recommended by coating manufacturer and suitable to the substrate.

2.03 ACCESSORIES

- A. Transition Membrane: A 40 mil self-adhering waterproofing used for flashing around beams, columns, and wall openings (including window, door and curtain wall frames, louvers, etc.); consisting of 36 mils of rubberized asphalt, integrally bonded to a 4 mil high-density cross-laminated polyethylene film. Membrane shall be interleaved with disposable silicone-coated release paper until installed. Fully-supported self-adhered membranes must be provided at all corners, (inside and outside), transitions, and changes in substrate. Liquid applied membranes that utilize mesh reinforcements will not be allowed.
 - 1. Basis-of-Design Product: GCP Applied Technologies (Grace) Perm-A-Barrier Detail Membrane.
 - 2. Other Acceptable Manufacturers:
 - a. Henry Corporation
 - b. Carlisle Coatings & Waterproofing
 - c. Tremco.
 - d. TK Products.

- B. Flexible Membrane Through-Wall Flashing: Self-adhesive sheet flashing complying with ASTM D1970/D1970M, except slip resistance requirement is waived if not installed on a roof.
 - 1. Thickness: 40 mil (32 mil rubberized asphalt laminated to 8 mil high-density polyethylene film)
 - 2. Basis-of-Design Product: GCP Applied Technologies (Grace) Perm-A-Barrier Wall Flashing.
 - 3. Other Acceptable Manufacturers:
 - a. Henry Corporation.
 - b. Carlisle Coatings & Waterproofing.
 - c. TK Products.
 - d. Tremco Sealants and Waterproofing.
- C. Detailing Compound: Two-part, elastomeric, trowel grade material for use with self-adhered membranes and tapes.
 - 1. Basis-of-Design Product: GCP Applied Technologies (Grace) Bituthene Liquid Membrane.
 - 2. Other Acceptable Manufacturers:
 - a. Henry Corporation.
 - b. Carlisle Coatings & Waterproofings.
 - c. TK Products.
 - d. Tremco Sealants and Waterproofing.
- D. Metal Drip Edge: Provide metal drip edge where flashing is exposed or partially exposed and where indicated, complying with Division 7 Section "Sheet Metal Flashing and Trim" and as follows:
 - 1. Stainless Steel: ASTM A 240/A 240M, Type 304, 0.016 inch thick.
 - a. Metal Drip Edges: Fabricate from stainless steel. Extend into wall and 1/2 inch out from wall, with outer edge bent down 30 degrees and hemmed.
 - 2. Basis-of-Design Product: Hohmann & Barnard 26 gage minimum, 1-1/2" minimum, stainless steel hemmed drip plate.
- E. Miscellaneous Materials: Tape and other accessories specified or acceptable to manufacturer of fluid-applied air and vapor barrier membrane.

PART 3 EXECUTION

3.01 EXAMINATION

- A. Verify that surfaces and conditions are ready to accept the work of this section.
- B. The installer shall examine conditions of substrates and other conditions under which this work is to be performed and notify the Contractor, in writing, of circumstances detrimental to the proper completion of the work. Do not proceed with work until unsatisfactory conditions are corrected
- C. Verify that items built-in under other sections are properly located, sized, and securely installed.

3.02 PREPARATION

- A. Protect adjacent work areas and finish surfaces from damage during installation.
- B. Refer to manufacturer's literature for requirements for preparation of substrates. Surfaces shall be structurally sound and free of voids, spalled areas, loose aggregate and sharp protrusions. Remove contaminants such as grease, oil and wax from exposed surfaces. Remove dust, dirt, loose stone and debris. Use repair materials and methods which are acceptable to manufacturer of fluid-applied air and vapor barrier.
- C. Cast-In-Place Concrete Substrates:
 - 1. Surface shall be free of any visible water, frost, or ice.
 - 2. Fill form tie rod holes with concrete and finish flush with surrounding surface.
 - 3. Repair bug holes greater than 1/2 inch in diameter and 1/4 inch deep, and finish flush with surrounding surface.

4. Remove scaling to sound, unaffected concrete, and repair exposed area.
5. Grind irregular construction joints and protrusions taller than 1/8" to suitable flush surface.
- D. Exterior Sheathing Panels: Ensure that the boards are sufficiently stabilized with corners and edges fastened with appropriate screws. Pre-treat all board joints with 2 to 3 inch wide, reinforced self-adhesive tape, or fiberglass mesh-style gypsum board tape. Fill gaps greater than 1/4 inch with mastic or caulk, allowing sufficient time for full curing before application of tape and fluid-applied membrane
- E. Masonry Substrates: Apply air and vapor barrier over concrete block with smooth flush mortar joints. Fill all voids and holes, particularly in the mortar joints, with a lean mortar mix, non-shrinking grout or parge coat.
- F. Related Materials: Treat joints and install flashing as recommended by membrane manufacturer.

3.03 INSTALLATION

- A. Install materials in accordance with manufacturer's instructions.
- B. Air Barriers: Install continuous air tight barrier over surfaces indicated, with sealed seams and with sealed joints to adjacent surfaces.
- C. Vapor Retarders: Install continuous air tight barrier over surfaces indicated, with sealed seams and with sealed joints to adjacent surfaces.
- D. Application of Fluid-Applied Membrane:
 1. Spray- or trowel-apply a continuous uniform film at minimum 60 mils dry film thickness using multiple, overlapping passes.
 2. When spraying, use a cross-hatching technique (alternating horizontal and vertical passes) to ensure even thickness and coverage.
 3. When spraying, use high pressure, multi-component, airless spray equipment approved by material manufacturer.
 4. Carry membrane into any openings a minimum of 2 inches.
 5. Seal all brick-ties and other penetrations as work progresses.
- E. Application of Transition Membrane:
 1. After allowing the fluid-applied membrane to cure to tack-free finish, apply transition membrane with a minimum overlap of 3 inches onto each surface at all beams, columns and joints as indicated on Drawings.
 2. Tie-in to window and door frames, spandrel panels, roof and floor intersections and changes in substrate.
 - a. Install products in accordance to manufacturer's installation instructions, necessary to provide a continuous weather barrier for all transitions in plane.
 3. Use pre-cut, easily-handled lengths for each location.
 4. Remove silicone-coated release paper and position membrane flashing carefully before placing it against the surface.
 5. When properly positioned, place against surface by pressing firmly into place using hand roller.
 6. Overlap adjacent pieces 2 inches, and roll all seams with a hand roller.
 7. Seal top edge of flashing with sealant compatible with all surrounding materials.
 8. Transition flashing is not to be pre-installed prior to application of fluid-applied membrane, apply transition flashing as above. Spray or trowel a continuous uniform film of Fluid-Applied Membrane at minimum 60 mils dry film thickness using multiple, overlapping passes, with a minimum overlap of 3 inches between the fluid applied and the transition flashing
- F. Application of Flexible Membrane Wall Flashing:
 1. Precut pieces of flashing to easily handled lengths for each location.
 2. Remove silicone-coated release paper and position flashing carefully before placing it against the surface.

3. When properly positioned, place against surface by pressing firmly into place using hand roller. Fully-adhere flashing to substrate to prevent water from migrating under flashing.
 4. Overlap adjacent pieces 2 inches and roll all seams with a hand roller.
 5. Trim bottom edge 1/2 inch back from exposed face of the wall. Flashing shall not be permanently exposed to sunlight.
 6. At heads, sills and all flashing terminations, turn up flashing ends a minimum of 2 inches, and make careful folds to form an end dam, with the seams sealed.
 7. Seal top edge of flashing with sealant compatible with all surrounding materials.
 8. Do not allow the rubberized-asphalt surface of the flashing membrane to come in contact with poly- sulfide sealants, creosote, uncured coal tar products, or ethylene-propylene-diene-terpolymer products (EPDM).
- G. Installation of the primary membrane is to occur prior to all inside and outside corners, fenestration rough openings and penetrations, then install the initial application of detail membrane.

3.04 TOLERANCES

- A. System to be installed to accommodate the following maximum live load deflection in the plane of the exterior wall:
1. Verify maximum live load deflection with structural requirements or 3/8 inch, whichever is greater.

3.05 CLEANING AND PROTECTION

- A. Remove any masking materials after installation. Clean any stains on materials which would be exposed in the completed work using procedures as recommended by manufacturer.
- B. Fluid-applied air and vapor barrier membrane is not suitable for permanent exposure and should be protected from the effects of sunlight.
- C. Schedule work to ensure that the membrane system is covered as soon as possible after installation. Protect membrane system from damage during subsequent operations. If the air and vapor barrier membrane system cannot be covered within sixty (60) days after installation, apply temporary UV protection such as dark plastic sheet or tarpaulins.

3.06 FIELD QUALITY CONTROL

- A. Do not cover installed fluid-applied air and vapor barrier until required inspections have been completed by testing agency.
- B. Testing Agency: Owner will engage a qualified testing agency to perform tests and inspections and prepare test reports.
- C. The testing agency shall verify proper application thickness via a wet mil gauge during the application process.
- D. Testing agency shall perform "Bubble Gun" testing in accordance ASTM E1186 at no less than six (6) areas, or visual inspections at Owner/Architect's discretion.

3.07 PROTECTION

- A. Do not leave materials exposed to weather longer than recommended by manufacturer.

END OF SECTION

**SECTION 09 21 16
GYPSUM BOARD ASSEMBLIES**

PART 1 GENERAL

1.01 SECTION INCLUDES

- A. Performance criteria for gypsum board assemblies.
- B. Metal stud wall framing.
- C. Metal channel ceiling framing.
- D. Acoustic insulation.
- E. Cementitious backing board.
- F. Gypsum wallboard.
- G. Joint treatment and accessories.

1.02 RELATED REQUIREMENTS

- A. Section 06 10 00 - Rough Carpentry: Wood blocking product and execution requirements.

1.03 REFERENCE STANDARDS

- A. AISI S100 - North American Specification for the Design of Cold-Formed Steel Structural Members 2016, with Supplement (2018).
- B. ANSI A108.11 - American National Standard Specifications for Interior Installation of Cementitious Backer Units 2018.
- C. ANSI A118.9 - American National Standard Specifications for Test Methods and Specifications for Cementitious Backer Units 2019.
- D. ASTM A653/A653M - Standard Specification for Steel Sheet, Zinc-Coated (Galvanized) or Zinc-Iron Alloy-Coated (Galvannealed) by the Hot-Dip Process 2020.
- E. ASTM C475/C475M - Standard Specification for Joint Compound and Joint Tape for Finishing Gypsum Board 2017.
- F. ASTM C645 - Standard Specification for Nonstructural Steel Framing Members 2018.
- G. ASTM C754 - Standard Specification for Installation of Steel Framing Members to Receive Screw-Attached Gypsum Panel Products 2020.
- H. ASTM C840 - Standard Specification for Application and Finishing of Gypsum Board 2020.
- I. ASTM C954 - Standard Specification for Steel Drill Screws for the Application of Gypsum Panel Products or Metal Plaster Bases to Steel Studs From 0.033 in. (0.84 mm) to 0.112 in. (2.84 mm) in Thickness 2018.
- J. ASTM C1002 - Standard Specification for Steel Self-Piercing Tapping Screws for Application of Gypsum Panel Products or Metal Plaster Bases to Wood Studs or Steel Studs 2020.
- K. ASTM C1047 - Standard Specification for Accessories for Gypsum Wallboard and Gypsum Veneer Base 2019.
- L. ASTM C1278/C1278M - Standard Specification for Fiber-Reinforced Gypsum Panel 2017.
- M. ASTM C1288 - Standard Specification for Fiber-Cement Interior Substrate Sheets 2017.
- N. ASTM C1325 - Standard Specification for Fiber-Mat Reinforced Cementitious Backer Units 2021.
- O. ASTM C1396/C1396M - Standard Specification for Gypsum Board 2017.
- P. ASTM D3273 - Standard Test Method for Resistance to Growth of Mold on the Surface of Interior Coatings in an Environmental Chamber 2021.
- Q. ASTM E90 - Standard Test Method for Laboratory Measurement of Airborne Sound Transmission Loss of Building Partitions and Elements 2009 (Reapproved 2016).

- R. ASTM E413 - Classification for Rating Sound Insulation 2022.
- S. GA-216 - Application and Finishing of Gypsum Panel Products 2021.
- T. UL (FRD) - Fire Resistance Directory Current Edition.

1.04 SUBMITTALS

- A. Control Joint Drawing: Provide drawings showing location of control joints in gypsum board assemblies.
- B. Product Data: Provide data on metal framing, gypsum board, accessories, and joint finishing system.
- C. Product Data: Provide manufacturer's data on partition head to structure connectors, showing compliance with requirements.

PART 2 PRODUCTS

2.01 GYPSUM BOARD ASSEMBLIES

- A. Provide completed assemblies complying with ASTM C840 and GA-216.
- B. Interior Partitions: Provide completed assemblies with the following characteristics:
 - 1. Acoustic Attenuation: STC of 45-49 calculated in accordance with ASTM E413, based on tests conducted in accordance with ASTM E90.
- C. Fire Rated Assemblies: Provide completed assemblies complying with applicable code.
 - 1. UL Assembly Numbers: Provide construction equivalent to that listed for the particular assembly in the current UL (FRD).

2.02 METAL FRAMING MATERIALS

- A. Non-Loadbearing Framing System Components: ASTM C645; galvanized sheet steel, of size and properties necessary, but no less than 20 gauge (0.296") non-load bearing studs, to comply with ASTM C754 for the spacing indicated, with maximum deflection of wall framing of L/240 at 5 psf.
 - 1. At Wall Locations with tile backer and tile, and at wall heights over 16 feet: maximum, wall deflection shall be L/360 at 5 psf. Use no less than 20 gauge (0.033") structural studs, ANSI 108.11.
 - 2. Studs: "C" shaped with flat or formed webs.
 - 3. Runners: U shaped, sized to match studs.
 - 4. Ceiling Channels: C-shaped.
 - 5. Channel Bridging and Bracing: Pre-notched steel, 7/8 by 7/8 by 50 inches, 0.0329-inch minimum base-steel thickness. Provide in the following locations, as applicable:
 - a. Between stud punchouts (at 24" o.c. minimum) in framing for walls to be filled with foamed-in-place insulation.
 - b. In non-composite walls in excess of 60 inches (i.e. walls with gypsum board on only one side or walls with gypsum board on neither side (ex. above ceiling areas) at 24" maximum from horizontal tracks, and at 48" o.c. minimum.
- B. Grid Suspension System for Gypsum Board Ceiling: ASTM C 645, direct-hung system composed of main beams and cross-furring members that interlock.
 - 1. Products: Subject to compliance with requirements, provide one of the following:
 - a. Armstrong World Industries, Inc.; Drywall Grid Systems.
 - b. Chicago Metallic Corporation; Drywall Grid System.
 - c. USG Corporation; Drywall Suspension System.
- C. Partition Head to Structure Connections: Provide mechanical anchorage devices that accommodate deflection using slotted holes, screws, and anti-friction bushings, preventing rotation of studs while maintaining structural performance of partition.
 - 1. Structural Performance: Maintain lateral load resistance and vertical movement capacity required by applicable code, when evaluated in accordance with AISI S100.

2. Material: ASTM A653/A653M steel sheet, SS Grade 50/340, with G60/Z180 hot-dipped galvanized coating.
3. Provide components UL-listed for use in UL-listed fire-rated head of partition joint systems of fire rating and movement required.
- D. Top of Wall Firestop: Use one of the following:
 1. Deflection and Firestop Track: Intumescent strip factory-applied to track flanges expands when exposed to heat or flames to provide a perimeter joint seal.
 - a. Products:
 - 1) ClarkDietrich Building Systems; BlazeFrame Firestop Deflection Track: www.clarkdietrich.com.
 2. Preformed Top Track Firestop Seal:
 - a. Provide components UL-listed for use in UL-listed fire-resistance-rated head of partition joint systems indicated on drawings.
 - b. Products:
 - 1) Hilti, Inc; Top Track Seal CFS TTS: www.us.hilti.com.
- E. Flat Sheet Blocking: Framing system manufacturer's steel sheet backing plates for use as backer plates to support shelves, cabinets, fixtures, handrails, etc. 20 gauge minimum. Length and width as required for items being supported.

2.03 BOARD MATERIALS

- A. Manufacturers - Gypsum-Based Board:
 1. CertainTeed Corporation: www.certainteed.com.
 2. Georgia-Pacific Gypsum: www.gpgypsum.com.
 3. National Gypsum Company: www.nationalgypsum.com.
 4. USG Corporation: www.usg.com.
- B. Gypsum Wallboard: Paper-faced gypsum panels as defined in ASTM C1396/C1396M; sizes to minimize joints in place; ends square cut.
 1. Application: Use for vertical surfaces and ceilings, unless otherwise indicated.
 2. Unfaced fiber-reinforced gypsum panels as defined in ASTM C1278/C1278M, suitable for paint finish, of the same core type and thickness may be substituted for paper-faced board.
 3. Mold Resistance: Score of 10, when tested in accordance with ASTM D3273.
 - a. Provide mold resistant type on walls and ceilings in toilet rooms, janitor closets and other locations as indicated on drawings.
 4. At Assemblies Indicated with Fire-Resistance Rating: Use type required by indicated tested assembly; if no tested assembly is indicated, use Type X board, UL or WH listed.
 5. Thickness:
 - a. Vertical Surfaces: 5/8 inch.
 - b. Multi-Layer Assemblies: Thicknesses as indicated on drawings.
- C. Backing Board For Tiled Areas:
 1. Application: Surfaces behind tile locations.
 2. ANSI Cement-Based Board: Non-gypsum-based; aggregated Portland cement panels with glass fiber mesh embedded in front and back surfaces complying with ANSI A118.9 or ASTM C1325.
 - a. Thickness: 1/2 inch.
 3. ASTM Cement-Based Board: Non-gypsum-based, cementitious board complying with ASTM C1288.
 - a. Thickness: 1/2 inch.
 - b. Products:
 - 1) James Hardie Building Products, Inc: www.jameshardie.com.
 - 2) National Gypsum Company; PermaBase Brand Cement Board.
 - 3) USG Corporation; Durock Brand Cement Board.

2.04 GYPSUM WALLBOARD ACCESSORIES

- A. Acoustic Insulation: ASTM C665; preformed glass fiber, friction fit type, unfaced. Thickness: As required to fill stud cavity.
- B. Acoustic Sealant: Acrylic emulsion latex or water-based elastomeric sealant; do not use solvent-based non-curing butyl sealant.
 - 1. Acceptable Products:
 - a. Pecora Corporation; AC-20 FTR Acoustical and Insulation Sealant.
 - b. United States Gypsum Co.; SHEETROCK Acoustical Sealant.
 - 2. Clean joints, and prime as necessary, in accordance with manufacturer's instructions.
 - 3. Applications:
 - a. Both faces of interior gypsum board partitions at perimeter relief joints and through penetrations.
 - b. As required for acoustical-rated constructions.
 - c. As required for gypsum board shaft-wall assemblies.
- C. Finishing Accessories: ASTM C1047, extruded aluminum alloy (6063 T5) or galvanized steel sheet ASTM A924/A924M G90, unless noted otherwise.
 - 1. Types: As detailed or required for finished appearance.
 - 2. Special Shapes: In addition to conventional corner bead and control joints, provide U-bead at exposed panel edges.
- D. EJ-2 - Aluminum Expansion Joints: Three piece, extruded aluminum. Reveal widths as indicated on drawings.
 - 1. Finish: Clear anodized.
 - 2. Basis-of-Design: Fry Reglet, Drywall Expansion Joint DRM-50.
- E. High Abuse Corner Bead: Fry Reglet, DMCT-1250 **with chem film finish**. Provide **full height** at locations indicated on drawings. **[ADD 3]**
- F. Aluminum Reveal Trim: Extruded accessories of profiles and dimensions indicated.
 - 1. Acceptable Manufacturers:
 - a. Fry Reglet.
 - b. Gordon, Inc.
 - c. Pittcon Industries.
 - 2. Aluminum: Alloy and temper with not less than the strength and durability properties of ASTM B 221, Alloy 6063-T5.
 - 3. Finish: Corrosion-resistant primer compatible with joint compound and finish materials specified.
- G. Joint Materials: ASTM C475/C475M and as recommended by gypsum board manufacturer for project conditions.
 - 1. Tape: 2 inch wide, creased paper tape for joints and corners.
- H. Joint Compound for Interior Gypsum Wallboard: For each coat use formulation that is compatible with other compounds applied on previous or for successive coats.
 - 1. Prefilling: At open joints and damaged surface areas, use setting-type taping compound.
 - 2. Embedding and First Coat: For embedding tape and first coat on joints, fasteners, and trim flanges, use setting-type taping compound.
 - 3. Fill Coat: For second coat, use setting-type, sandable topping compound.
 - 4. Finish Coat: For third coat, use drying-type, all-purpose compound.
- I. Screws for Fastening of Gypsum Panel Products to Cold-Formed Steel Studs Less than 0.033 inches in Thickness and Wood Members: ASTM C1002; self-piercing tapping screws, corrosion-resistant.
- J. Screws for Fastening of Gypsum Panel Products to Steel Members from 0.033 to 0.112 inch in Thickness: ASTM C954; steel drill screws, corrosion-resistant.
- K. Mullion Closures: Spring loaded, extruded aluminum partition gap closures.

1. Material: Aluminum extrusions, 6063-T5 or T6 temper, tensile strength 31 KSI.
2. Finish: Anodized to match color of storefront/curtain wall framing.
3. Provide acoustic insulation within mullion closure.
4. Basis-of-Design: Gordon, Inc., Mullion Mate Series 40 Partition Closures.
 - a. Substitutions: See Section 01 25 00 - Substitution Procedures.

PART 3 EXECUTION

3.01 EXAMINATION

- A. Verify that project conditions are appropriate for work of this section to commence.
- B. Do not begin installation of gypsum board panels until building is fully enclosed.

3.02 FRAMING INSTALLATION

- A. Metal Framing: Install in accordance with ASTM C754 and manufacturer's instructions.
- B. Suspended Ceilings and Soffits: Space framing and furring members as indicated.
 1. Level ceiling system to a tolerance of 1/1200.
 2. Laterally brace entire suspension system.
- C. Studs: Space studs at 16 inches on center unless otherwise indicated.
 1. Extend partition framing to structure where indicated and to ceiling in other locations.
 2. Partitions Terminating at Ceiling: Attach ceiling runner securely to ceiling track in accordance with manufacturer's instructions.
 3. Partitions Terminating at Structure: Attach top runner to structure, maintain clearance between top of studs and structure, and connect studs to track using specified mechanical devices in accordance with manufacturer's instructions; verify free movement of top of stud connections; do not leave studs unattached to track.
- D. Openings: Reinforce openings as required for weight of doors or operable panels, using not less than double studs at jambs.
- E. Blocking: Install wood blocking as specified in Division 6 Section "Rough Carpentry".

3.03 ACOUSTIC ACCESSORIES INSTALLATION

- A. Acoustic Insulation: Place tightly within spaces, around cut openings, behind and around electrical and mechanical items within partitions, and tight to items passing through partitions.
- B. Acoustic Sealant: Install in accordance with manufacturer's instructions.
 1. Place continuous bead at perimeter of each layer of gypsum board.

3.04 BOARD INSTALLATION

- A. Comply with ASTM C840, GA-216, and manufacturer's instructions. Install to minimize butt end joints, especially in highly visible locations.
- B. Single-Layer Nonrated: Install gypsum board in most economical direction, with ends and edges occurring over firm bearing.
- C. Double-Layer Non-Rated: Use gypsum board for first layer, placed parallel to framing or furring members, with ends and edges occurring over firm bearing. Place second layer perpendicular to framing or furring members. Offset joints of second layer from joints of first layer.
- D. Install panels with face side out. Butt panels together for a light contact as edges and ends with not more than 1/16 inch of open space between panels. Do not force into place.
- E. Cover both faces of support framing with gypsum in concealed spaces (above ceilings, etc.), except in chases braced internally.
 1. Unless concealed application is indicated or required for sound, fire, air, or smoke ratings, coverage may be accomplished with scraps of not less than 8 sq. ft. in area.
 2. Fit gypsum panels around ducts, pipes, and conduits.
 3. Where partitions intersect structural members projecting below underside of floor/roof slabs and decks, cut gypsum panels to fit profile formed by structural members; allow 1/4- to 3/8-inch-wide joints to install sealant.

- F. Attachment to Steel Framing: Attach panels so leading edge or end of each panel is attached to open (unsupported) edges of stud flanges first.
- G. Install sound attenuation blankets before installing gypsum panels. Seal joints between edges and abutting structural surfaces with acoustical sealant.
- H. Form control and expansion joints with space between edges of adjoining gypsum panels.
- I. Cementitious Backing Board: Install over steel framing members where indicated, in accordance with ANSI A108.11 and manufacturer's instructions.
 - 1. Where tile backing panels abut other types of panels in the same plane, shim surface.
- J. Installation on Metal Framing: Use screws for attachment of gypsum board.

3.05 INSTALLATION OF TRIM AND ACCESSORIES

- A. Control Joints: Place control joints consistent with lines of building spaces and as follows:
 - 1. In accordance with ASTM C 840 and GA-216.
 - 2. Not more than 30 feet apart on walls and ceilings over 50 feet long.
 - 3. Provide control joints at transitions between differing types of substrate supports (example: between stud framing supports and furring strips on masonry wall).
- B. Corner Beads: Install at external corners, using longest practical lengths.
- C. Edge Trim: Install at locations where gypsum board abuts dissimilar materials.

3.06 JOINT TREATMENT

- A. Joint Compound for Interior Gypsum Wallboard: For each coat use formulation that is compatible with other compounds applied on previous or for successive coats.
 - 1. Prefilling: At open joints and damaged surface areas, use setting-type taping compound.
 - 2. Embedding and First Coat: For embedding tape and first coat on joints, fasteners, and trim flanges, use setting-type taping compound.
 - 3. Fill Coat: For second coat, use setting-type, sandable topping compound.
 - 4. Finish Coat: For third coat, use drying-type, all-purpose compound.
 - 5. Skim Coat: For final coat of Level 5 finish, use drying-type, all-purpose compound.
- B. Finish gypsum board in accordance with levels defined in ASTM C840, as follows:
 - 1. Level 4: Walls and ceilings to receive paint finish or wall coverings, unless otherwise indicated.
 - 2. Level 1: Wall areas above finished ceilings, whether or not accessible in the completed construction.
 - 3. At fire-rated wall areas above finished ceilings, provide minimum finish levels as required by fire-rated assembly.
- C. Tape, fill, and sand exposed joints, edges, and corners to produce smooth surface ready to receive finishes.
 - 1. Feather coats of joint compound so that camber is maximum 1/32 inch.
- D. Fill and finish joints and corners of cementitious backing board as recommended by manufacturer.

3.07 PROTECTION


- A. Protect installed products from damage from weater, condensation, direct sunlight, construction, and other causes during remainder of the construction period.
- B. Remove and replace panels that are wet, moisture damaged, and mold damaged.
 - 1. Indications that panels are wet or moisture damaged include, but are not limited to discoloration, sagging, or irregular shape.
 - 2. Indications that panels are mold damaged include, but are not limited to, fuzzy or splotchy surface contamination and discoloration.

3.08 TOLERANCES


- A. Maximum Variation of Finished Gypsum Board Surface from True Flatness: 1/8 inch in 10 feet in any direction.

END OF SECTION

This page intentionally left blank

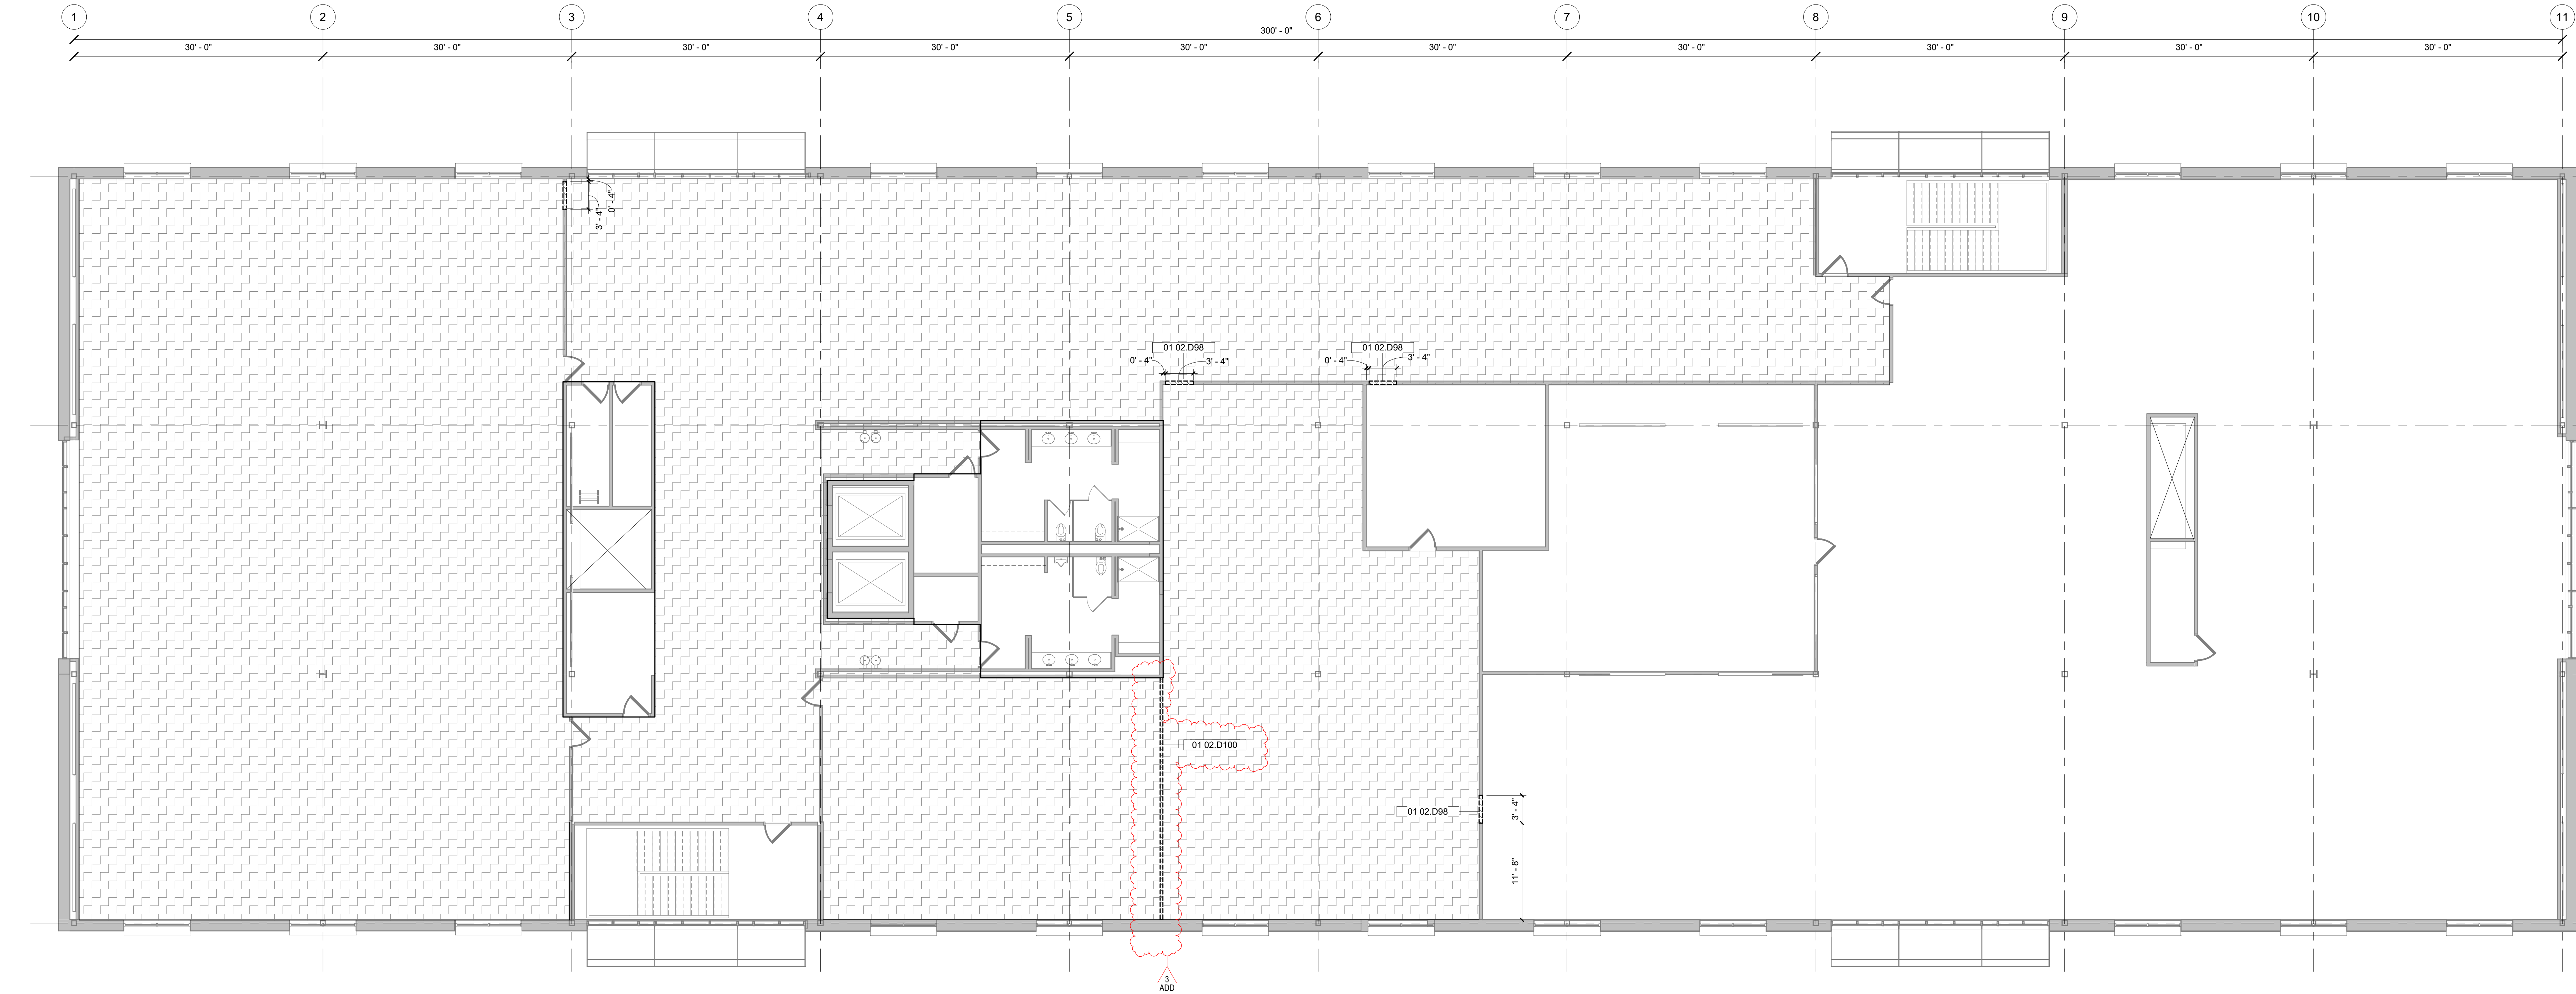

1 HHS DEMO - LEVEL 3 FLOORPLAN
1/8" = 1'-0"

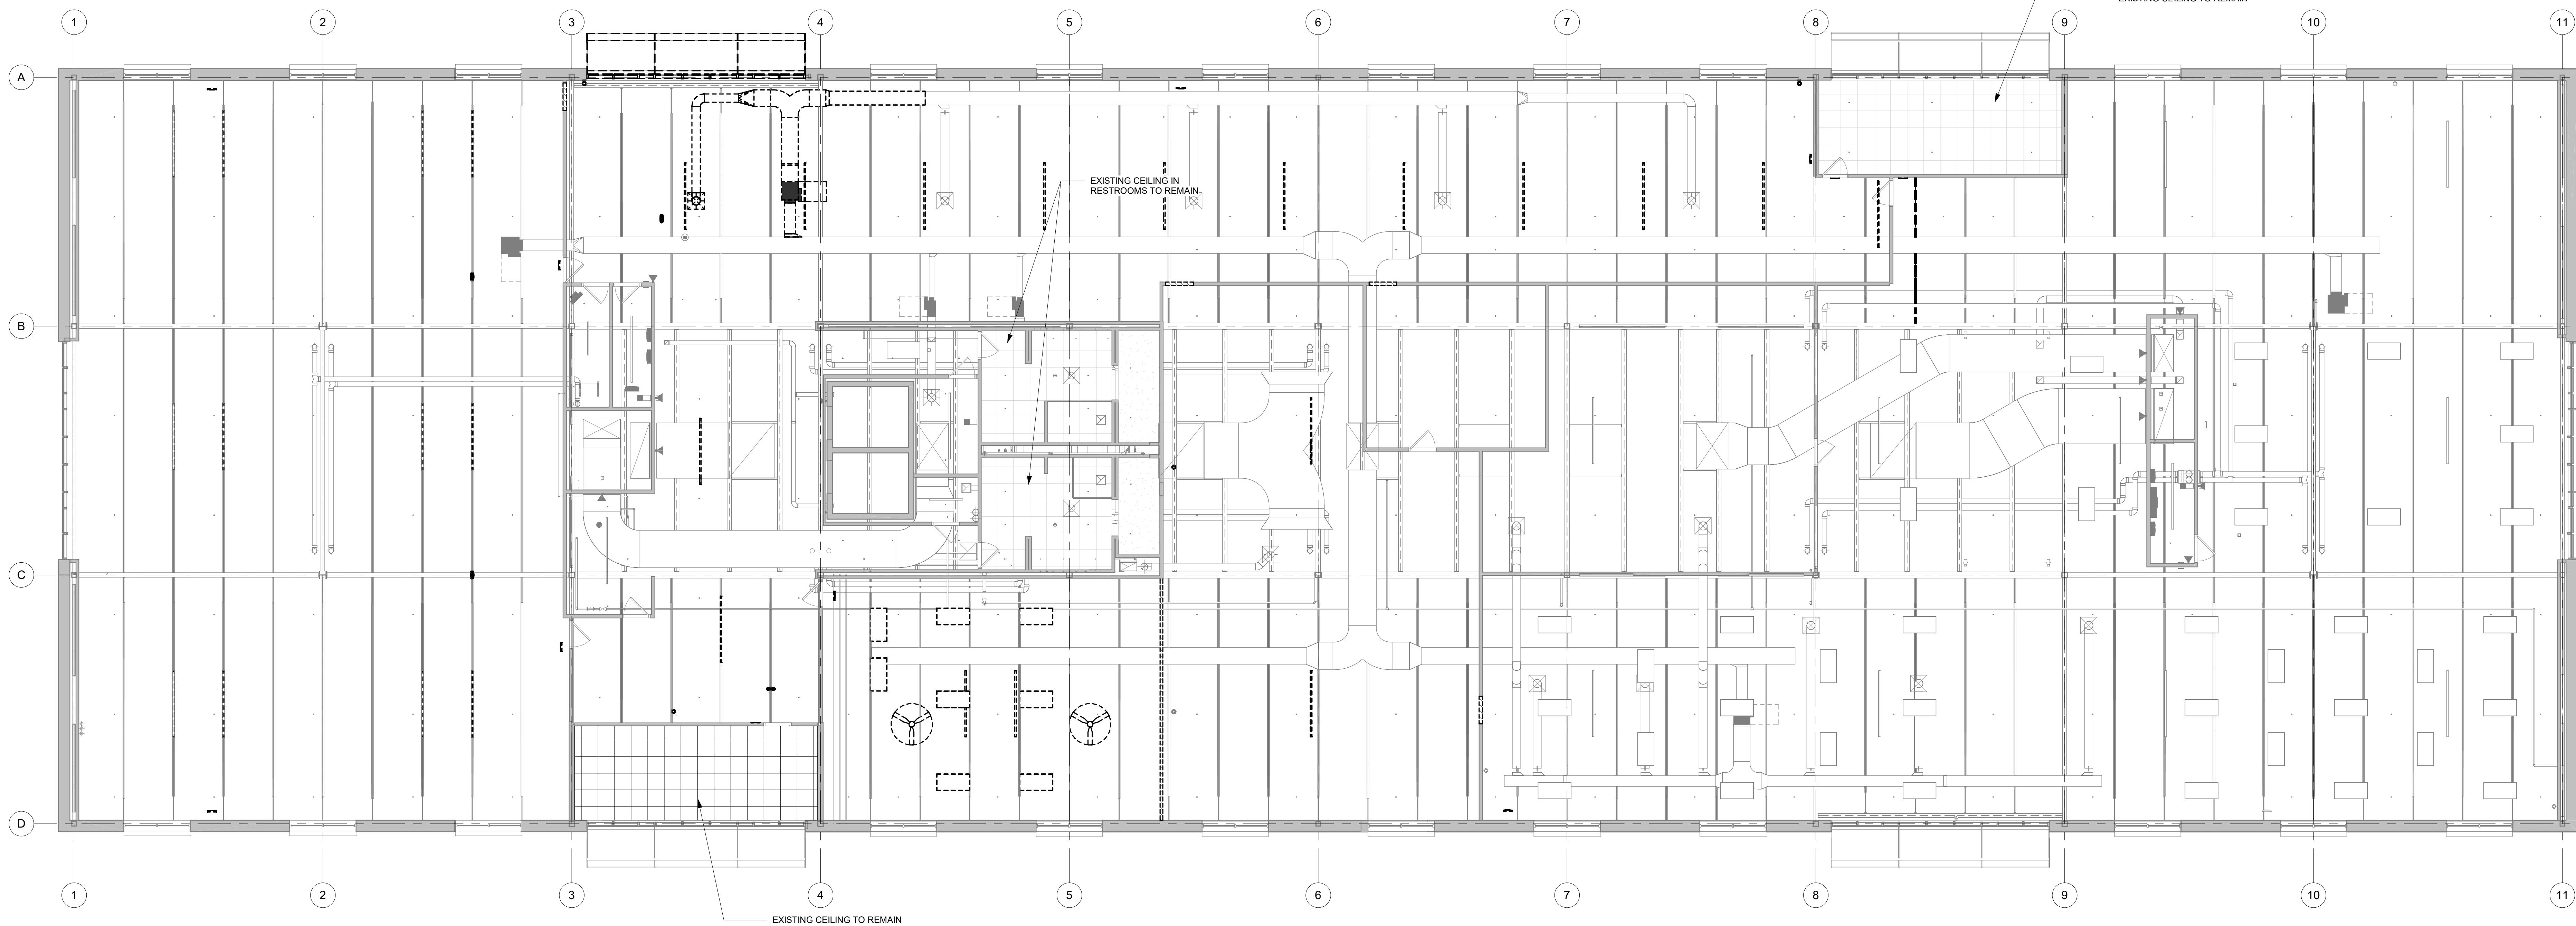

2 HHS LEVEL 3 DEMO RCP
1/8" = 1'-0"

GENERAL NOTES

1. IDENTIFICATION AND/OR ABATEMENT OF HAZARDOUS MATERIALS IS NOT PART OF THIS SCOPE OF WORK. IF ASBESTOS OR OTHER HAZARDOUS MATERIALS ARE ENCOUNTERED, THE CONTRACTOR SHALL NOTIFY THE OWNER IMMEDIATELY.
2. REMOVE LOOSE PAINT AND MISCELLANEOUS HANGING OBJECTS FROM WALLS AND CEILINGS AT ALL AREAS TO RECEIVE NEW FINISHES.
3. OPENINGS IN THE EXISTING STRUCTURE SMALLER THAN 12" IN ANY DIRECTION ARE NOT IDENTIFIED ON THESE DRAWINGS. SUB-CONTRACTORS SHALL BE RESPONSIBLE FOR PROVIDING OPENINGS SMALLER THAN 12" AS REQUIRED FOR INSTALLATION OF THEIR WORK.
4. OPENINGS IN THE EXISTING STRUCTURE SHALL NOT BE MADE WITHOUT PRIOR APPROVAL OF THE STRUCTURAL ENGINEER.
5. PATCH AND REPAIR ALL EXISTING FLOOR SLABS AND WALL SURFACES DAMAGED FROM DEMOLITION OR PRIOR USE.
6. PATCH ALL AREAS OF ELECTRICAL AND MECHANICAL DEMOLITION THAT WILL NOT BE REUSED.
7. CONTRACTOR TO FIELD VERIFY ALL EXISTING DIMENSIONS AND CONDITIONS. IN THE EVENT OF A DISCREPANCY BETWEEN THE DRAWINGS AND THE EXISTING CONDITIONS, NOTIFY THE ARCHITECT BEFORE PROCEEDING.
8. DO NOT REMOVE ANY ITEMS WHICH JEOPARDIZE THE STRUCTURAL INTEGRITY OF THE BUILDING. IF HIDDEN ELEMENTS OR DETERIORATED ELEMENTS ARE ENCOUNTERED, NOTIFY THE ARCHITECT IMMEDIATELY.
9. EXISTING BUILDING IS TO REMAIN WEATHER-TIGHT DURING ALL DEMOLITION ACTIVITIES.
10. REFER TO CONSULTANT DRAWINGS FOR ADDITIONAL DEMOLITION OF OTHER DISCIPLINES.
11. PROTECT ALL ADJACENT AREAS AND ITEMS TO REMAIN DURING DEMOLITION/CONSTRUCTION. REPAIR/REPLACE ALL ITEMS DAMAGED DURING CONSTRUCTION.
12. THE EXISTING BUILDING CONDITIONS SHOWN ON THESE DRAWINGS ARE ASSUMED TO BE REPRESENTATIVE OF THE ORIGINAL BUILDING AND LIMITED FIELD OBSERVATION, HOWEVER, IT SHOULD BE NOTED THAT LOCAL CONDITIONS MAY VARY FROM THOSE INDICATED.
13. THE CONTRACTOR SHALL PROVIDE AND MAINTAIN ADDITIONAL MEANS OF EGRESS AS NEEDED AS A RESULT OF CONSTRUCTION SEQUENCING AND/OR REGULATORY REQUIREMENTS.
14. REFER TO PLUMBING DRAWINGS FOR SLAB REMOVAL FOR INSTALLATION OF NEW UNDERSLAB PLUMBING WORK.
15. REFER TO ELECTRICAL DRAWINGS FOR SLAB REMOVAL FOR INSTALLATION OF NEW FLOOR BOXES AND UNDERSLAB CONDUIT.

DEMOLITION LEGEND

- DENOTES AREA OF COMPLETE REMOVAL OF AN EXISTING BUILDING ELEMENT
- DENOTES AREA OF COMPLETE REMOVAL OF FLOOR FINISH AND CEILING FINISH
- DENOTES AREA OF COMPLETE REMOVAL EXISTING FLOOR SLAB
- DENOTES AREA OF COMPLETE REMOVAL STRUCTURAL FRAMING AND COMPOSITE DECK, SEE STRUCTURAL
- DENOTES AREA OF COMPLETE REMOVAL OF CEILING
- DENOTES EXISTING SHELL SPACE, REFER TO MECHANICAL AND ELECTRICAL DRAWINGS FOR DETAILED REMOVAL INFORMATION
- DENOTES EXISTING TO REMAIN
- DENOTES EXISTING DOOR AND FRAME TO BE COMPLETELY REMOVED

KEYNOTE LEGEND

- 01 02 D08 REMOVE PORTION OF WALL FOR INSTALLATION OF NEW DOOR FRAME AND DOOR
- 01 02 D100 SALVAGE DEMOUNTABLE PARTITION AND TURN OVER TO OWNER.


GENERAL NOTES

1. IDENTIFICATION AND/OR ABATEMENT OF HAZARDOUS MATERIALS IS NOT PART OF THIS SCOPE OF WORK. IF ASBESTOS OR OTHER HAZARDOUS MATERIALS ARE ENCOUNTERED, THE CONTRACTOR SHALL NOTIFY THE OWNER IMMEDIATELY.
2. REFER TO SPECIFICATION FOR RECYCLING, CONSTRUCTION WASTE MANAGEMENT AND DISPOSAL REQUIREMENTS.
3. REMOVE LOOSE PAINT AND MISCELLANEOUS HANGING OBJECTS FROM WALLS AND CEILINGS AT ALL AREAS TO RECEIVE NEW FINISHES.
4. OPENINGS IN THE EXISTING STRUCTURE SMALLER THAN 12" IN ANY DIRECTION ARE NOT IDENTIFIED ON THESE DRAWINGS. SUB-CONTRACTORS SHALL BE RESPONSIBLE FOR PROVIDING OPENINGS SMALLER THAN 12" AS REQUIRED FOR INSTALLATION OF THEIR WORK.
5. OPENINGS IN THE EXISTING STRUCTURE SHALL NOT BE MADE WITHOUT PRIOR APPROVAL OF THE STRUCTURAL ENGINEER.
6. PATCH ALL AREAS OF ELECTRICAL AND MECHANICAL DEMOLITION THAT WILL NOT BE REUSED.
7. CONTRACTOR TO FIELD VERIFY ALL EXISTING DIMENSIONS AND CONDITIONS. IN THE EVENT OF A DISCREPANCY BETWEEN THE DRAWINGS AND THE EXISTING CONDITIONS, NOTIFY THE ARCHITECT BEFORE PROCEEDING.
8. DO NOT REMOVE ANY ITEMS WHICH JEOPARDIZE THE STRUCTURAL INTEGRITY OF THE BUILDING. IF HIDDEN ELEMENTS OR DETERIORATED ELEMENTS ARE ENCOUNTERED, NOTIFY THE ARCHITECT IMMEDIATELY.
9. PATCH ALL REMAINING EXISTING EXPOSED PLASTER CEILING AS REQUIRED TO RECEIVE NEW FINISH.
10. EXISTING BUILDING IS TO REMAIN WEATHER-TIGHT DURING ALL DEMOLITION ACTIVITIES.
11. REFER TO CONSULTANT DRAWINGS FOR ADDITIONAL DEMOLITION OF OTHER DISCIPLINES.
12. PROTECT ALL ADJACENT AREAS AND ITEMS TO REMAIN DURING DEMOLITION/CONSTRUCTION. REPAIR/REPLACE ALL ITEMS DAMAGED DURING CONSTRUCTION.
13. EXISTING BUILDING CONDITIONS SHOWN ON THESE DRAWINGS ARE DERIVED FROM DRAWINGS OF THE ORIGINAL BUILDING AND FROM LIMITED FIELD OBSERVATION.
14. INDICATED EXISTING BUILDING CONDITIONS ARE ASSUMED TO BE REPRESENTATIVE OF THE ACTUAL CONSTRUCTION OF THE BUILDING. LOCAL CONDITIONS MAY VARY.

DEMOLITION CEILING LEGEND

- EXISTING ELEMENT TO BE REMOVED IN ENTIRETY
- EXISTING GYPSUM BOARD CEILING TO BE REMOVED IN ITS ENTIRETY
- EXISTING ACOUSTIC CEILING TILE SYSTEM TO BE REMOVED IN ITS ENTIRETY

Key Plan:

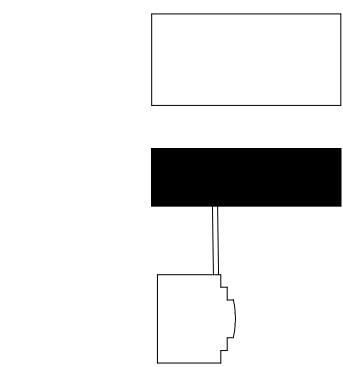

Revision	Description	Date
ADD 3	ADDENDUM 3	03/02/23

OPN Project No.

23412000

Sheet Group Name

BID DOCUMENTS

06/06/23

Sheet Name

HHS LEVEL THREE DEMO

FLOOR PLAN AND RCP

Sheet Number

AD-101B

GENERAL NOTES

- DIMENSIONS ARE MEASURED FACE-OF-FINISH TO FACE-OF-FINISH OR ROUGH MASONRY OPENING UNLESS NOTED OTHERWISE - TYPICAL FOR ALL DRAWINGS.
- FIELD VERIFY ALL DIMENSIONS AND EXISTING CONDITIONS - TYPICAL FOR ALL DRAWINGS.
- IN THE EVENT OF A DISCREPANCY BETWEEN ARCHITECTURAL AND CONSULTANT DRAWINGS, NOTIFY ARCHITECT IMMEDIATELY PRIOR TO COMMENCING WORK - TYPICAL FOR ALL DRAWINGS.
- ALL PENETRATIONS IN FIRE RATED FLOORS AND WALLS MUST BE SEALED WITH APPROPRIATE FIRESTOPPING SYSTEM.
- PATCH AND REPAIR EXISTING FLOOR SLABS AND WALL SURFACES DAMAGED FROM DEMOLITION.
- PATCH AND REPAIR EXISTING WALL SURFACES WHERE EXISTING ITEMS ARE REMOVED.
- INSTALL FIRE EXTINGUISHERS AS REQUIRED PER NFPA 10

GENERAL FINISH NOTES

- PAINT ALL INTERIOR MISCELLANEOUS METAL GRILLES, LOUVERS ACCESS PANELS, PIPES AND CONDUIT EXPOSED TO VIEW TO MATCH THE WALLS IN WHICH THEY OCCUR UNLESS OTHERWISE NOTED.
- PAINT ALL REVEALS TO MATCH THE WALLS IN WHICH THEY OCCUR.
- ALL PAINTED HOLLOW METAL DOORS AND FRAMES TO BE PAINTED TO MATCH THE COLOR OF THE WALL IN WHICH THEY OCCUR U.N.O.
- ALL FLOORING MATERIAL TRANSITIONS, TERMINATION AND SEAM LOCATIONS ARE TO BE CENTERED UNDER DOOR LEAFS IN CLOSED POSITION U.N.O.
- EXTEND FLOORING INTO TOE SPACES, DOOR REVEALS, CLOSETS AND SIMILAR OPENINGS U.N.O.
- PROVIDE FLOORING TRANSITION STRIPS AT FLOOR MATERIAL CHANGES. COORDINATE FLOORING TRANSITION MATERIAL, PROFILE, AND COLOR WITH ARCHITECT PRIOR TO INSTALLATION. REFER TO DETAIL DRAWINGS ON A-609 FOR DESIGN INTENT.
- REFER TO SHEET AG001 FOR TYPICAL MOUNTING HEIGHTS.
- POWER AND DATA LOCATIONS ARE TO BE COORDINATED IN THE FIELD WITH FINAL FURNISHING PLANS PRIOR TO INSTALLATION OF BOXES, FITTINGS, AND RACEWAYS.


KEYNOTE LEGEND

- 09 31 A1 PCT-1 FULL TILE PATTERN TO START AT WOM-1 AND CENTERED ON DOOR
- 09 31 A2 PCT-1 FULL TILE PATTERN TO START CENTERED AT STAIR VESTIBULE
- 09 62 A1 CARPET PATTERN TO EXTEND UNDER COUNTERS
- 09 68 A9 FRP TO SURROUND MOP SINK

FINISH FLOORING LEGEND:

- CPT PATTERN 1
SEE DETAIL 1A/121A
- CPT PATTERN 2
SEE DETAIL 2A/121A
- CPT PATTERN 3
SEE DETAIL 3A/121A
- CPT PATTERN 4
CPT 2 - HERRINGBONE
- CPT PATTERN 5
SEE DETAIL 2A/121B
- CPT PATTERN 6
CPT 2 - ASHLAR
- PCT-1
LARGE FORMAT PORCELAIN TILE
- RF-1
LVT
- SC
SEALED CONCRETE
- WOG-1
WALK OFF GRATE
- WOM-1
WALK OFF MAT

Key Plan

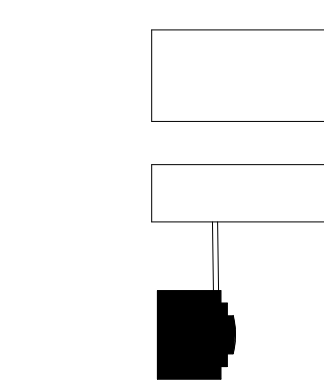

Revision	Description	Date
ADD 3	ADDENDUM 3	03/02/23

OPN Project No.

23412000

Sheet Group Name

BID DOCUMENTS


06/06/23

Sheet Name

ADM FINISH PLANS

Sheet Number

A-121A

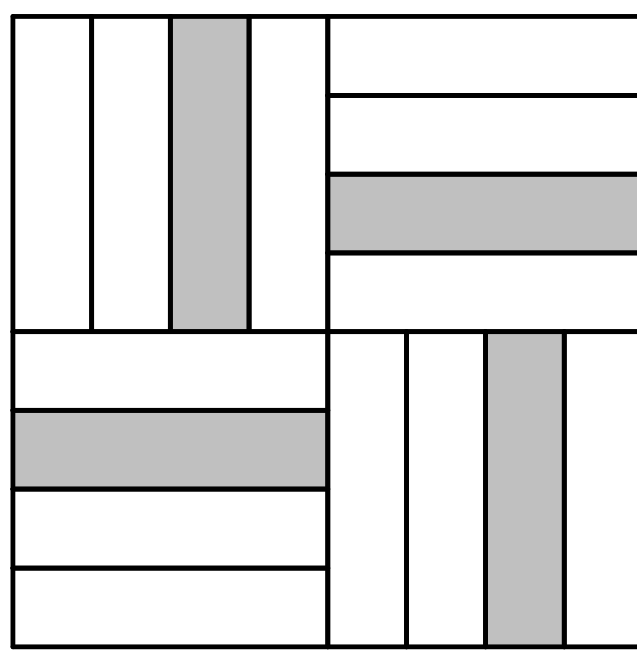


CARPET PATTERN 1 - COLOR LEGEND

CPT 2

CPT 4

*REFER TO A-609 FOR CARPET TYPE DETAILS

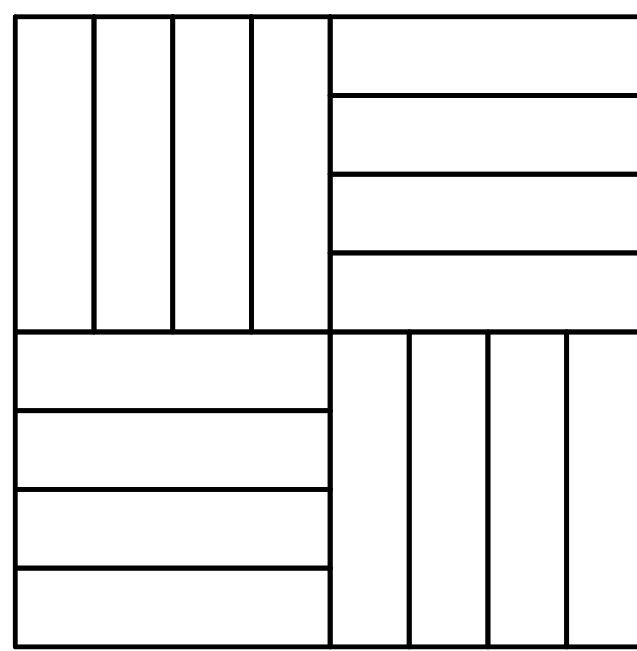


CARPET PATTERN 2 - COLOR LEGEND

CPT 2

CPT 4

*REFER TO A-609 FOR CARPET TYPE DETAILS

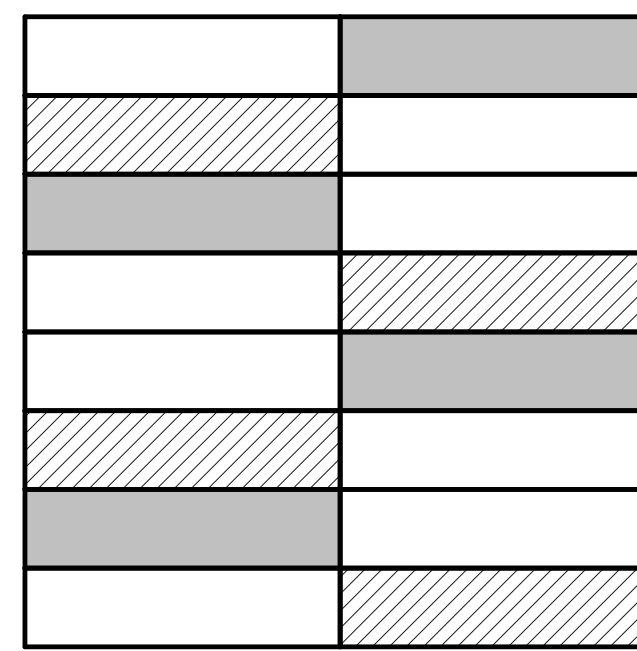

CARPET PATTERN 3 - COLOR LEGEND

CPT 2

CPT 3


CPT 4

*REFER TO A-609 FOR CARPET TYPE DETAILS


1 CARPET PATTERN 1 - ADM
1/2" = 1'-0"

2 CARPET PATTERN 2 - ADM
1/2" = 1'-0"


















3 CARPET PATTERN 3 - ADM
1/2" = 1'-0"

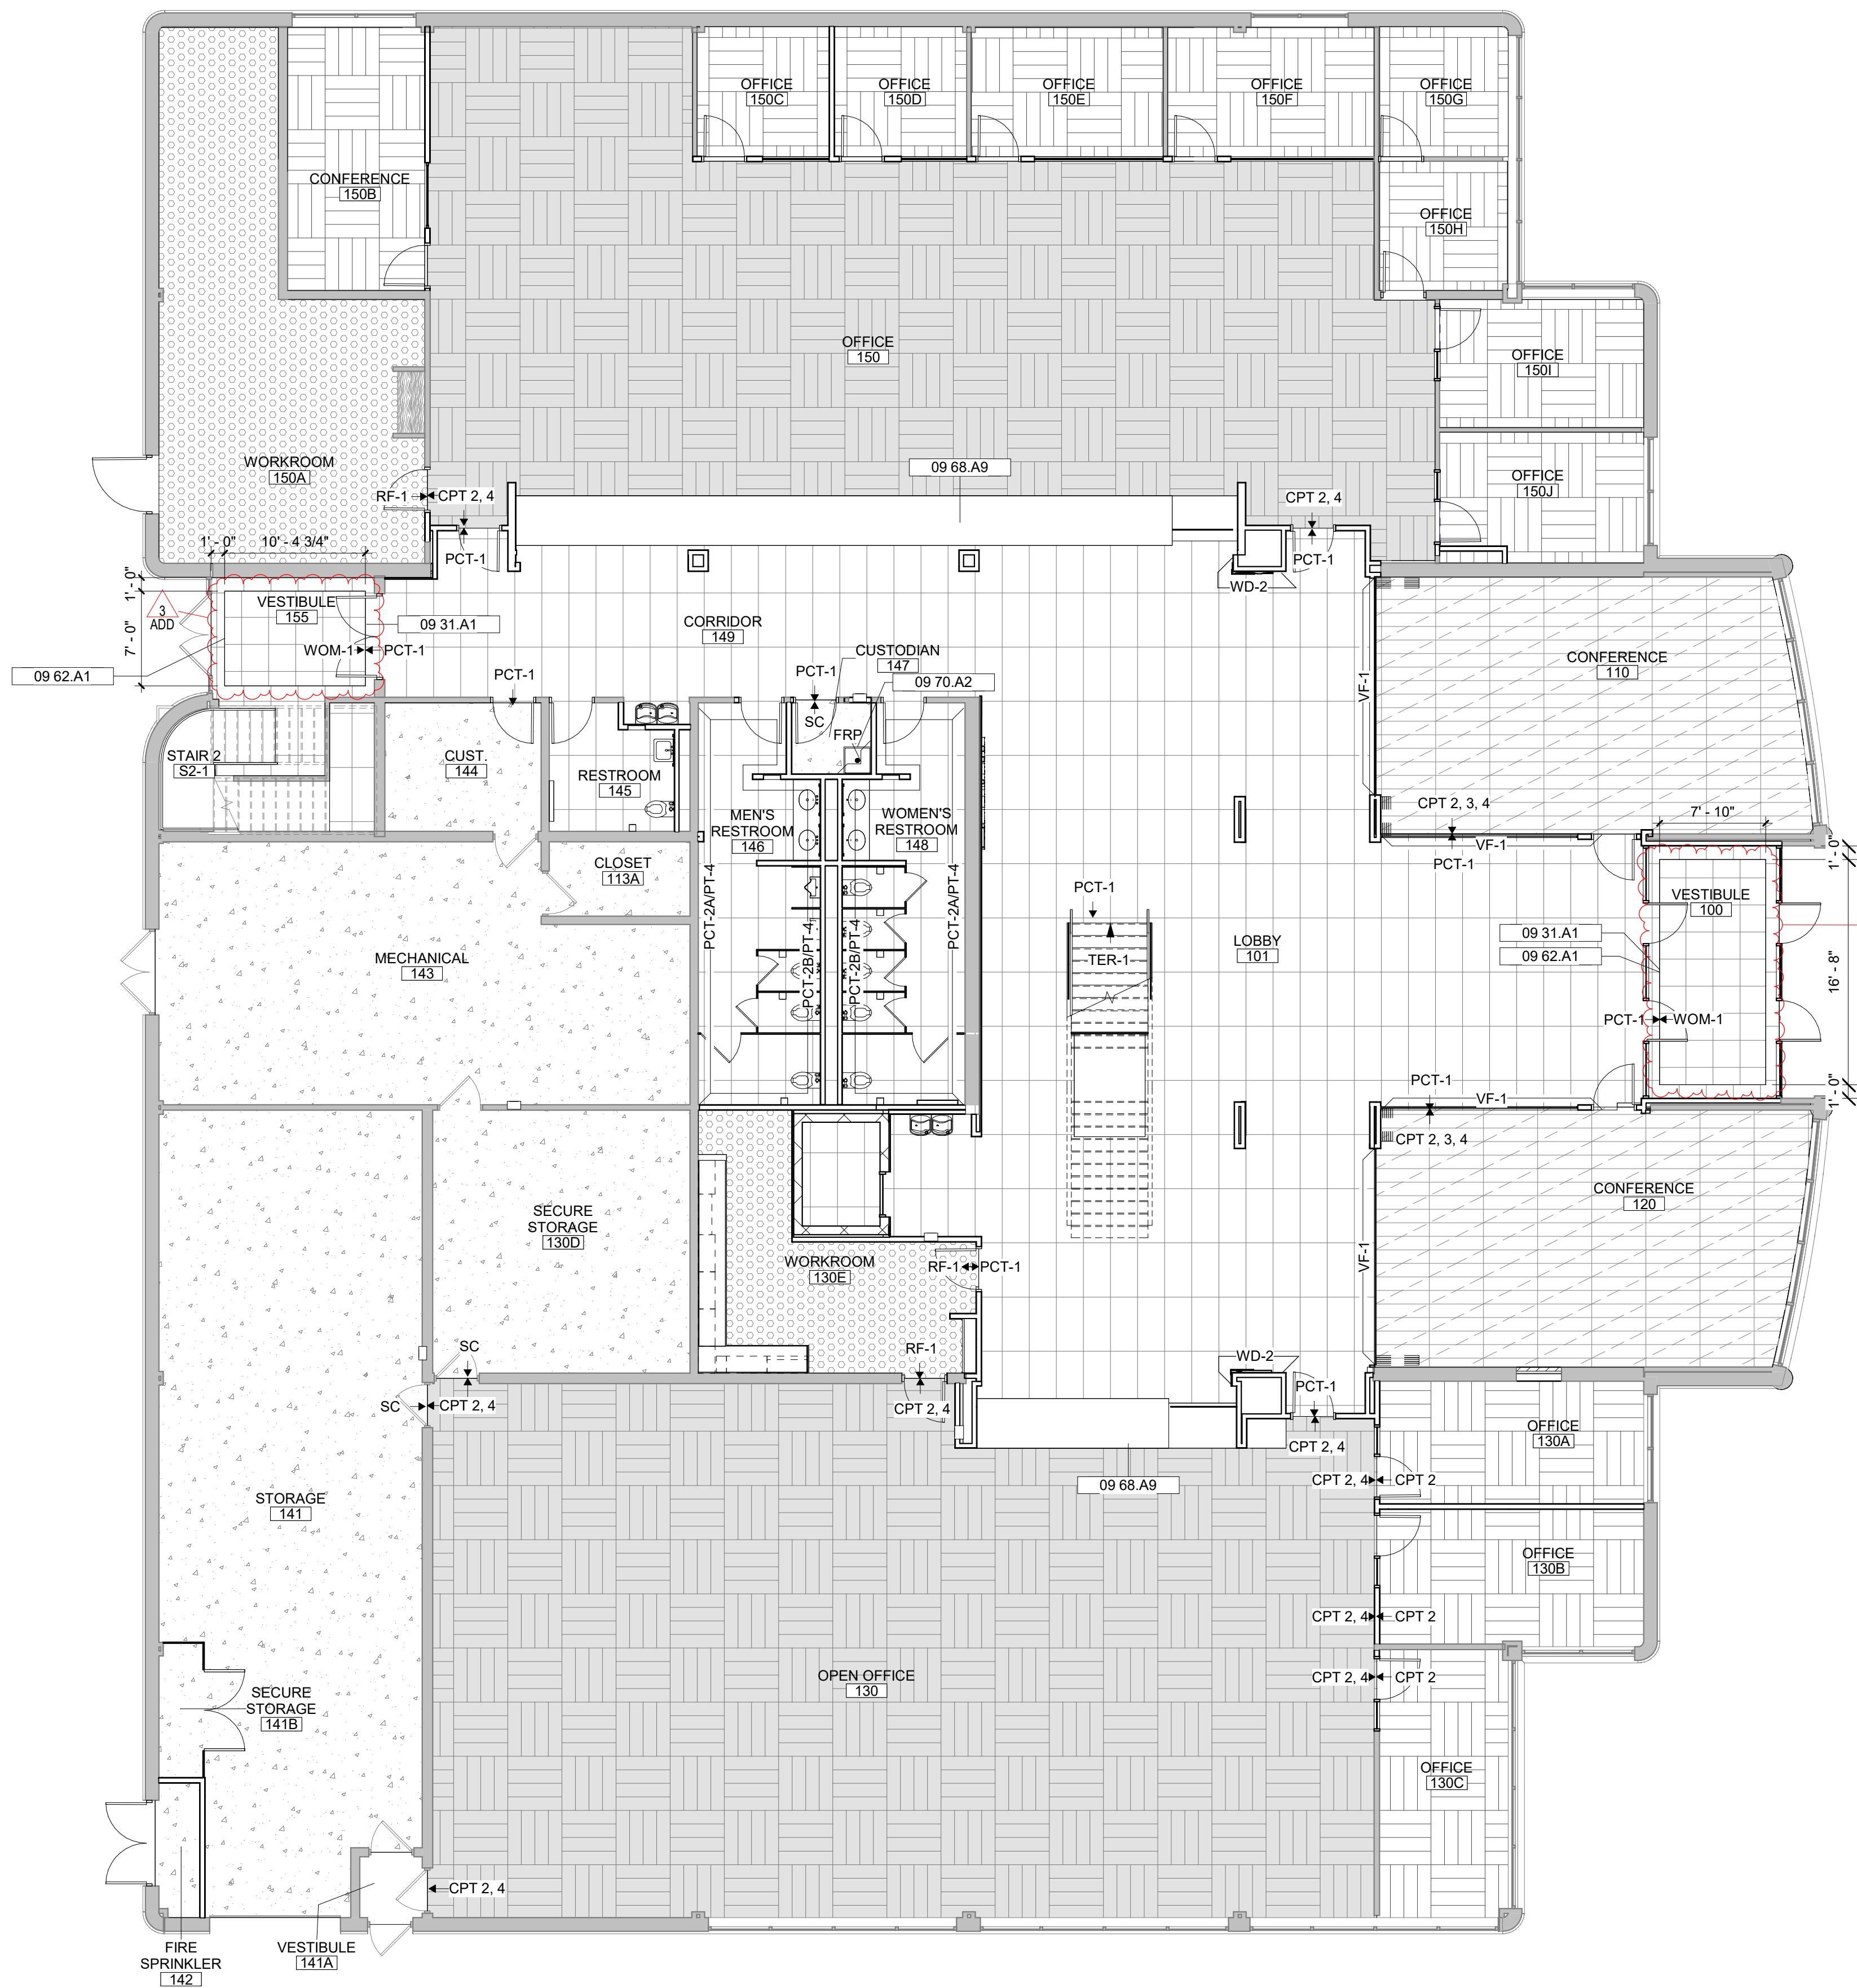

4 ADM - LEVEL 1 FINISH PLAN
1/8" = 1'-0"

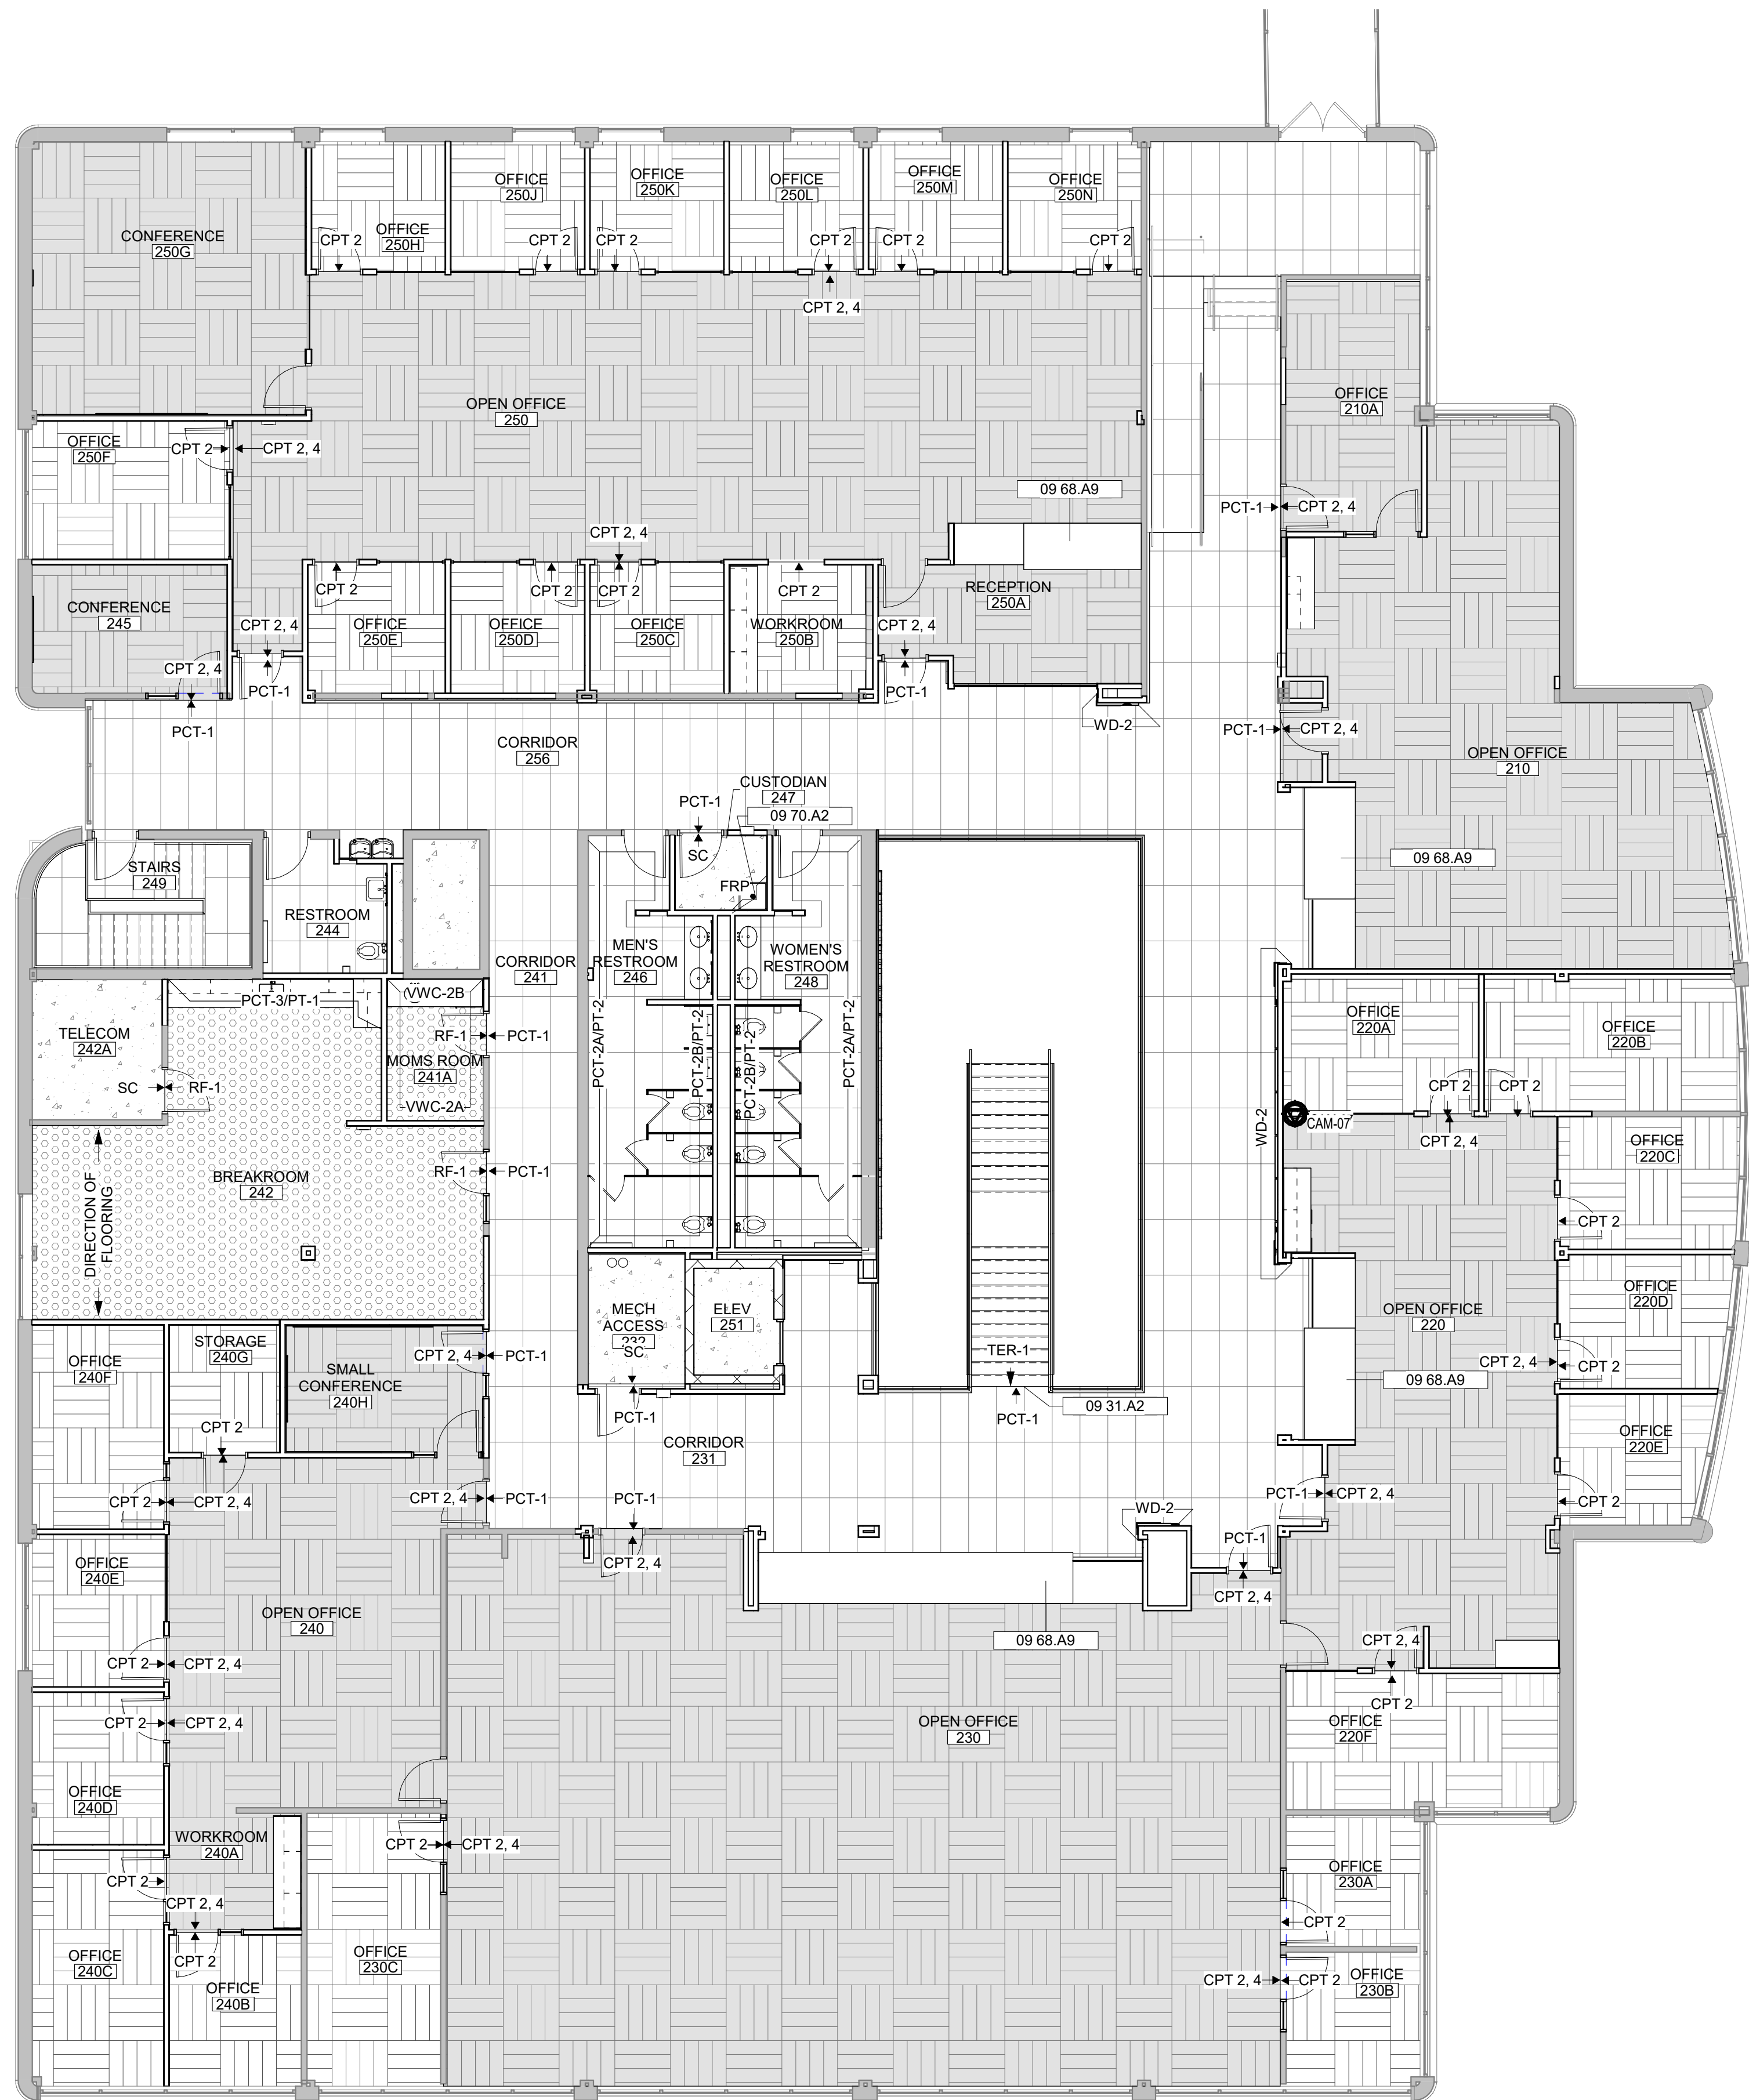

5 ADM - LEVEL 2 FLOOR PLAN
1/8" = 1'-0"

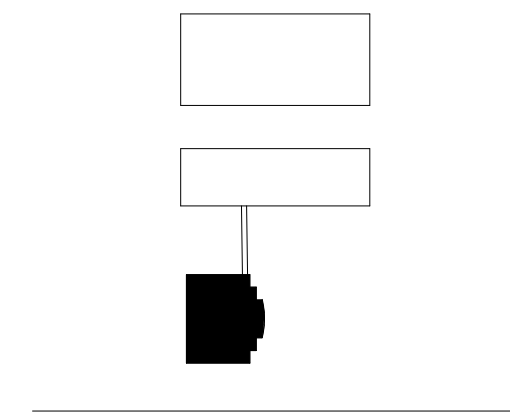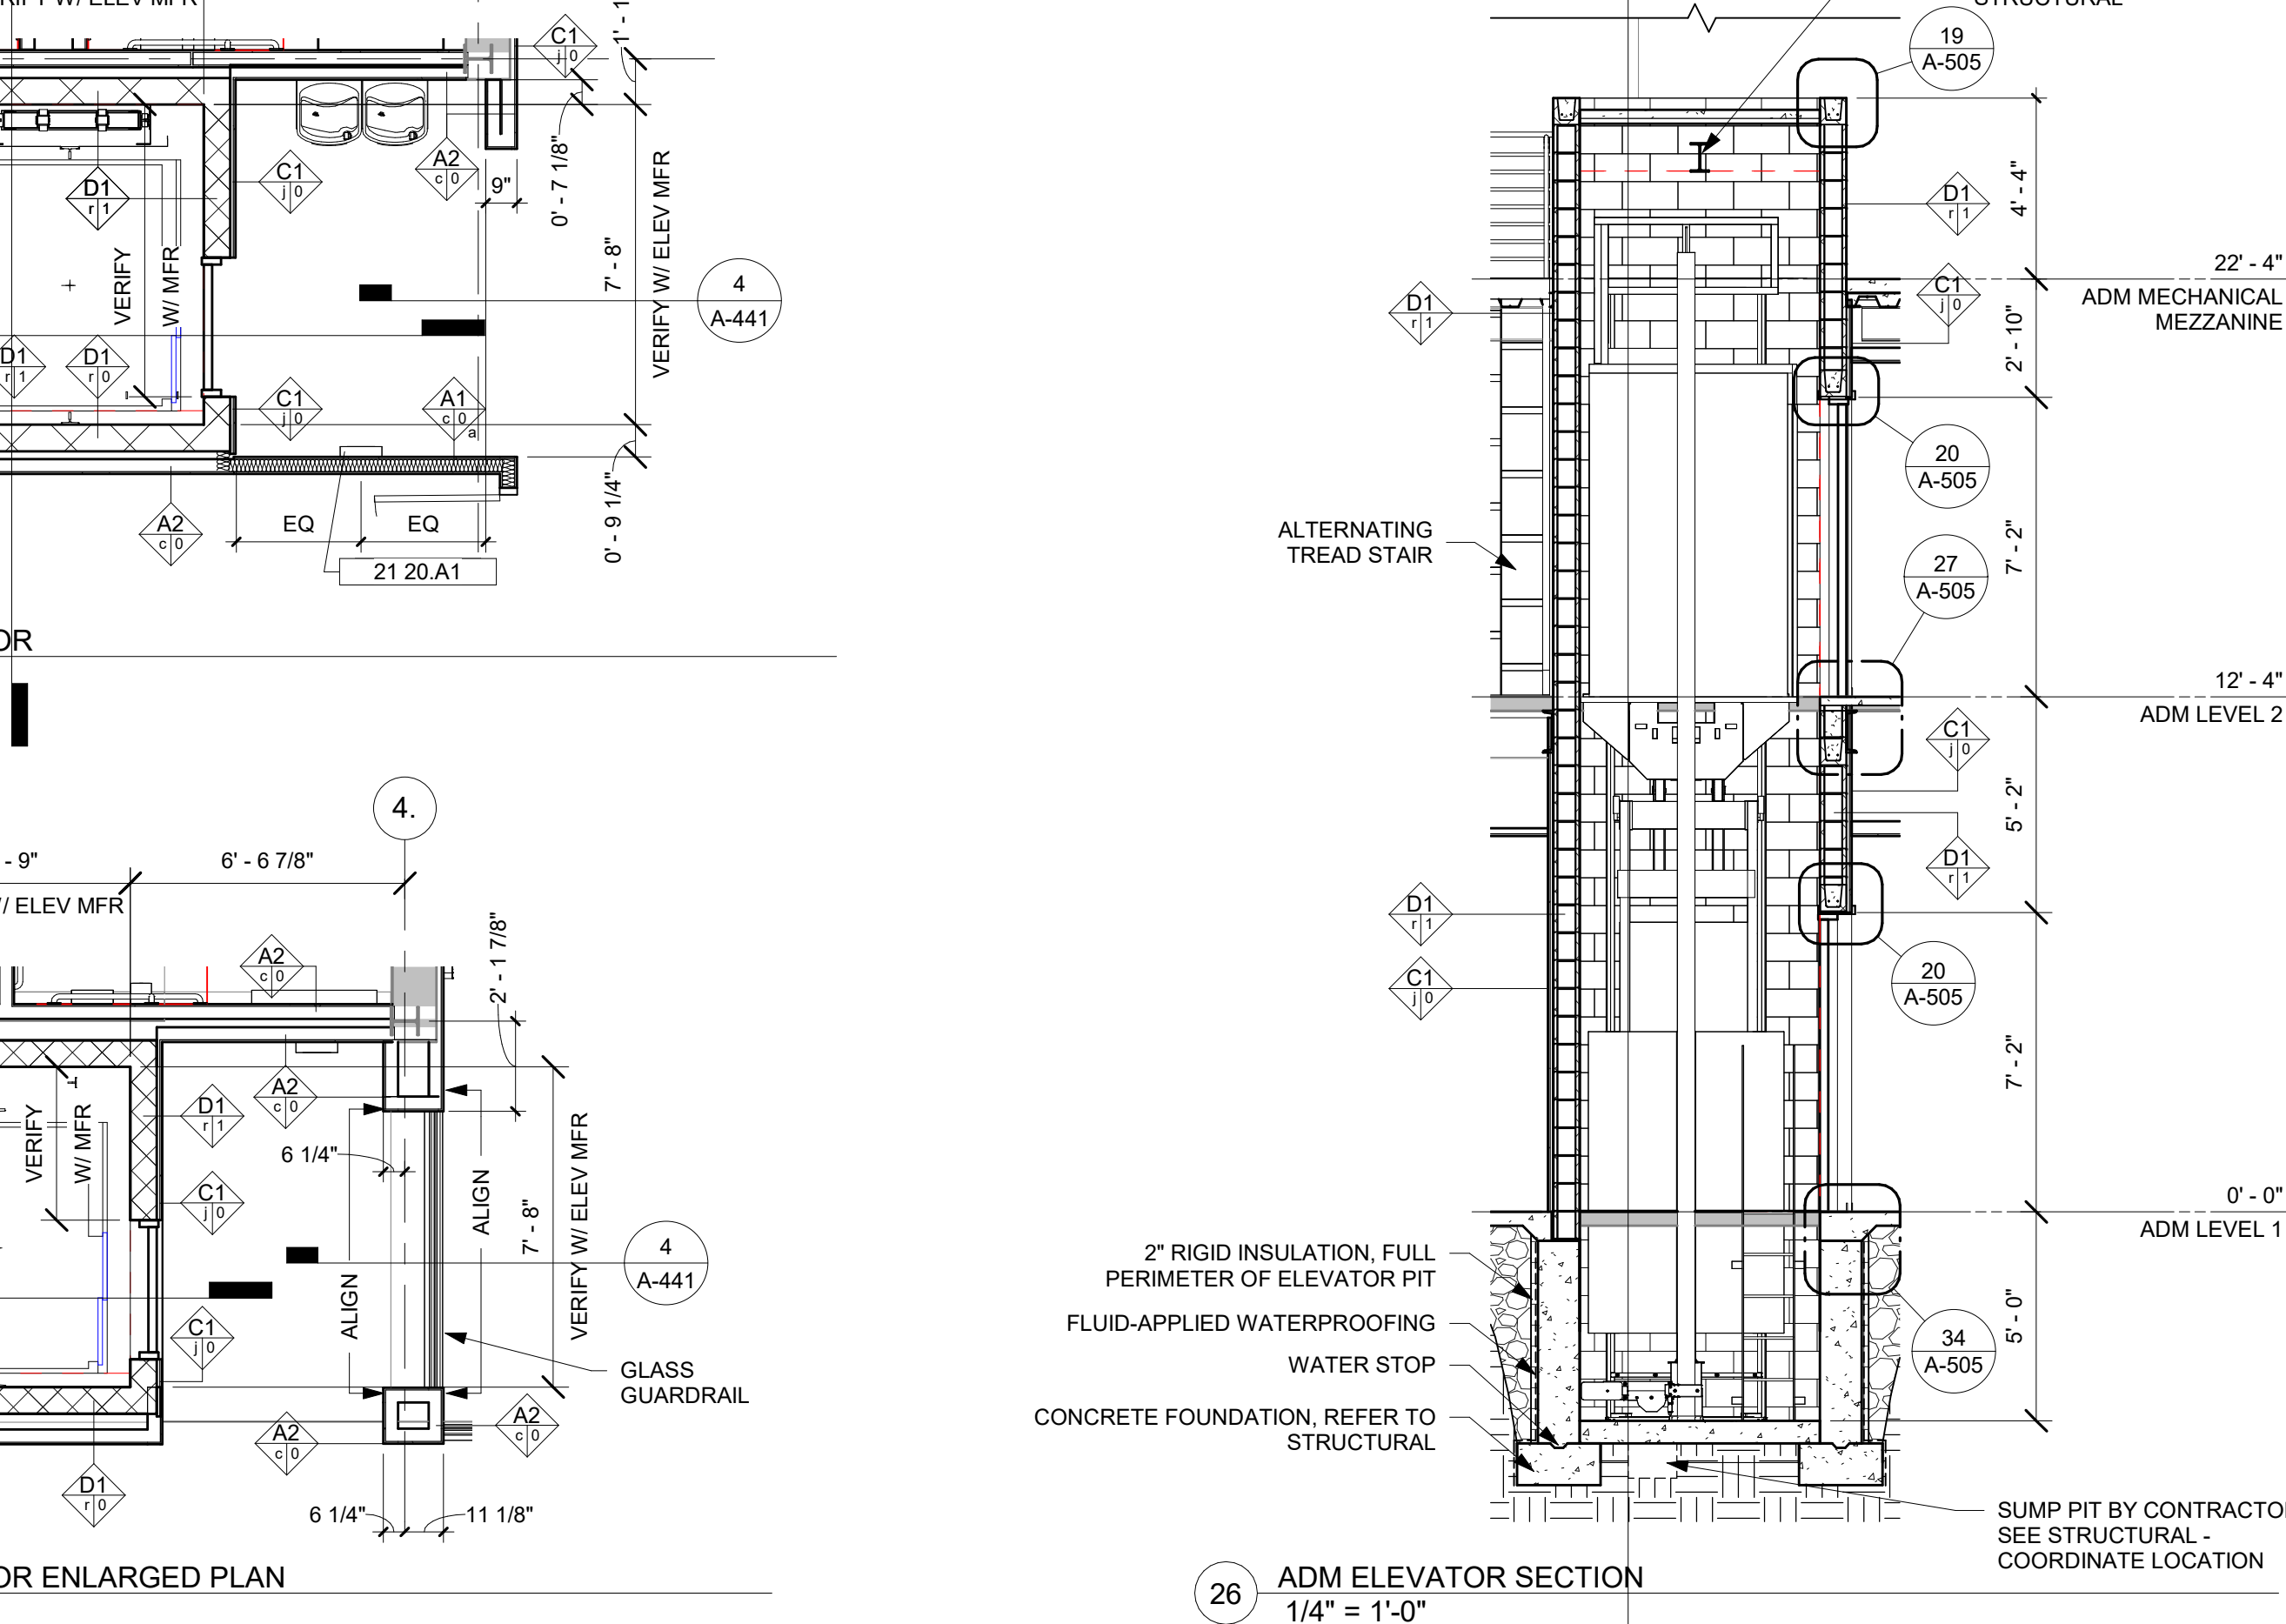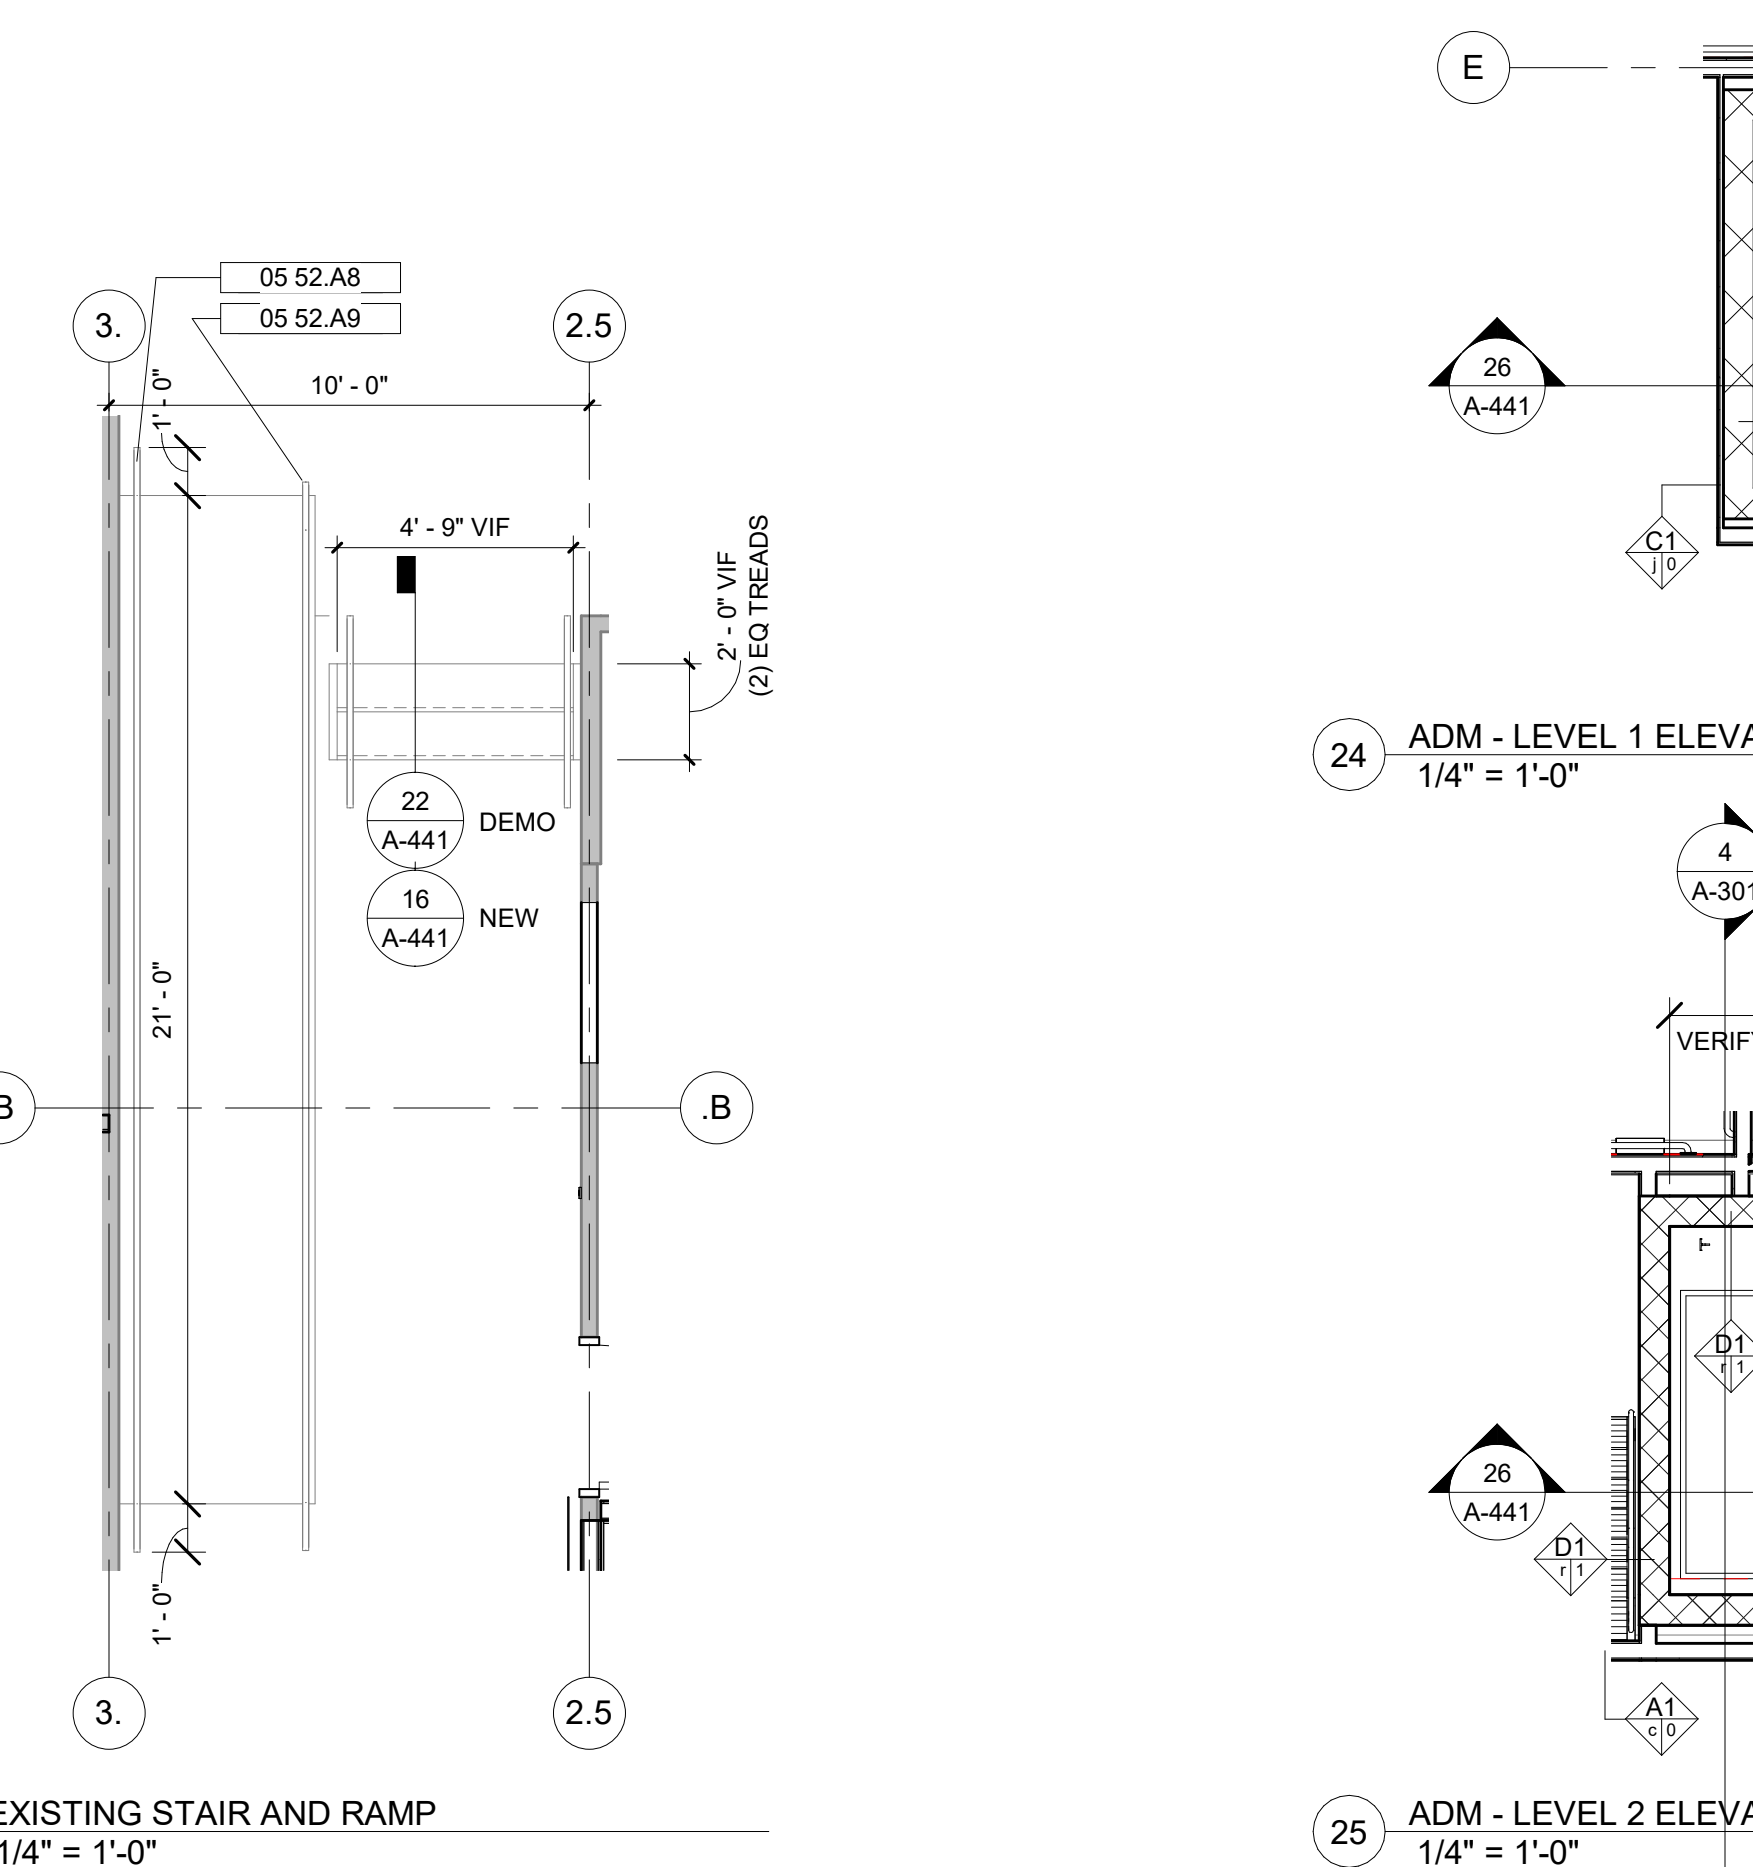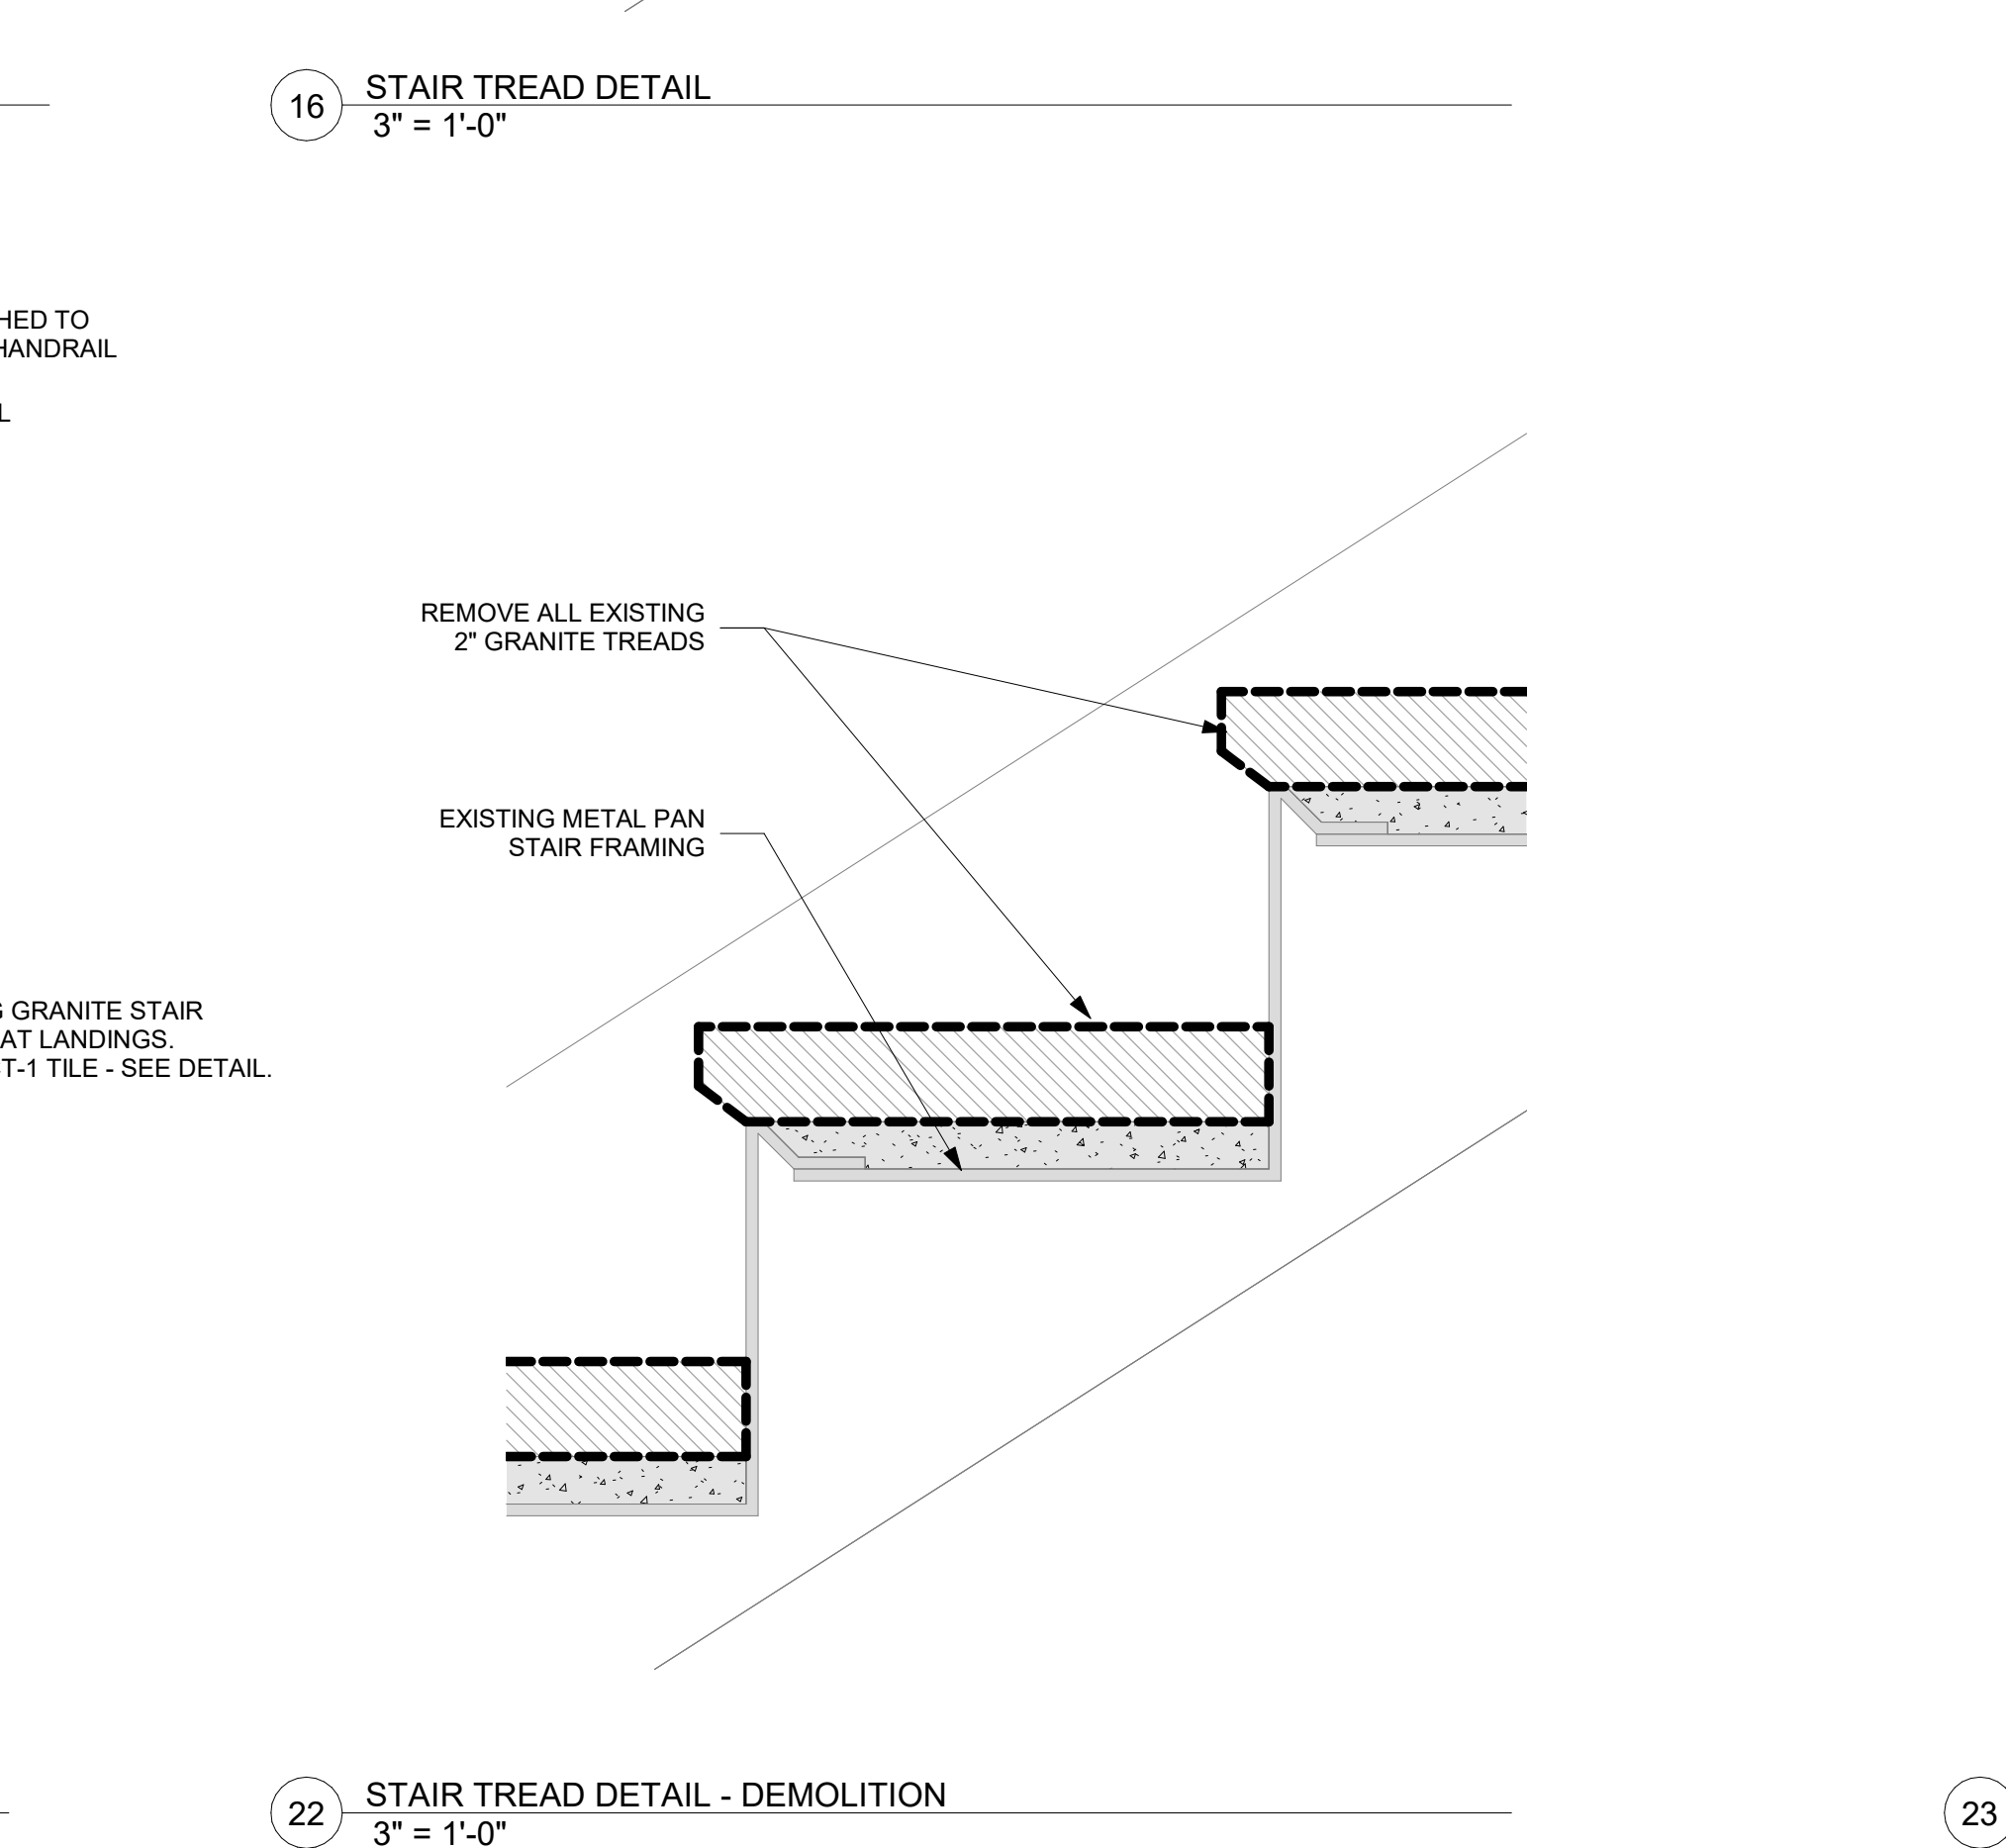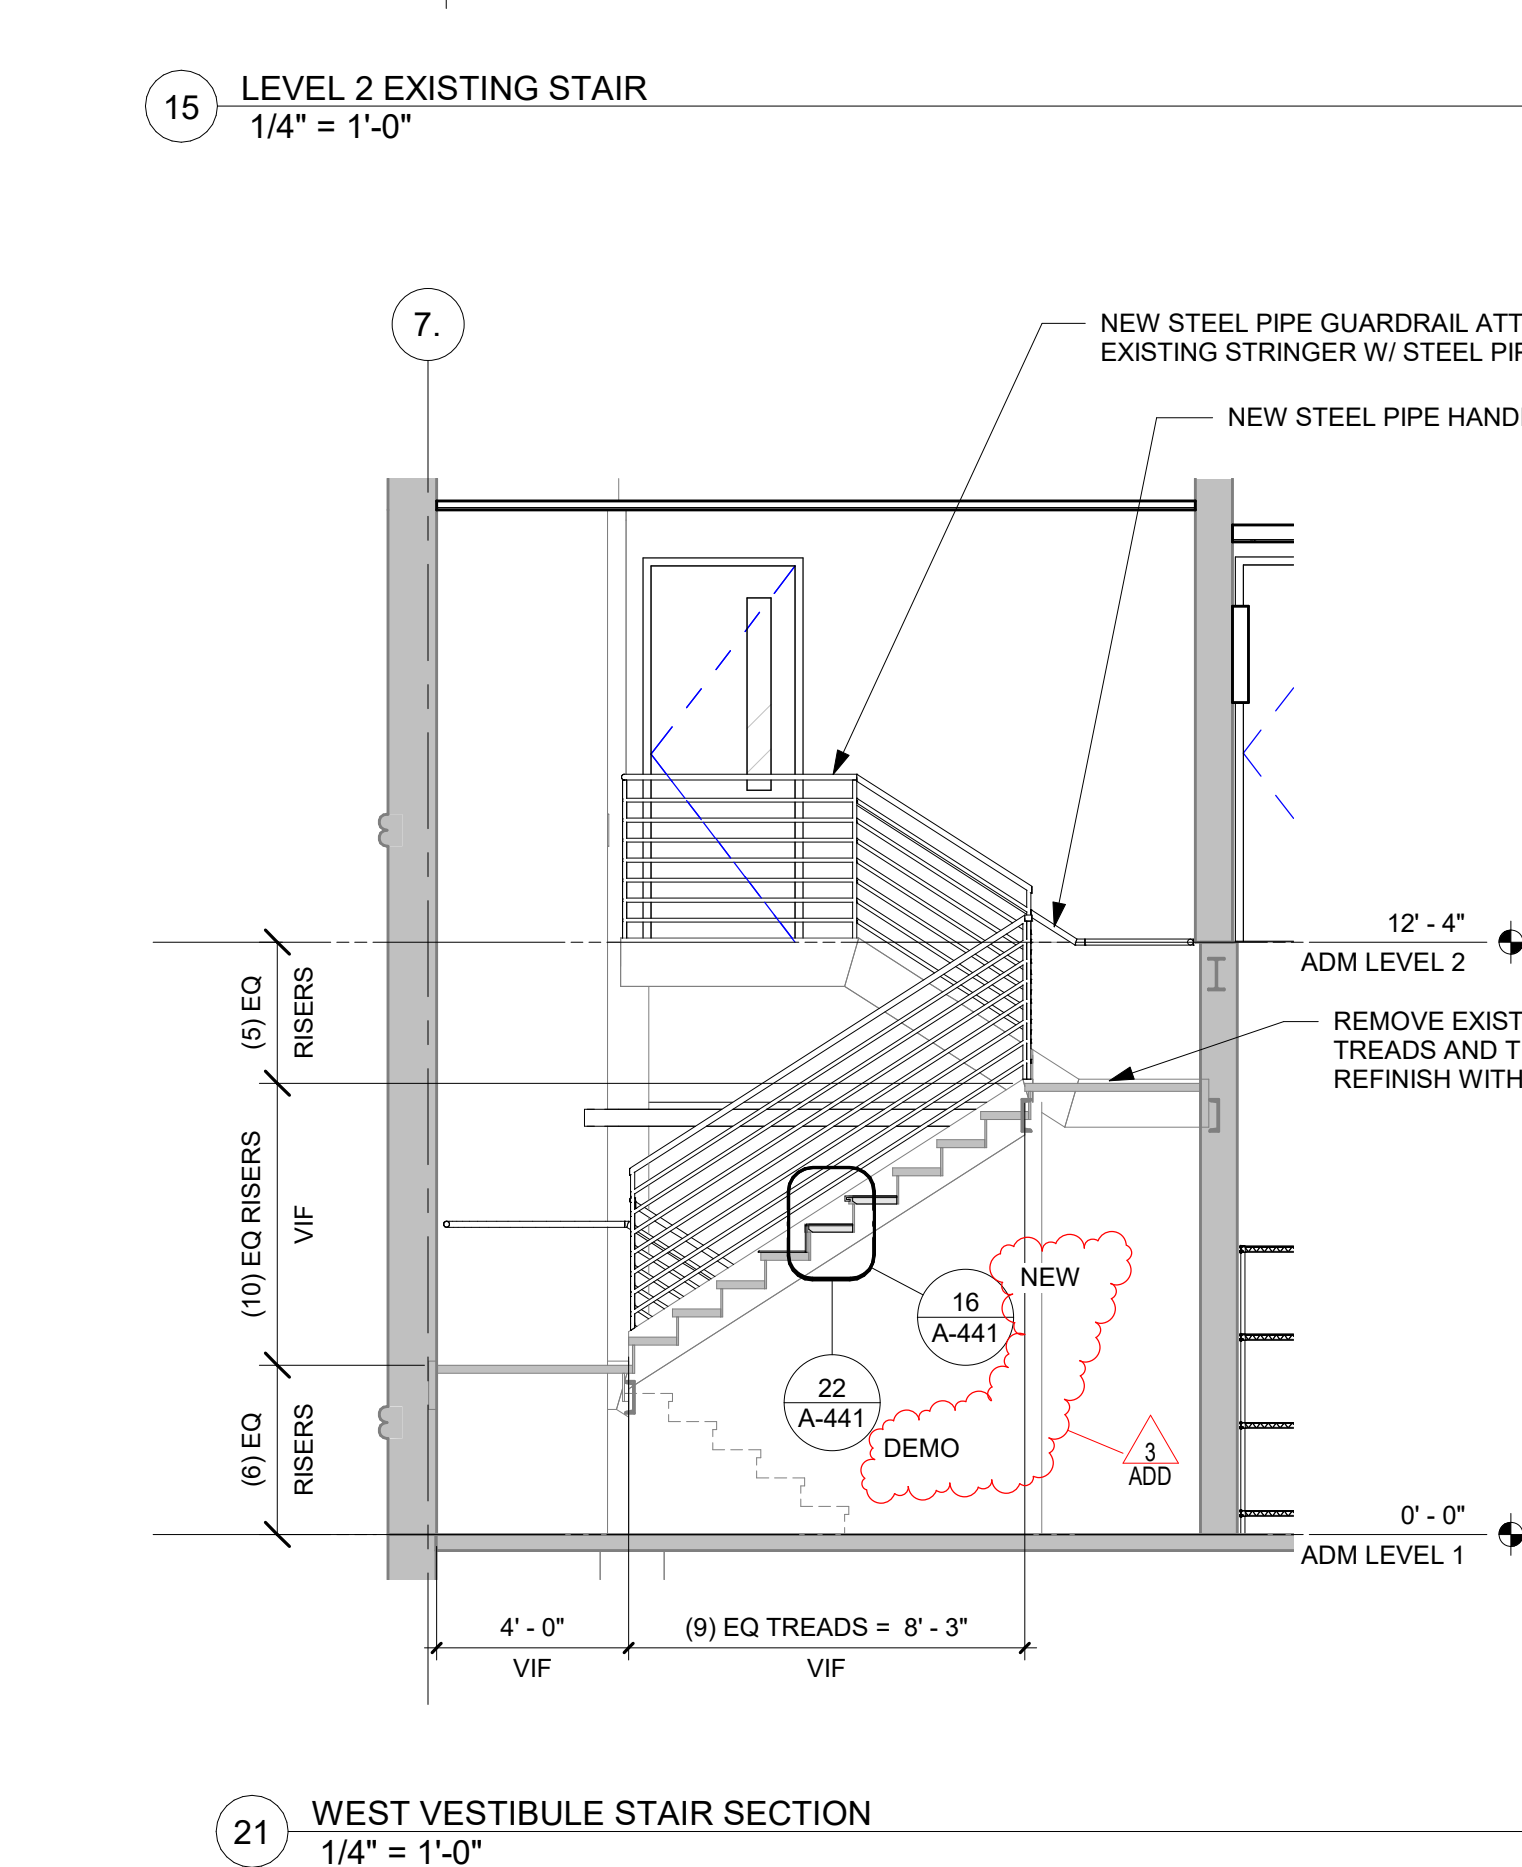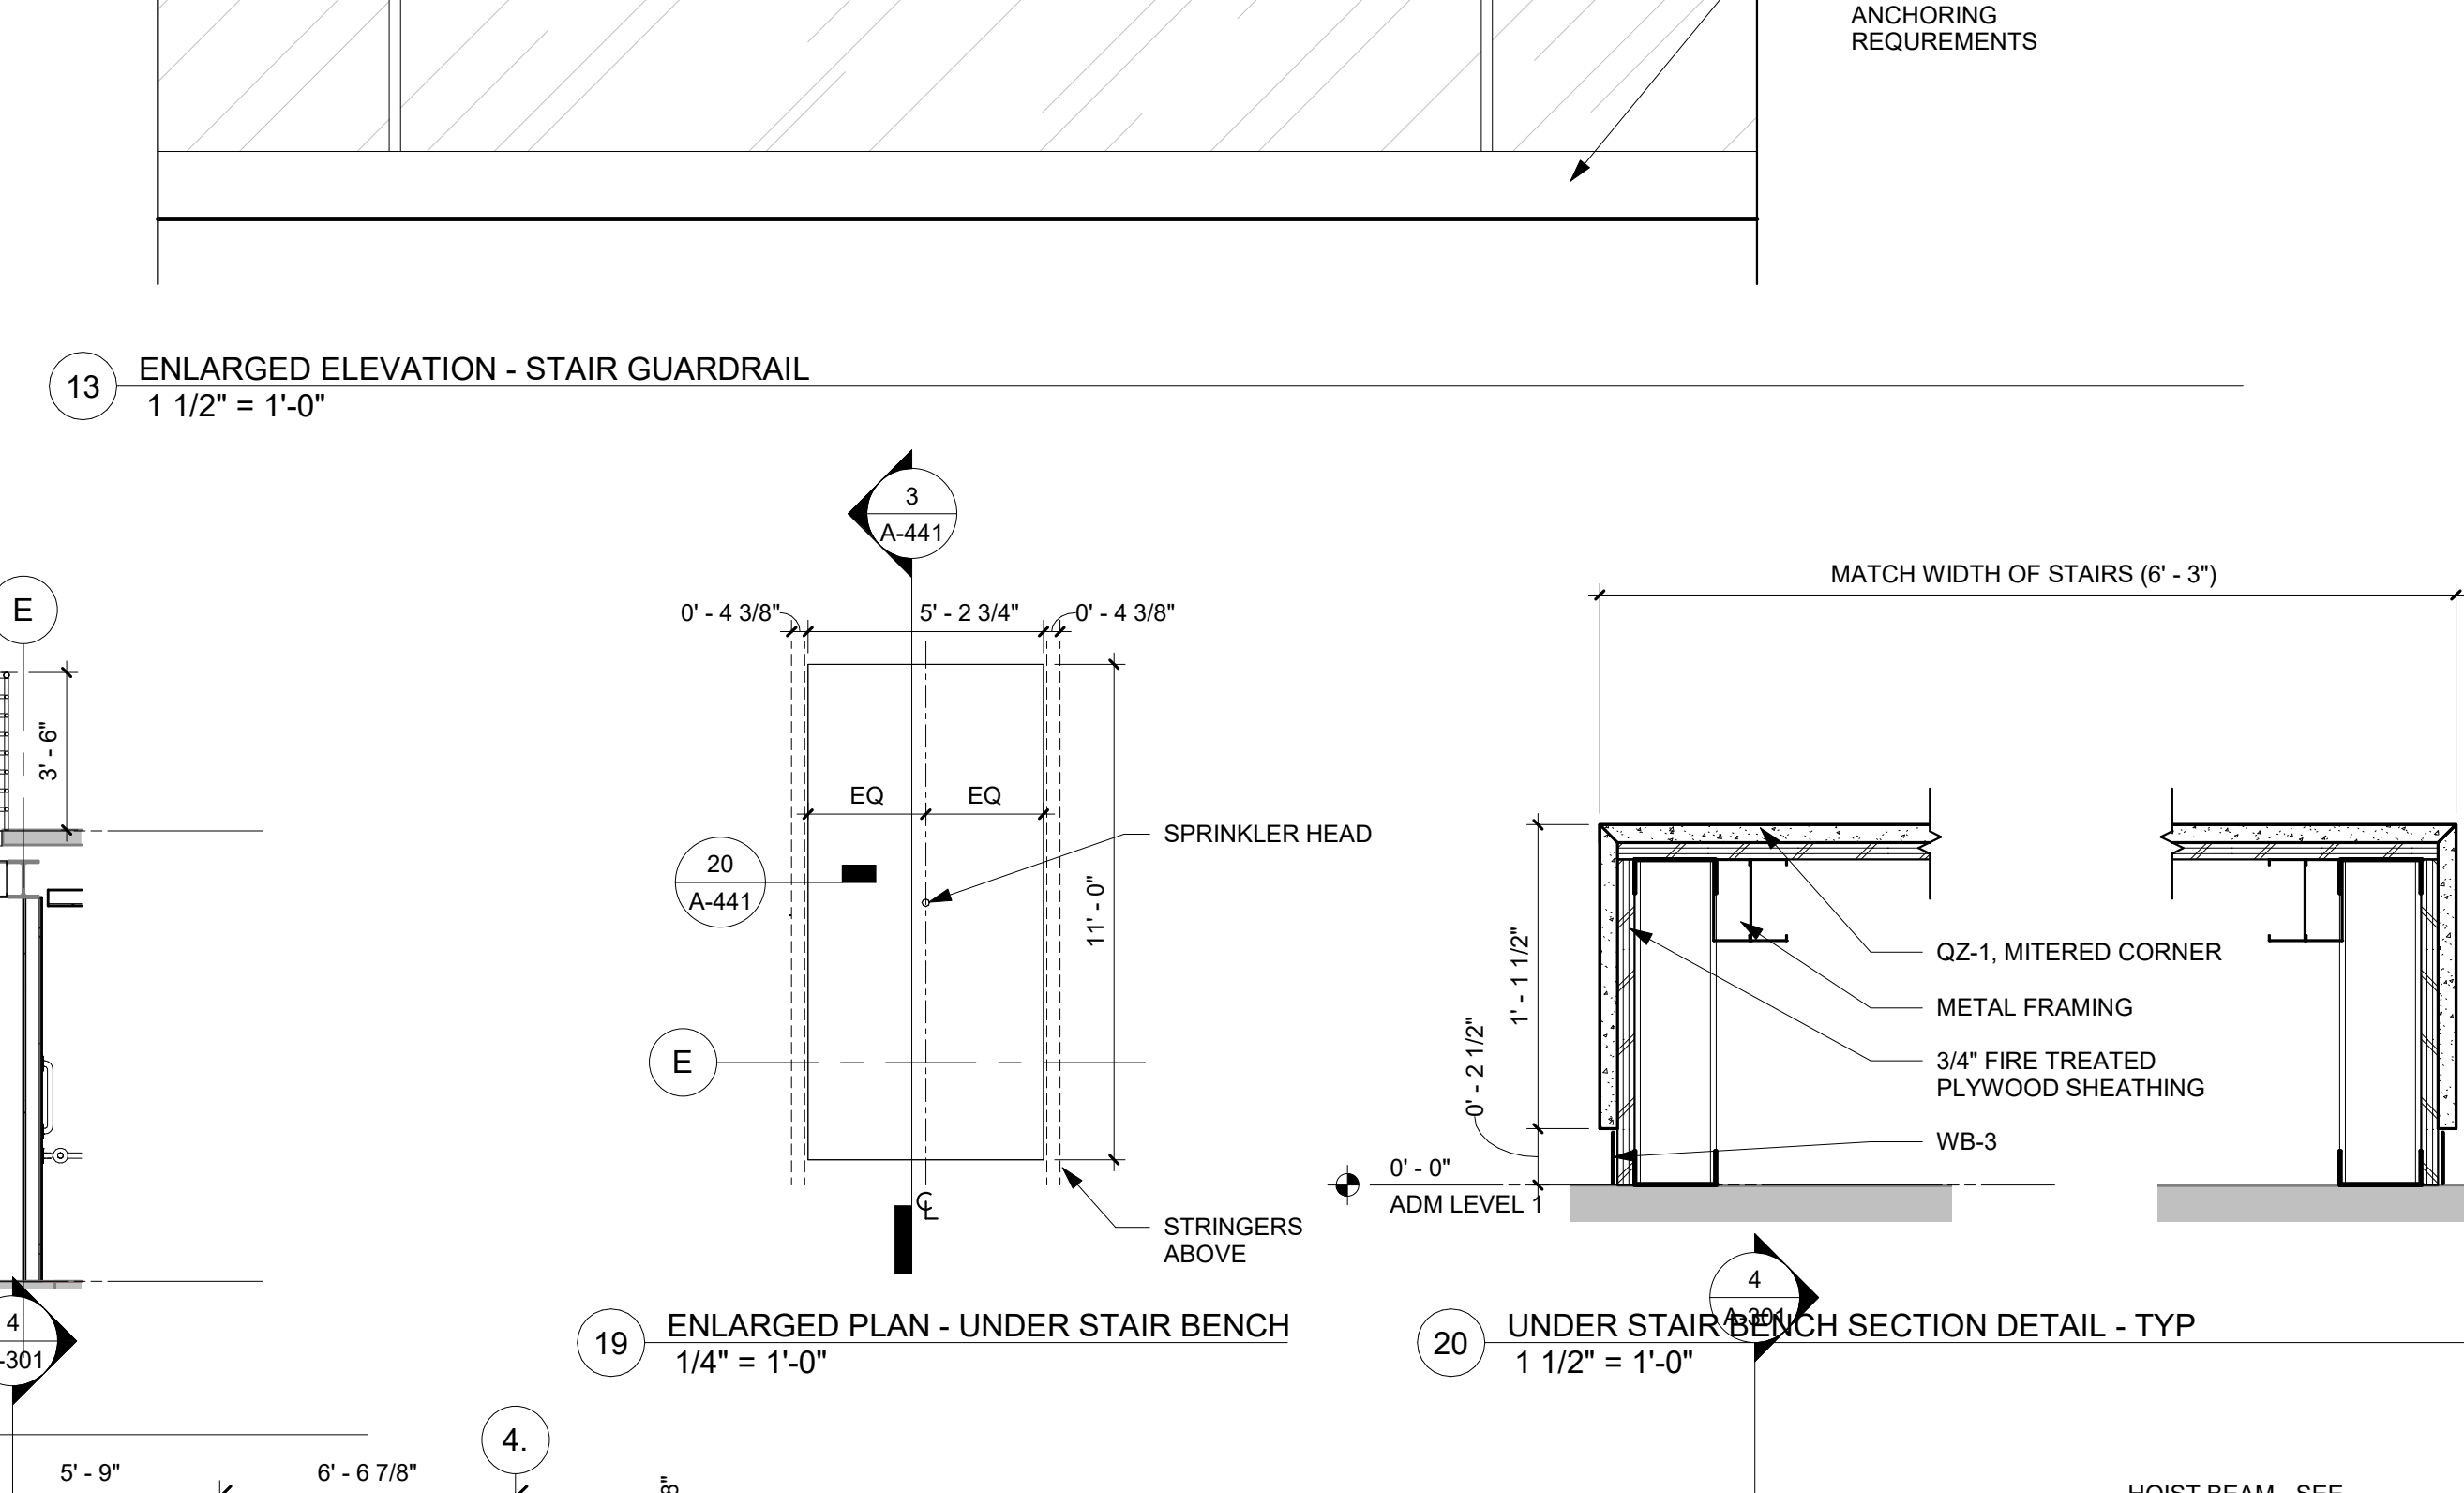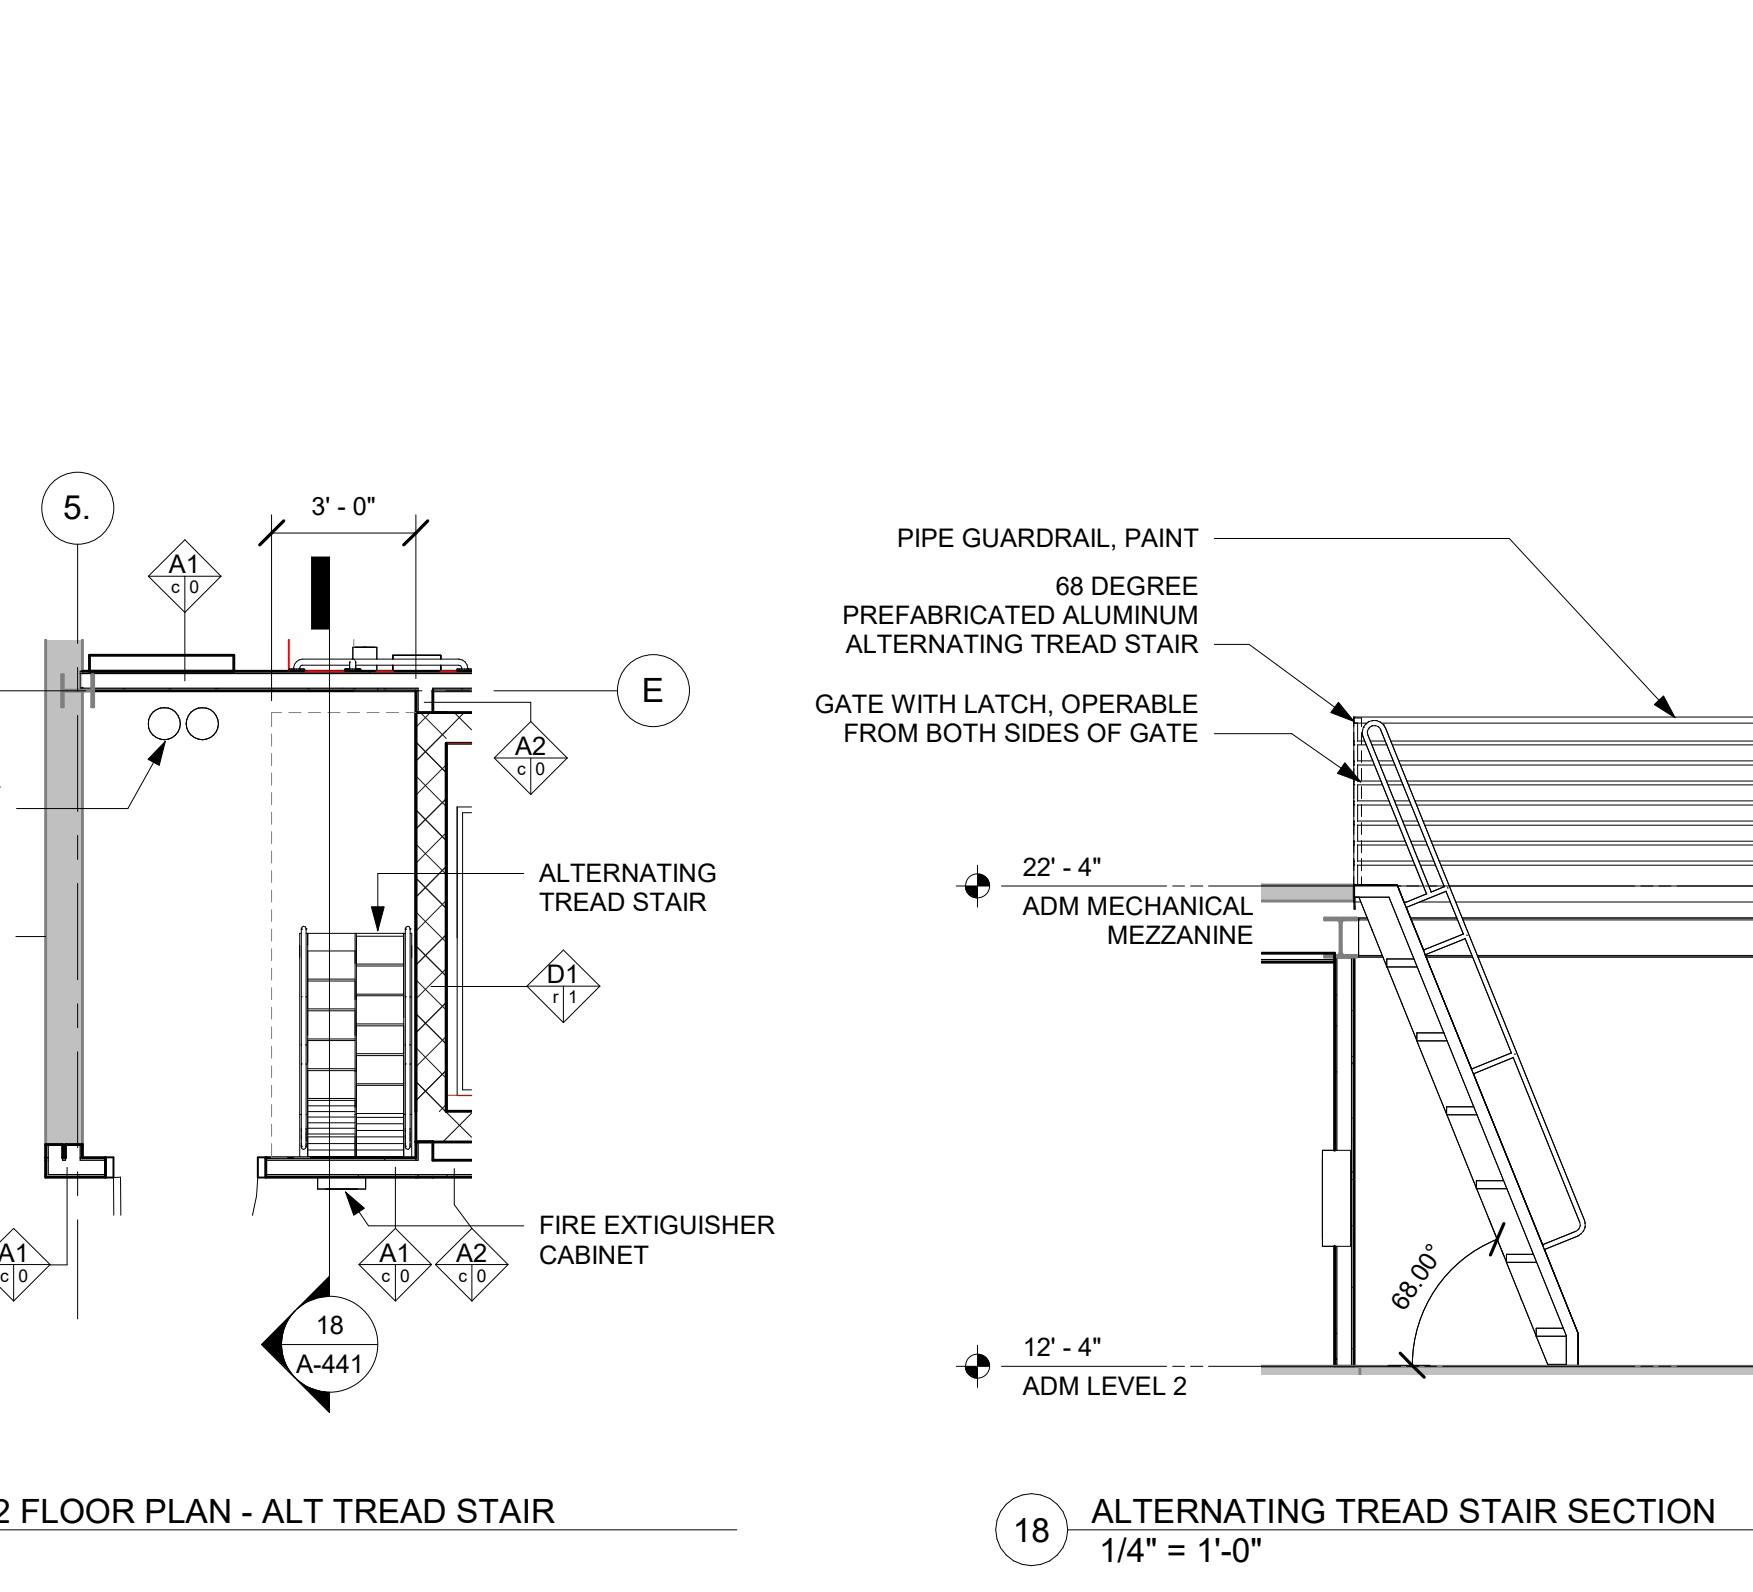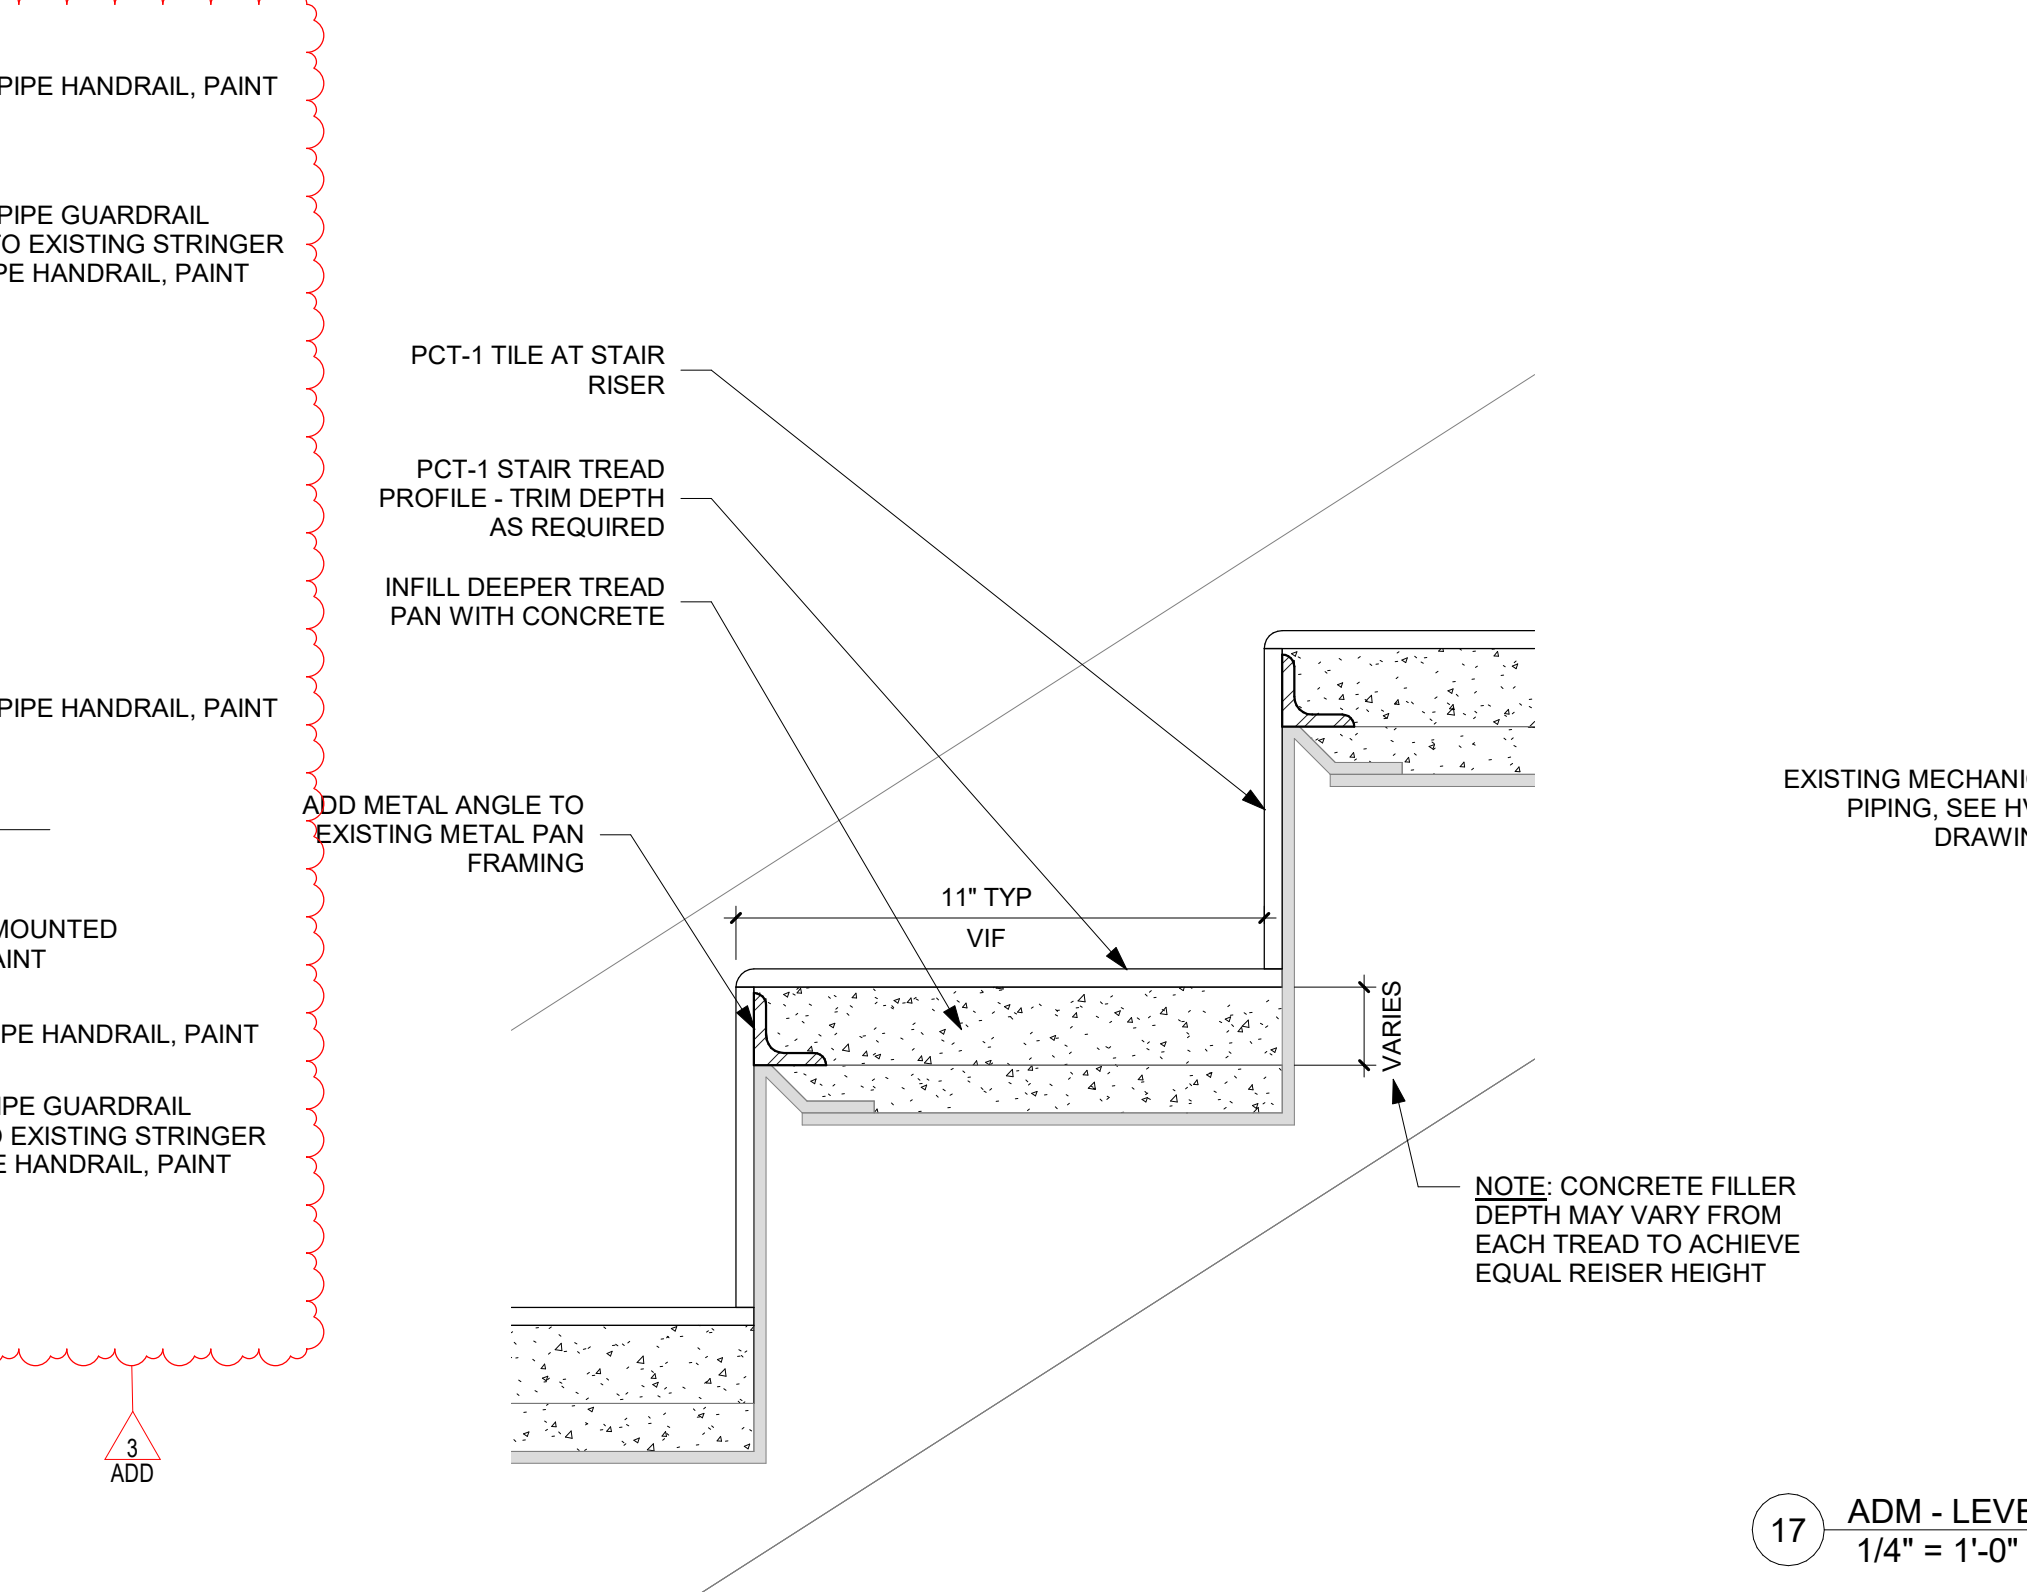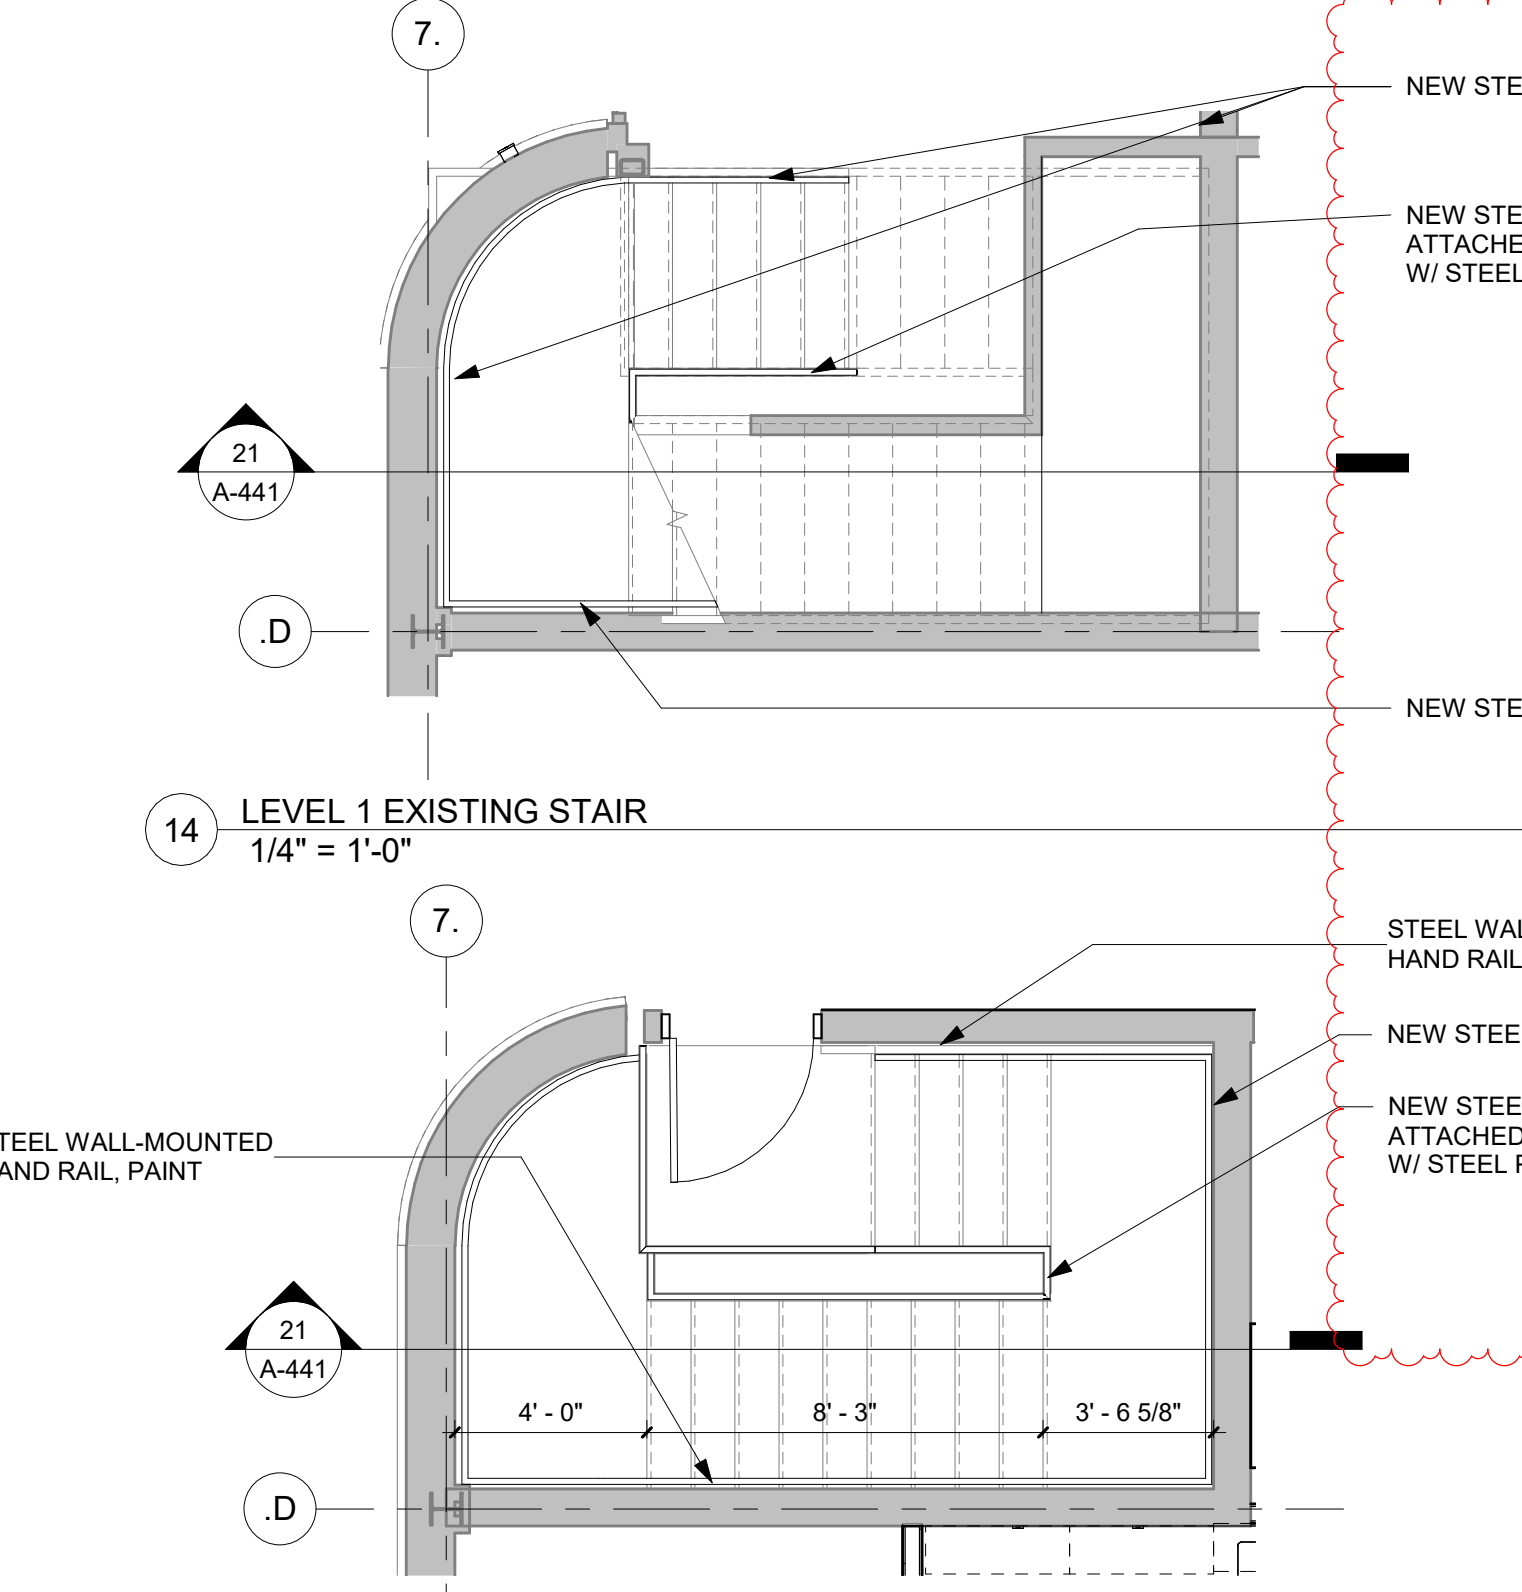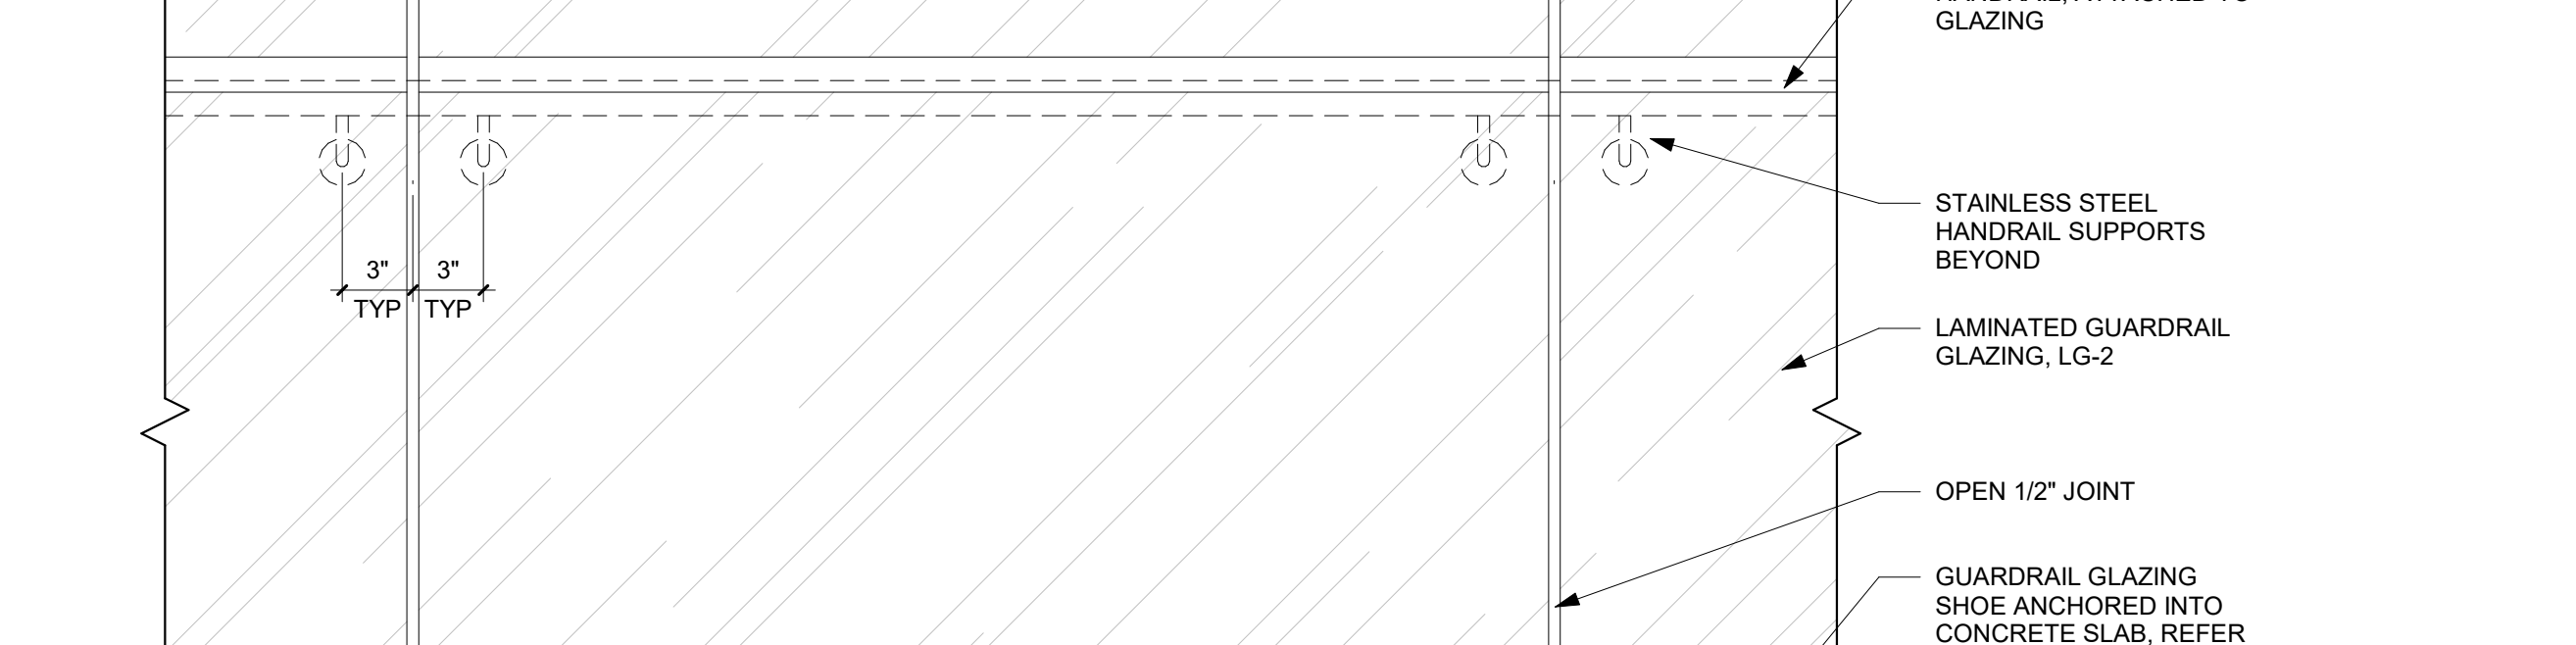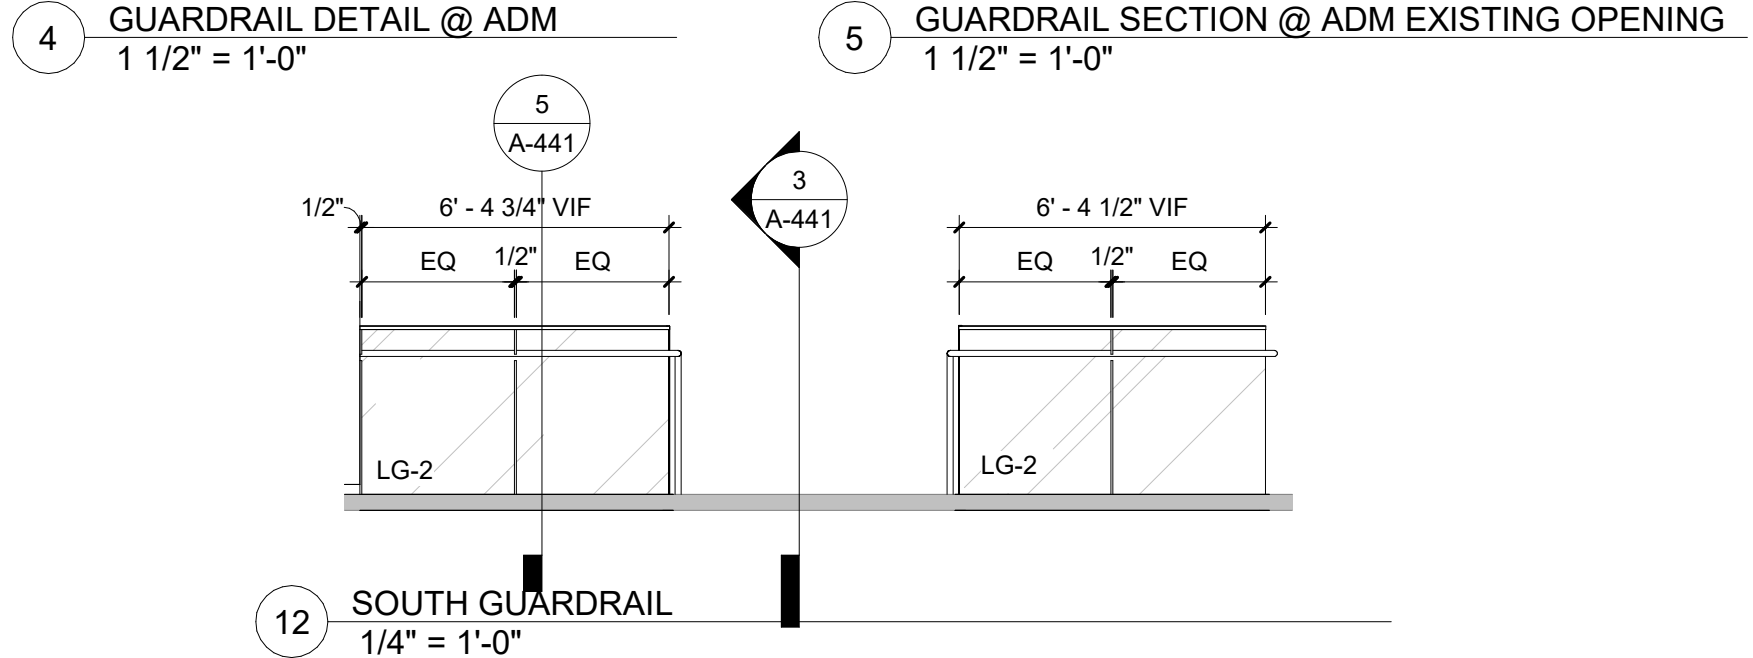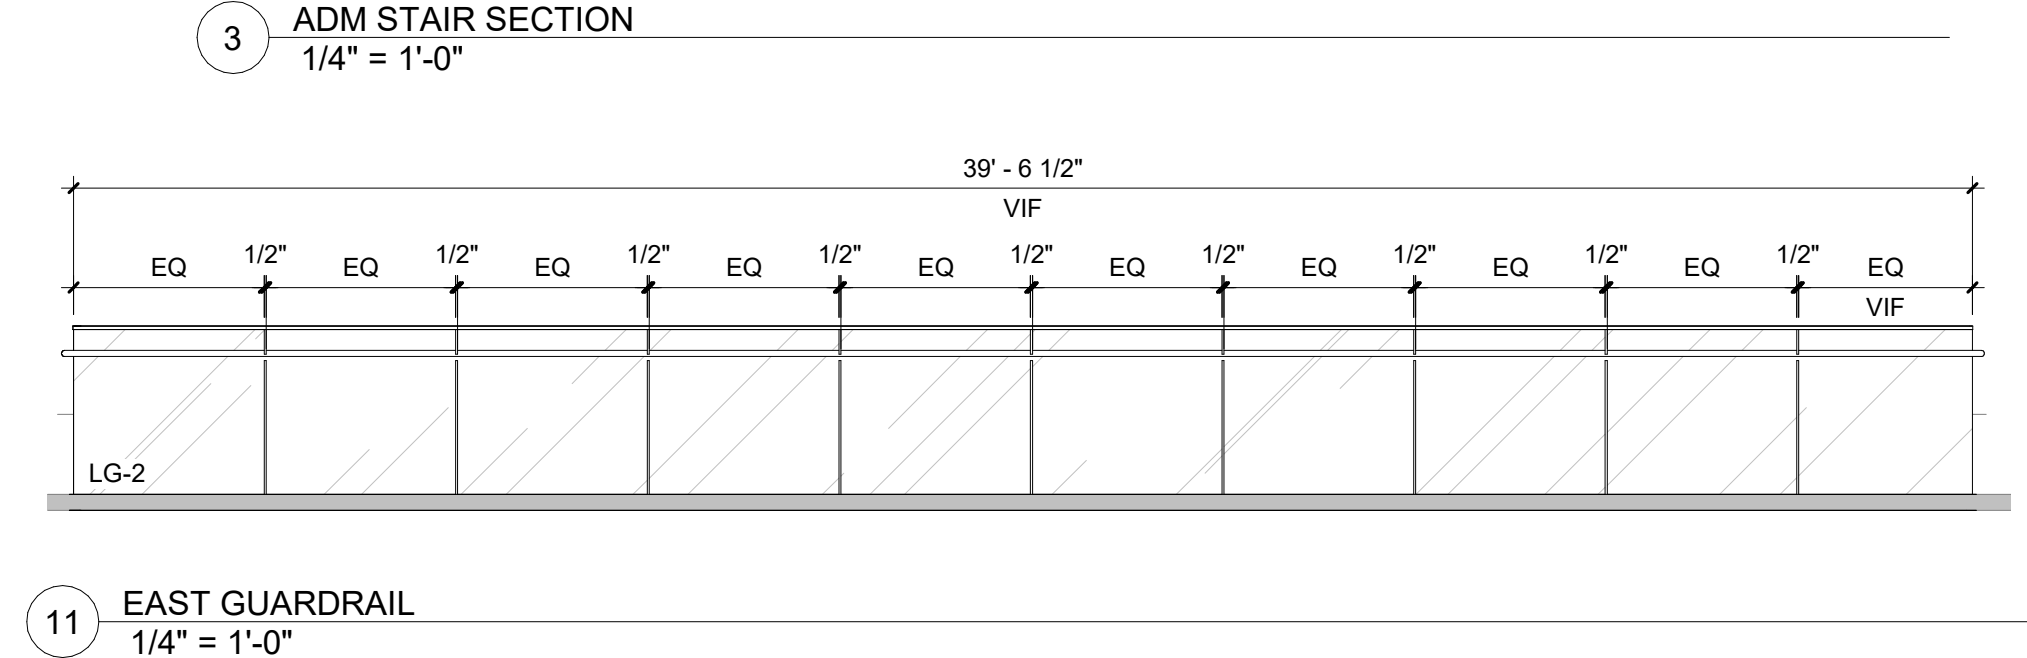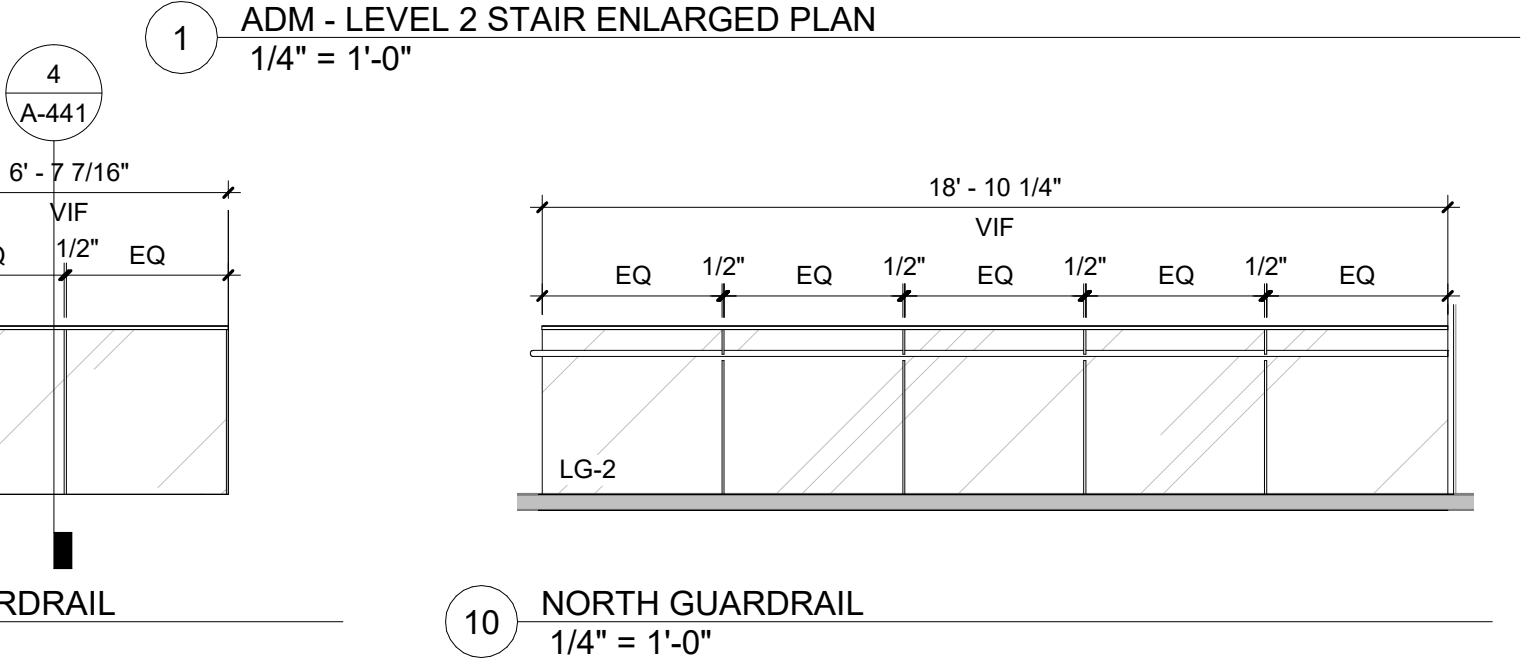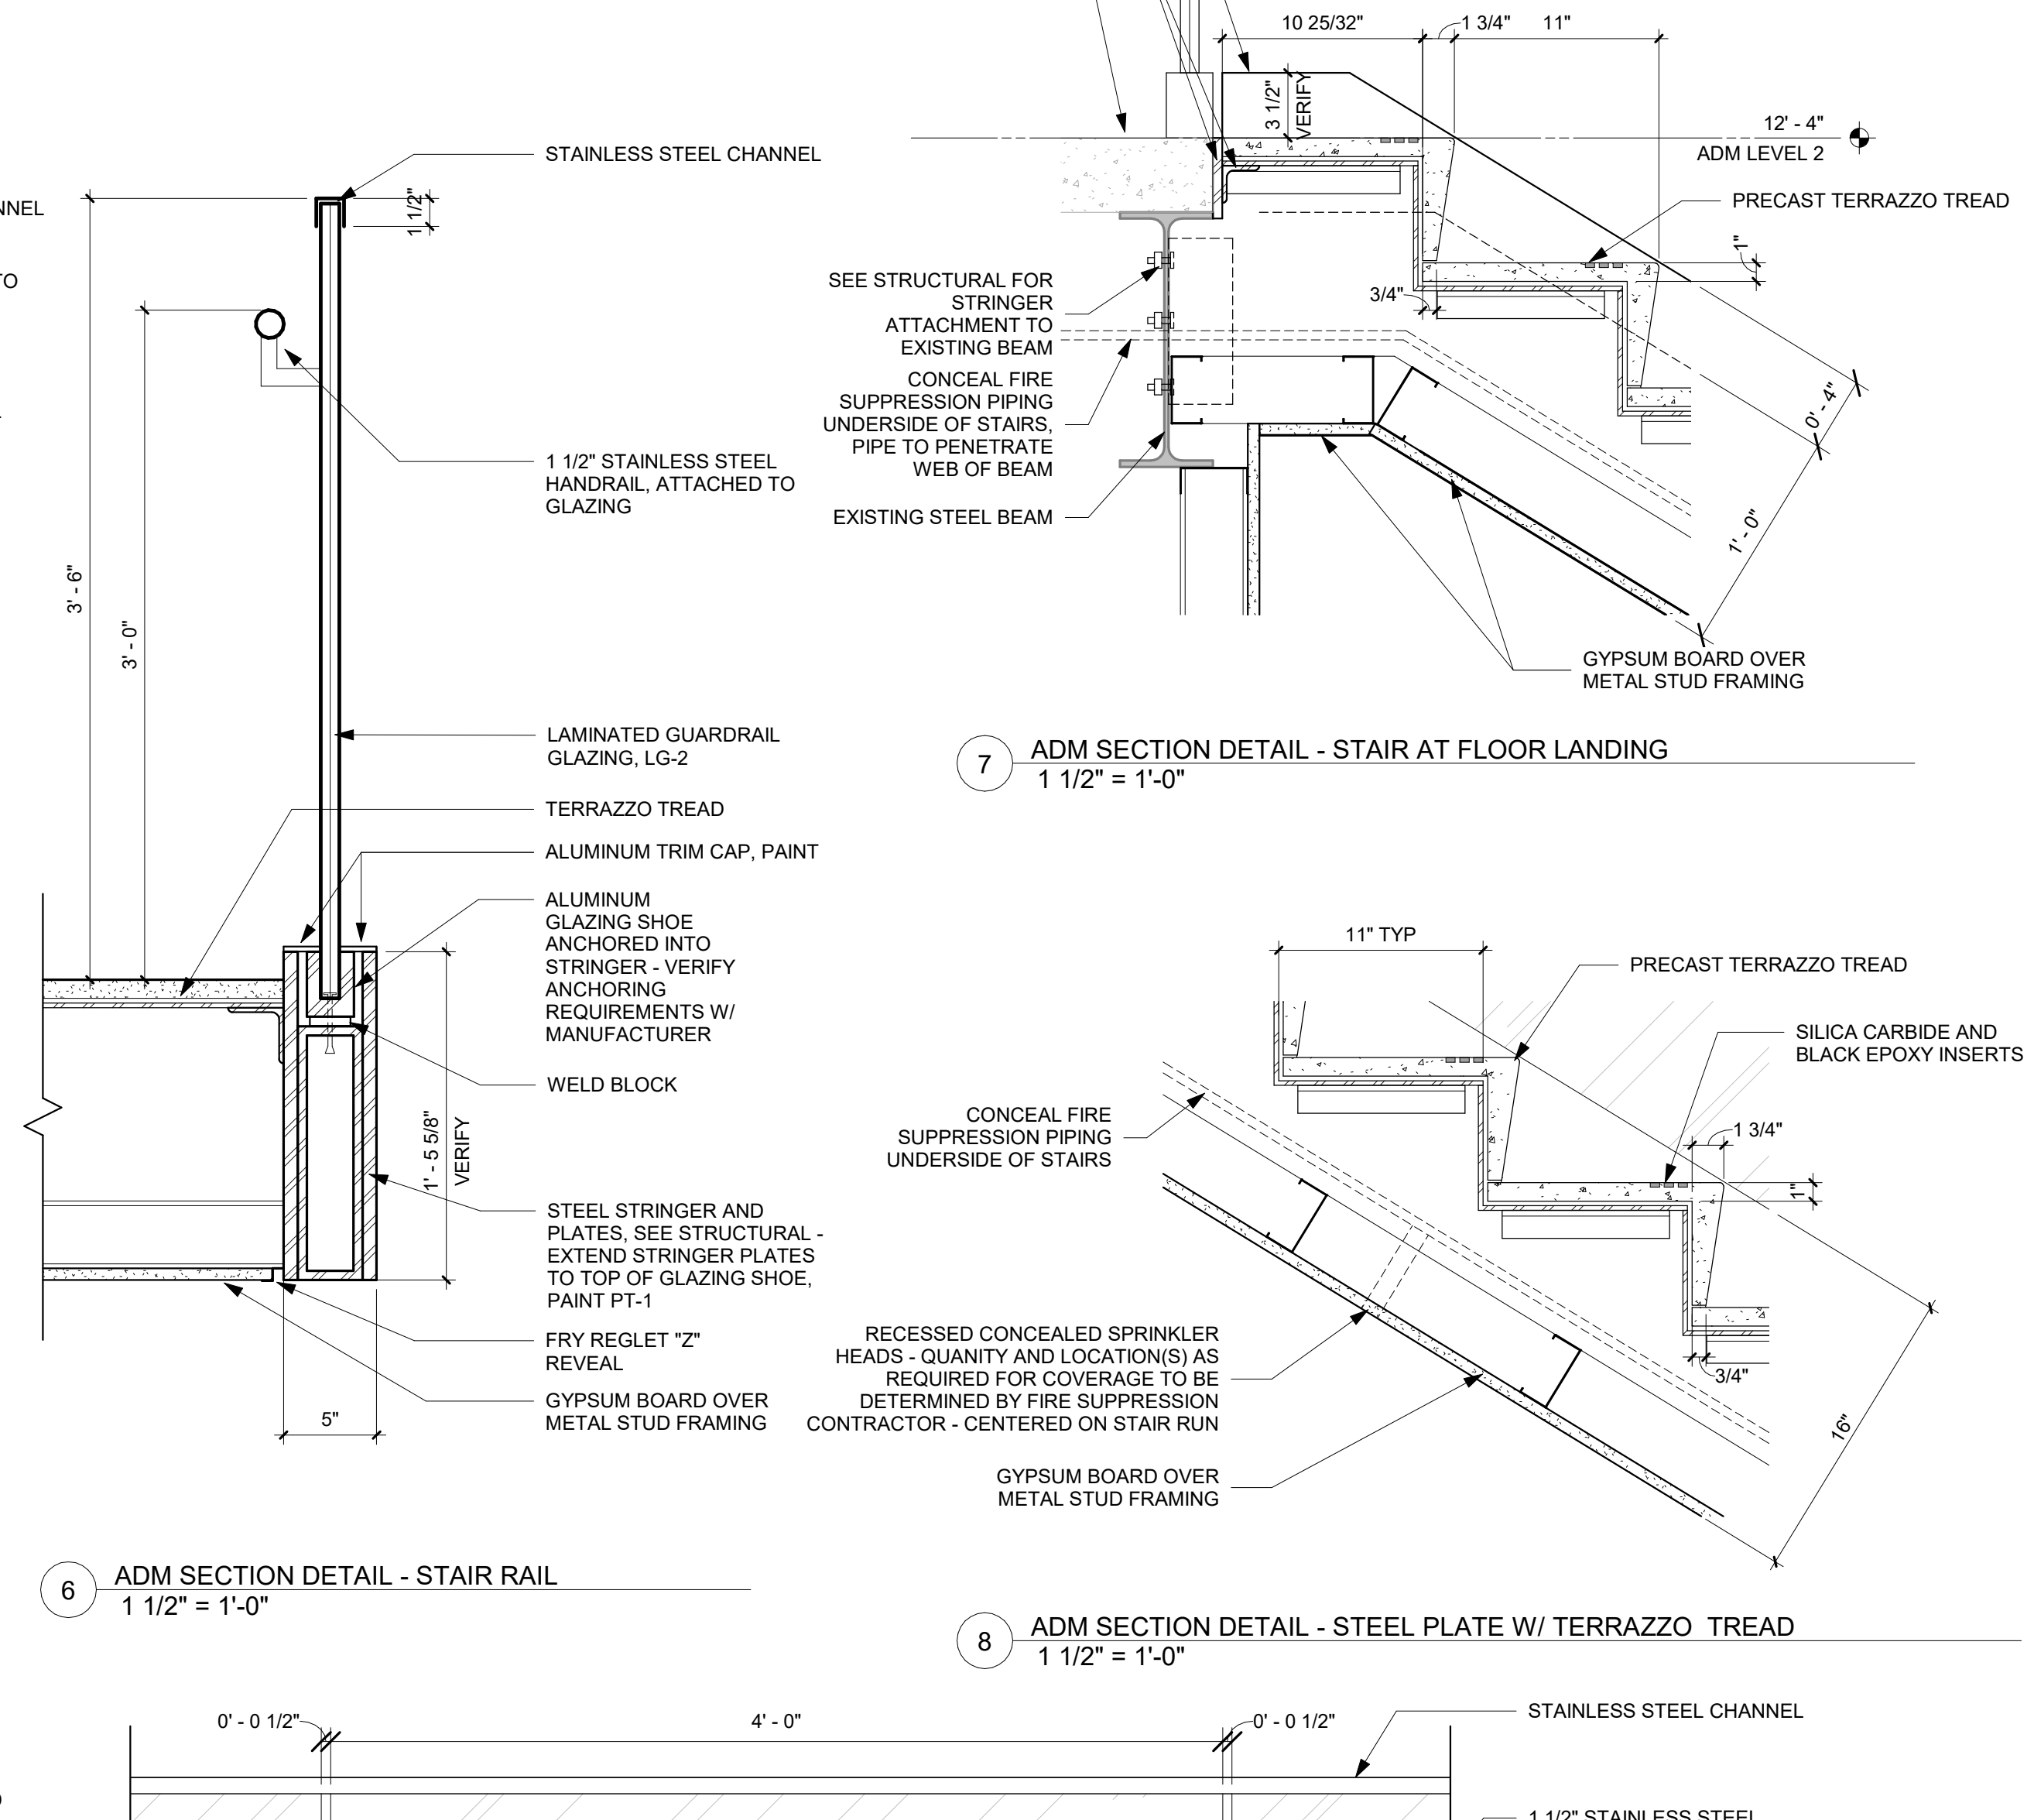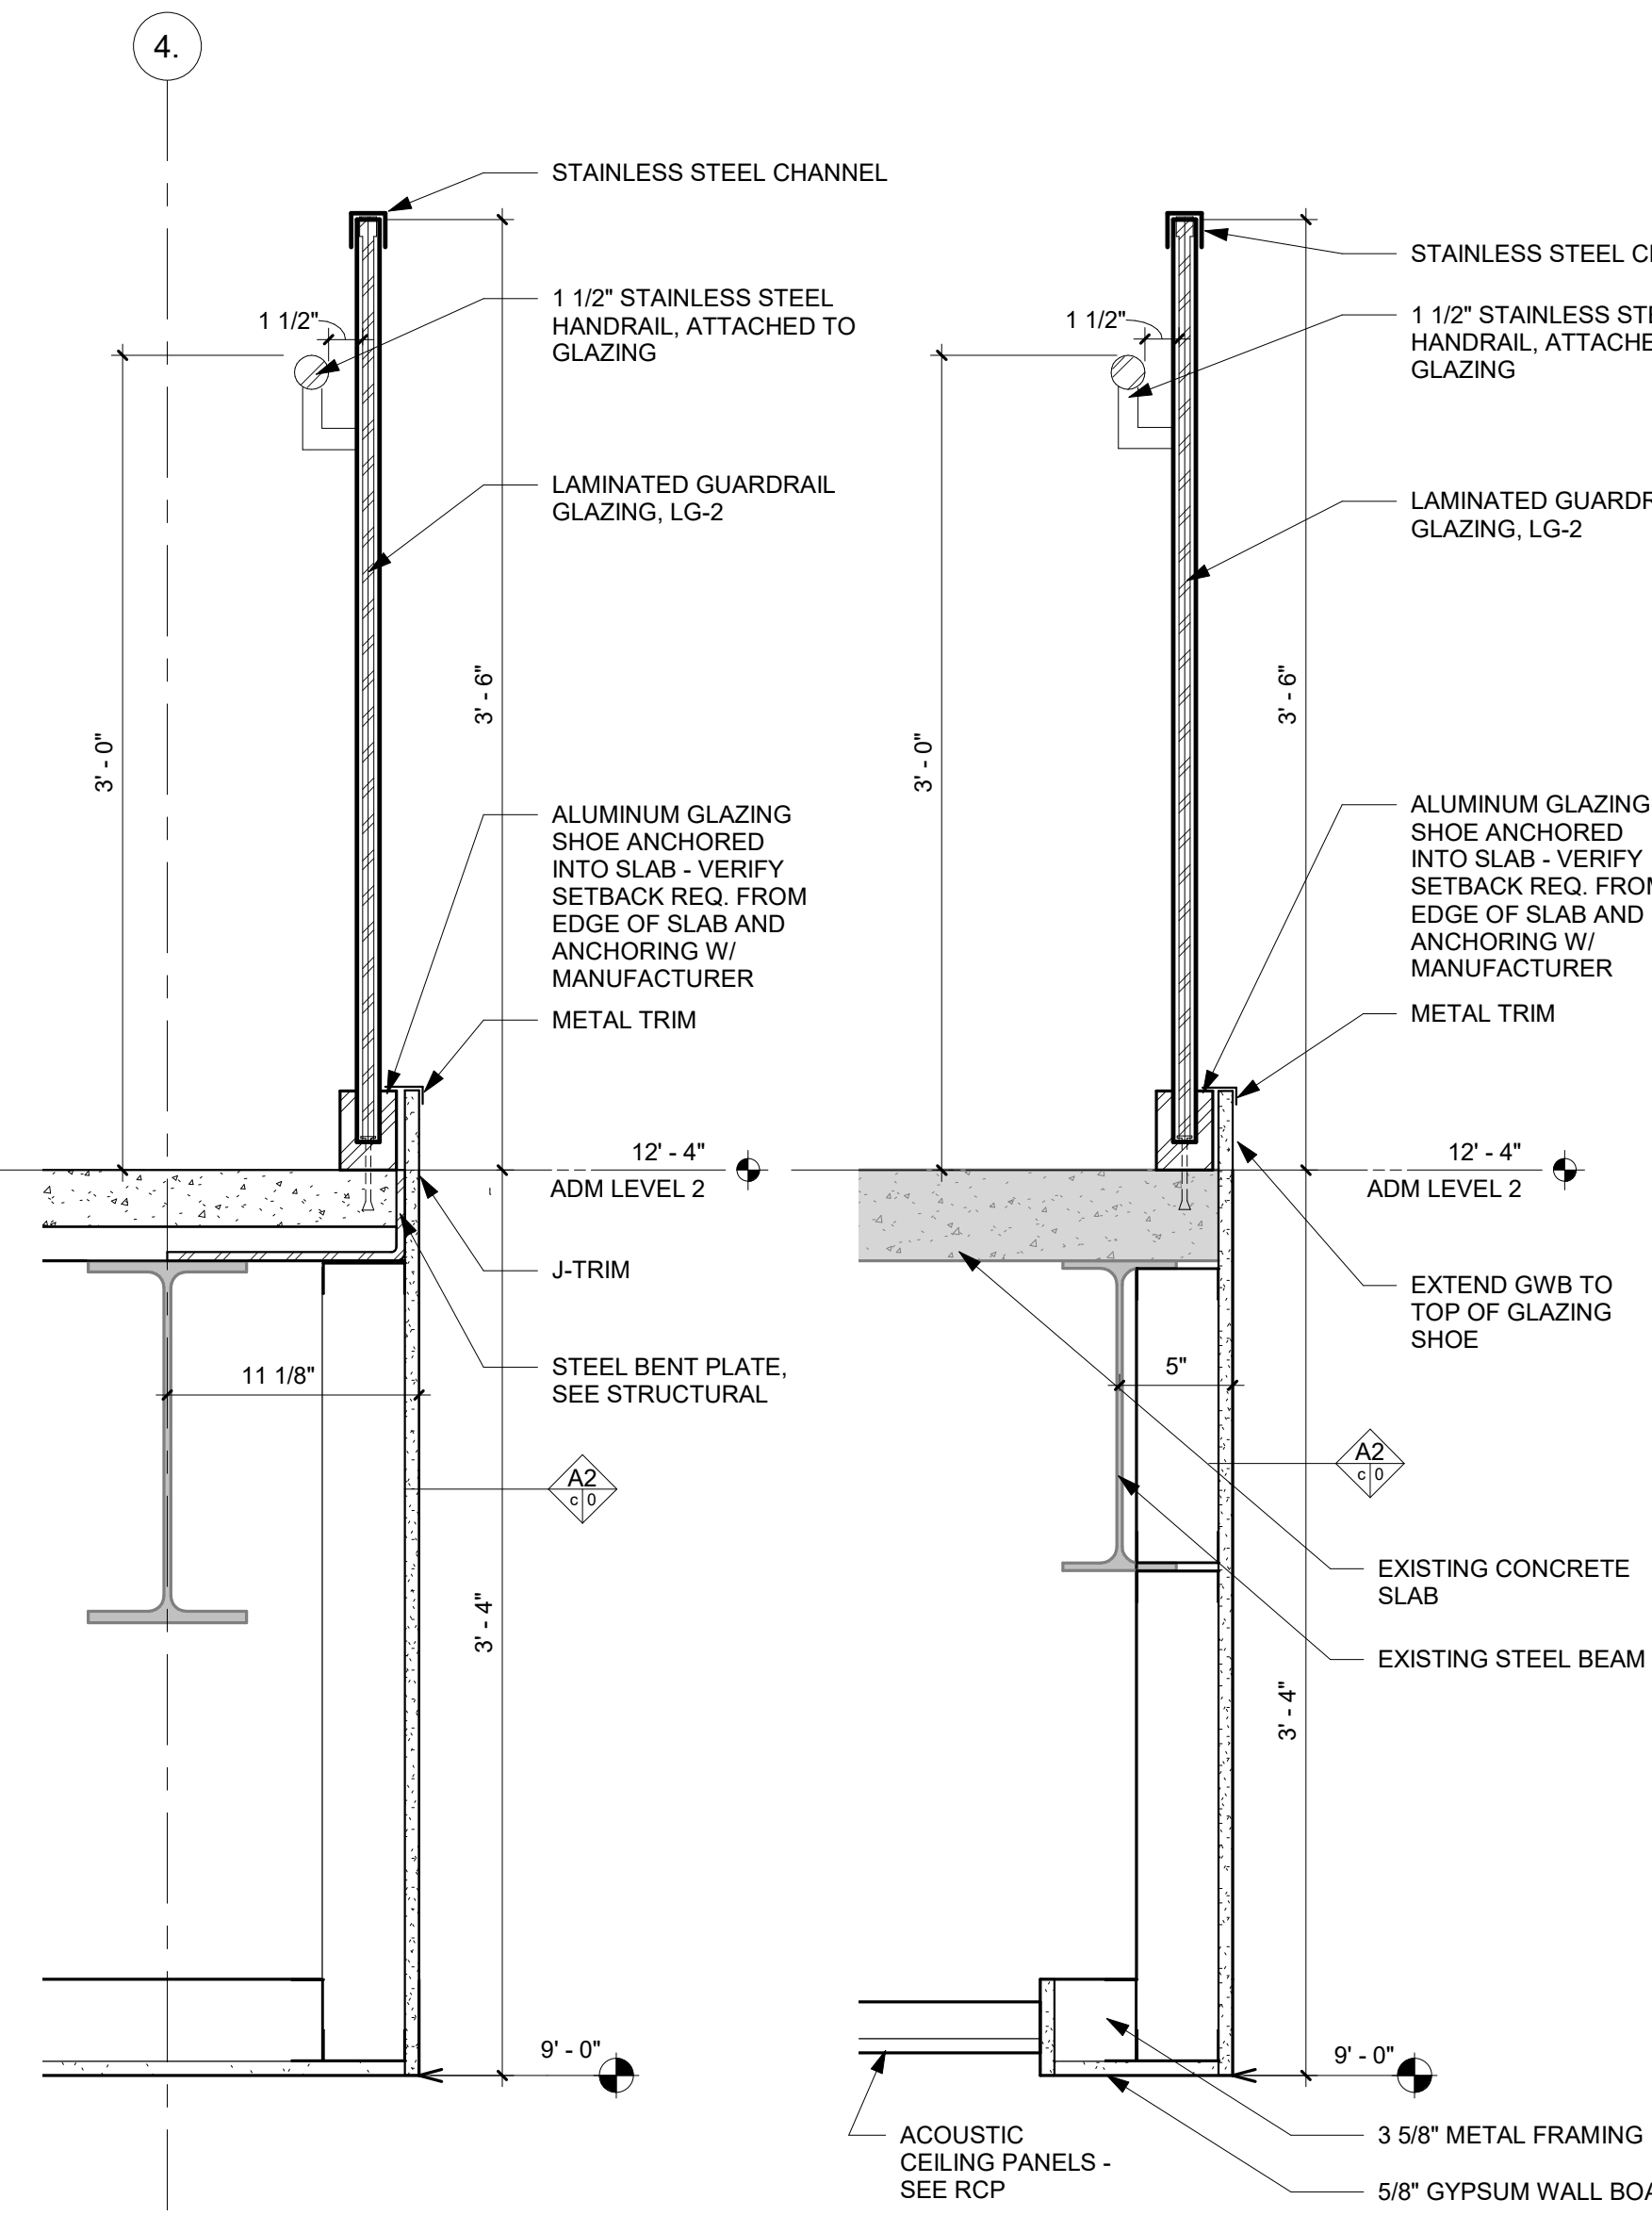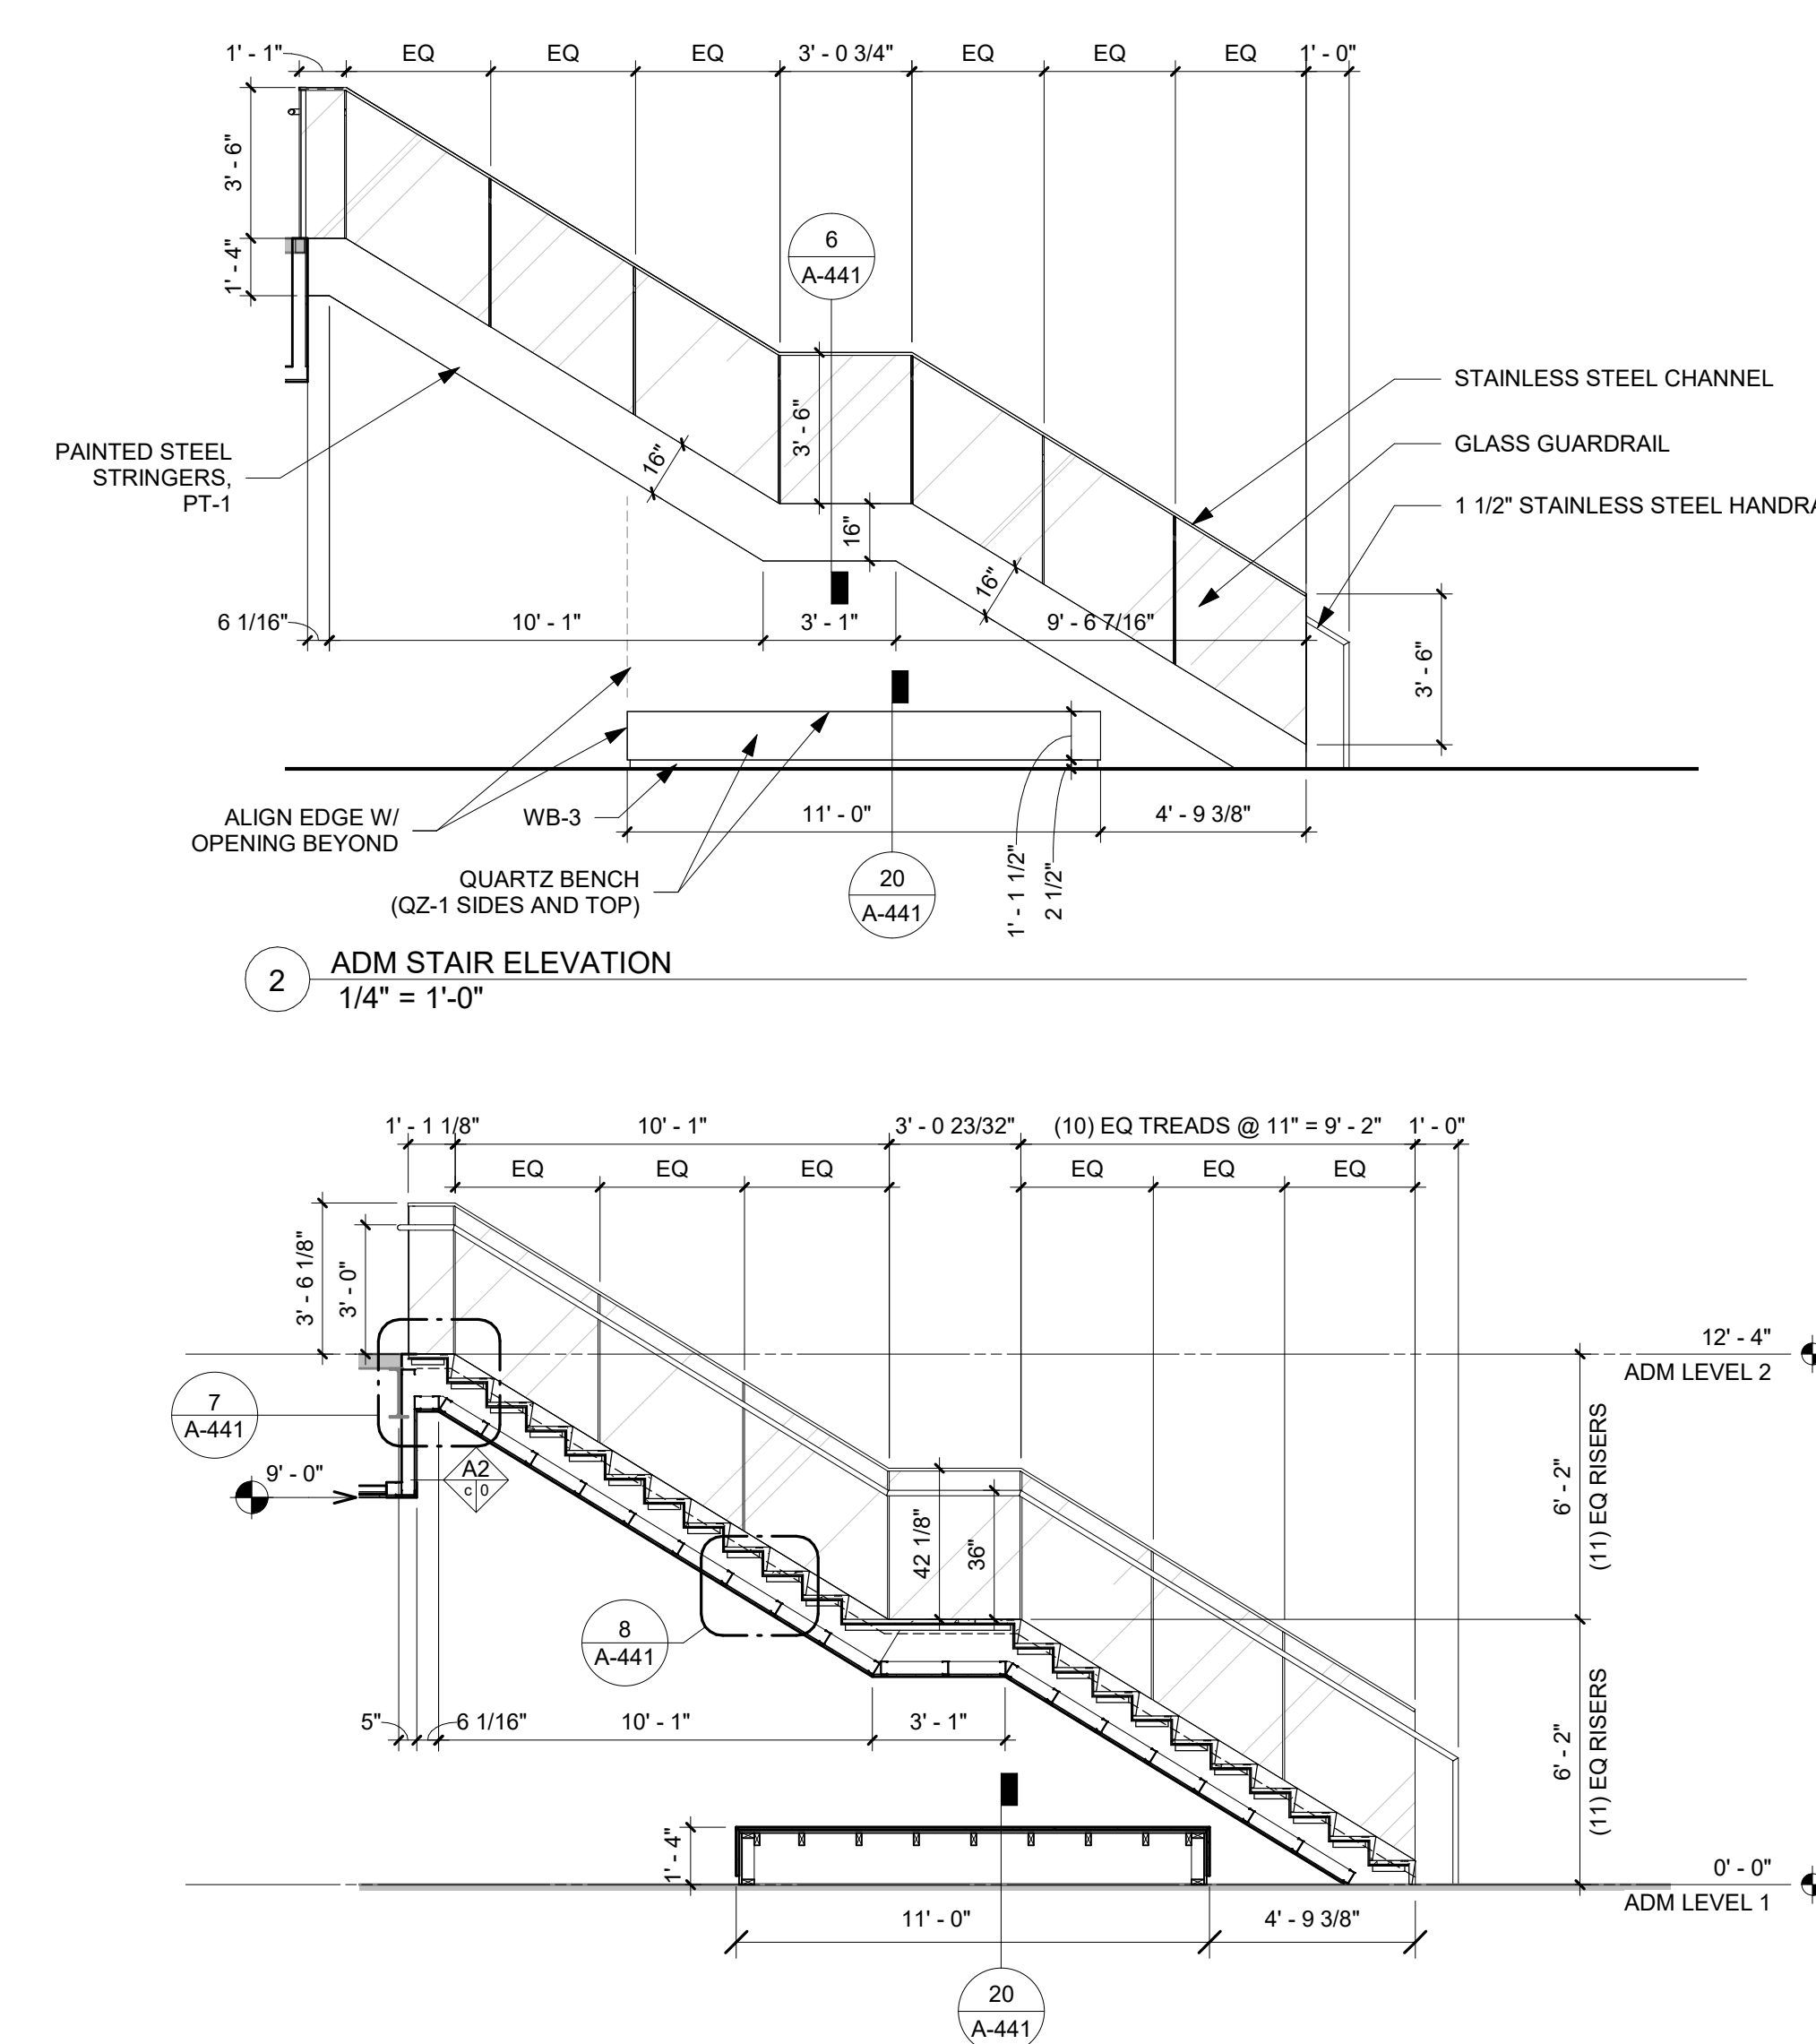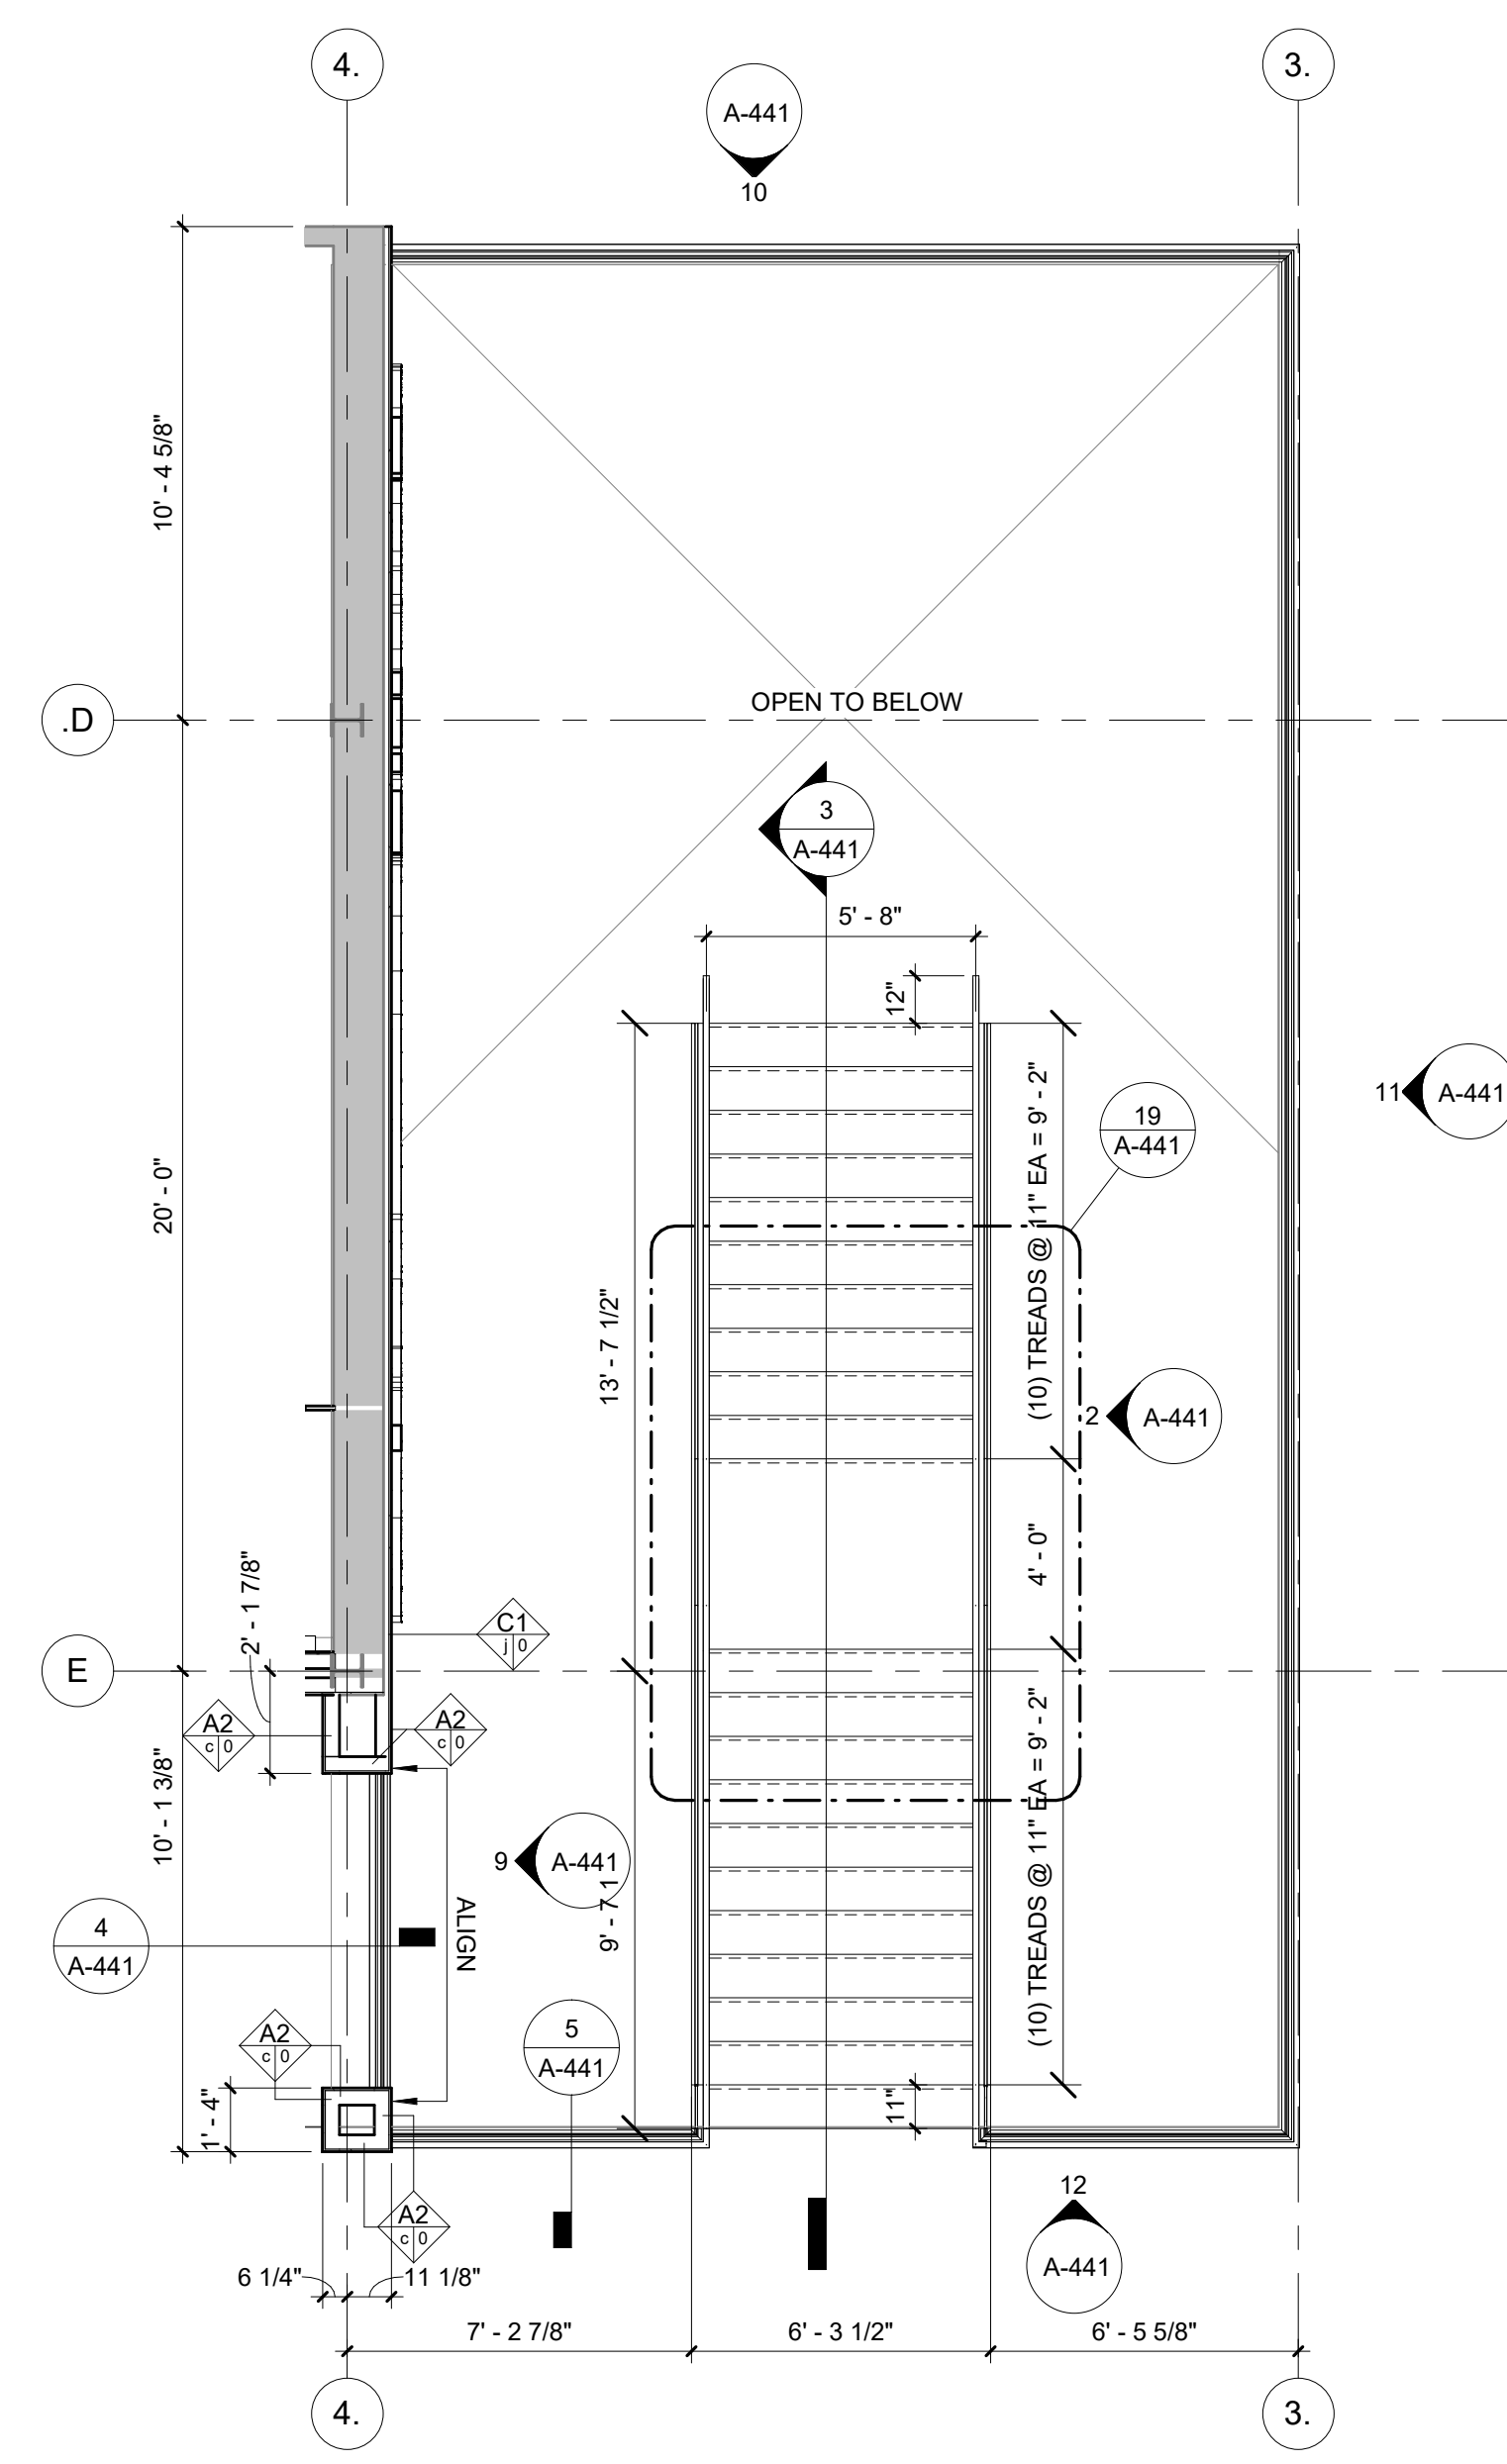

ROOM FINISH SCHEDULE - ADM									
Level	Number	ROOM NAME	FLOOR			WALL FINISH			CEILING MATERIAL
			FINISH	BASE	NORTH	EAST	SOUTH	WEST	
ADM LEVEL 1									
ADM LEVEL 1	100	VESTIBULE	WOG-1PCT-1	WB-3	PT-1	--	PT-1	--	OTAGWB
ADM LEVEL 1	101	LOBBY	PCT-1	WB-3	PT-1WD-2	PT-1	PT-1	PT-1	OTAGWB
ADM LEVEL 1	110	CONFERENCE	CPT-2.3.4	WB-3	PT-1	PT-1	PT-1	PT-1	AC-3-GWB
ADM LEVEL 1	113A	CLOSET	SC	WB-1	PT-1	PT-1	PT-1	PT-1	EX
ADM LEVEL 1	120	CONFERENCE	CPT-2.3.4	WB-3	PT-1	PT-1	PT-1	PT-1	AC-3-GWB
ADM LEVEL 1	130	OPEN OFFICE	CPT-2.4	WB-1	PT-1	PT-1	PT-1	PT-1	AC-3-GWB
ADM LEVEL 1	130A	OFFICE	CPT-2	WB-1	PT-1	PT-1	PT-1	PT-1	AC-3
ADM LEVEL 1	130B	OFFICE	CPT-2	WB-1	PT-1	PT-1	PT-1	PT-1	AC-3
ADM LEVEL 1	130C	OFFICE	CPT-2	WB-1	PT-1	PT-1	PT-1	PT-1	AC-3
ADM LEVEL 1	130D	SECURE STORAGE	SC	WB-1	PT-1	PT-1	PT-1	PT-1	AC-2
ADM LEVEL 1	130E	WORKROOM	RF-1	WB-1	PT-1	PT-1	PT-1	PT-1	AC-2
ADM LEVEL 1	141	STORAGE	SC	WB-1	PT-1	PT-1	PT-1	PT-1	OTS
ADM LEVEL 1	141A	VESTIBULE	WOM-1	WB-1	PT-1	PT-1	PT-1	PT-1	OTS
ADM LEVEL 1	141B	SECURE STORAGE	SC	WB-1	PT-1	PT-1	PT-1	PT-1	OTS
ADM LEVEL 1	142	FIRE SPRINKLER	SC	WB-1	PT-1	PT-1	PT-1	PT-1	OTS
ADM LEVEL 1	143	MECHANICAL	SC	WB-1	PT-1	PT-1	PT-1	PT-1	OTS
ADM LEVEL 1	144	CUST.	SC	WB-1	PT-1	PT-1	PT-1	PT-1	OTS
ADM LEVEL 1	145	RESTROOM	PCT-1	PCT-2B	PCT-2BPT-2	PCT-2BPT-2	PCT-2BPT-2	PCT-2BPT-2	GWB
ADM LEVEL 1	146	MENS RESTROOM	PCT-1	PCT-2A2B	PCT-2BPT-2	PCT-2BPT-2	PCT-2BPT-2	PCT-2BPT-2	GWB
ADM LEVEL 1	147	CUSTODIAN	SC	WB-1	PT-1	PT-1	PT-1	PT-1	OTS
ADM LEVEL 1	148	WOMENS RESTROOM	PCT-1	PCT-2A2B	PCT-2BPT-2	PCT-2BPT-2	PCT-2BPT-2	PCT-2BPT-2	GWB
ADM LEVEL 1	149	CORRIDOR	PCT-1	WB-3	PT-1WD-2	PT-1	PT-1	PT-1	GWB
ADM LEVEL 1	150	OFFICE	CPT-2.4	WB-1	PT-1	PT-1	PT-1	PT-1	AC-3-GWB
ADM LEVEL 1	150A	WORKROOM	RF-1	WB-1	PT-1	PT-1	PT-1	PT-1	AC-3
ADM LEVEL 1	150B	CONFERENCE	CPT-2	WB-1	PT-1	PT-1	PT-1	PT-1	AC-3
ADM LEVEL 1	150C	OFFICE	CPT-2	WB-1	PT-1	PT-1	PT-1	PT-1	AC-3
ADM LEVEL 1	150D	OFFICE	CPT-2	WB-1	PT-1	PT-1	PT-1	PT-1	AC-3
ADM LEVEL 1	150E	OFFICE	CPT-2	WB-1	PT-1	PT-1	PT-1	PT-1	AC-3
ADM LEVEL 1	150F	OFFICE	CPT-2	WB-1	PT-1	PT-1	PT-1	PT-1	AC-3
ADM LEVEL 1	150G	OFFICE	CPT-2	WB-1	PT-1	PT-1	PT-1	PT-1	AC-3
ADM LEVEL 1	150H	OFFICE	CPT-2	WB-1	PT-1	PT-1	PT-1	PT-1	AC-3
ADM LEVEL 1	150I	OFFICE	CPT-2	WB-1	PT-1	PT-1	PT-1	PT-1	AC-3
ADM LEVEL 1	150J	OFFICE	CPT-2	WB-1	PT-1	PT-1	PT-1	PT-1	AC-3
ADM LEVEL 1	155	VESTIBULE	WOG-1PCT-1	WB-3	PT-1	PT-1	PT-1	PT-1	GWB
ADM LEVEL 1	S2-1	STAIR 2	PCT-1	WB-3	PT-1	PT-1	PT-1	PT-1	OTS
ADM LEVEL 2									
ADM LEVEL 2	210	OPEN OFFICE	CPT-2.4	WB-1	PT-1	PT-1	PT-1	PT-1	AC-3-GWB
ADM LEVEL 2	210A	OFFICE	CPT-2.4	WB-1	PT-1	PT-1	PT-1	PT-1	AC-3
ADM LEVEL 2	220	OPEN OFFICE	CPT-2.4	WB-1	PT-1	PT-1	PT-1	PT-1	AC-3-GWB
ADM LEVEL 2	220A	OFFICE	CPT-2	WB-1	PT-1	PT-1	PT-1	PT-1	AC-3
ADM LEVEL 2	220B	OFFICE	CPT-2	WB-1	PT-1	PT-1	PT-1	PT-1	AC-3
ADM LEVEL 2	220C	OFFICE	CPT-2	WB-1	PT-1	PT-1	PT-1	PT-1	AC-3
ADM LEVEL 2	220D	OFFICE	CPT-2	WB-1	PT-1	PT-1	PT-1	PT-1	AC-3
ADM LEVEL 2	220E	OFFICE	CPT-2	WB-1	PT-1	PT-1	PT-1	PT-1	AC-3
ADM LEVEL 2	220F	OFFICE	CPT-2	WB-1	PT-1	PT-1	PT-1	PT-1	AC-3
ADM LEVEL 2	230	OPEN OFFICE	CPT-2.4	WB-1	PT-1	PT-1	PT-1	PT-1	AC-3-GWB
ADM LEVEL 2	230A	OFFICE	CPT-2	WB-1	PT-1	PT-1	PT-1	PT-1	AC-3
ADM LEVEL 2	230B	OFFICE	CPT-2	WB-1	PT-1	PT-1	PT-1	PT-1	AC-3
ADM LEVEL 2	230C	OFFICE	CPT-2	WB-1	PT-1	PT-1	PT-1	PT-1	AC-3
ADM LEVEL 2	231	CORRIDOR	PCT-1	WB-3	PT-1	--	PT-1WD-2	PT-1	OTAGWB
ADM LEVEL 2	232	MECH ACCESS	SC	WB-1	PT-1	PT-1	PT-1	PT-1	OTS
ADM LEVEL 2	240	OPEN OFFICE	CPT-2.4	WB-1	PT-1	PT-1	PT-1	PT-1	AC-3
ADM LEVEL 2	240A	WORKROOM	CPT-2.4	WB-1	PT-1	PT-1	PT-1	PT-1	AC-3
ADM LEVEL 2	240B	OFFICE	CPT-2	WB-1	PT-1	PT-1	PT-1	PT-1	AC-3
ADM LEVEL 2	240C	OFFICE	CPT-2	WB-1	PT-1	PT-1	PT-1	PT-1	AC-3
ADM LEVEL 2	240D	OFFICE	CPT-2	WB-1	PT-1	PT-1	PT-1	PT-1	AC-3
ADM LEVEL 2	240E	OFFICE	CPT-2	WB-1	PT-1	PT-1	PT-1	PT-1	AC-3
ADM LEVEL 2	240F	OFFICE	CPT-2	WB-1	PT-1	PT-1	PT-1	PT-1	AC-3
ADM LEVEL 2	240G	STORAGE	CPT-2	WB-1	PT-1	PT-1	PT-1	PT-1	AC-2
ADM LEVEL 2	240H	SMALL CONFERENCE	CPT-2.4	WB-1	PT-1	PT-1	PT-1	PT-1	AC-4
ADM LEVEL 2	241	CORRIDOR	PCT-1	WB-3	--	PT-1	PT-1	PT-1	AC-1
ADM LEVEL 2	241A	MOMS ROOM	RF-1	WB-1	VWC-2B	VWC-2A	VWC-2A	VWC-2A	AC-3
ADM LEVEL 2	242	BREAKROOM	WB-1	PT-1PCT-3	PT-1PCT-3	PT-1	PT-1	PT-1	AC-2
ADM LEVEL 2	242A	TELECOM	SC	WB-1	PT-1	PT-1	PT-1	PT-1	OTS
ADM LEVEL 2	244	RESTROOM	PCT-1	PCT-2B	PCT-2BPT-2	PCT-2BPT-2	PCT-2BPT-2	PCT-2BPT-2	GWB
ADM LEVEL 2	245	CONFERENCE	CPT-2.4	WB-1	PT-1	PT-1	PT-1	PT-1	AC-4
ADM LEVEL 2	246	MENS RESTROOM	PCT-1	PCT-2A2B	PCT-2BPT-2	PCT-2BPT-2	PCT-2APT-2	GWB	PT-1
ADM LEVEL 2	247	CUSTODIAN	SC	WB-1	PT-1	PT-1FRP	PT-1FRP	PT-1	OTS
ADM LEVEL 2	248	WOMENS RESTROOM	PCT-1	PCT-2A2B	PCT-2BPT-2	PCT-2BPT-2	PCT-2BPT-2	PCT-2BPT-2	GWB
ADM LEVEL 2	249	STAIRS	PCT-1	WB-3	PT-1	PT-1	PT-1	PT-1	AC-2
ADM LEVEL 2	250	OPEN OFFICE	CPT-2.4	WB-1	PT-1	PT-1	PT-1	PT-1	AC-3
ADM LEVEL 2	250A	RECEPTION	CPT-2.4	WB-1	PT-1	PT-1	PT-1	PT-1	AC-3
ADM LEVEL 2	250B	WORKROOM	CPT-2	WB-1	PT-1	PT-1	PT-1	PT-1	AC-3
ADM LEVEL 2	250C	OFFICE	CPT-2	WB-1	PT-1	PT-1	PT-1	PT-1	AC-3
ADM LEVEL 2	250D	OFFICE	CPT-2	WB-1	PT-1	PT-1	PT-1	PT-1	AC-3
ADM LEVEL 2	250E	OFFICE	CPT-2	WB-1	PT-1	PT-1	PT-1	PT-1	AC-3
ADM LEVEL 2	250F	OFFICE	CPT-2	WB-1	PT-1	PT-1	PT-1	PT-1	AC-3
ADM LEVEL 2	250G	CONFERENCE	CPT-2	WB-1	PT-1	PT-1	PT-1	PT-1	AC-4
ADM LEVEL 2	250H	OFFICE	CPT-2	WB-1	PT-1	PT-1	PT-1	PT-1	AC-3
ADM LEVEL 2	250J	OFFICE	CPT-2	WB-1	PT-1	PT-1	PT-1	PT-1	AC-3
ADM LEVEL 2	250K	OFFICE	CPT-2	WB-1	PT-1	PT-1	PT-1	PT-1	AC-3
ADM LEVEL 2	250L	OFFICE	CPT-2	WB-1	PT-1	PT-1	PT-1	PT-1	AC-3
ADM LEVEL 2	250M	OFFICE	CPT-2	WB-1	PT-1	PT-1	PT-1	PT-1	AC-3
ADM LEVEL 2	250N	OFFICE	CPT-2	WB-1	PT-1	PT-1	PT-1	PT-1	AC-3
ADM LEVEL 2	251	ELEV	WOM-1	--	PLAM-1	PLAM-1	PLAM-1	PLAM-1	--
ADM LEVEL 2	256	CORRIDOR	PCT-1	WB-3	PT-1WD-2	--	PT-1	--	OTAGWB/AC-1

ACOUSTICAL CEILING PANELS

ACP-1: MANUFACTURER: ARMSTRONG

STYLE: CALA

SIZE: 24" X 72"

GRID TYPE: PRELUDE XL

EDGE PROFILE: BEVELED REGULAR 15/16

COLOR: WHITE

APPLICATION: LARGE FORMAT AT PUBLIC SPACES

ACP-2: MANUFACTURER: ARMSTRONG

STYLE: CANYON

SIZE: 24" X 24"

GRID TYPE: PRELUDE XL

EDGE PROFILE: BEVELED REGULAR 15/16

COLOR: WHITE

MANUFACTURER: USG

STYLE: MARS HIGH NRC (88135)

SIZE: 24" X 24"

GRID TYPE: DOWN BRAND DX

EDGE PROFILE: BEVELED REGULAR 15/16

COLOR: WHITE

APPLICATION: OFFICES

ACP-4: MANUFACTURER: ARMSTRONG

STYLE: CALA HIGH NRC

SIZE: 24" X 24"

GRID TYPE: PRELUDE XL

EDGE PROFILE: SQUARE REGULAR 15/16

COLOR: WHITE

MANUFACTURER: USG

STYLE: MARS HIGH NRC (88138)

SIZE: 24" X 24"

GRID TYPE: DOWN BRAND DX

EDGE PROFILE: BEVELED REGULAR 15/16

COLOR: WHITE

APPLICATION: CONFERENCE & MEETING ROOMS

ACOUSTICAL WALL PANELS

AWP-2: MANUFACTURER: ARMSTRONG

PRODUCT: ACoustiBUILT

SIZE: 48" X 96" X 7/8"

FINISH: FINE TEXTURE FINISH

BY MFR TO MATCH PT-1

MANUFACTURER: USG

PRODUCT: ENSEMBLE

SIZE: 48" X 96" X 7/8"

FINISH: FINE TEXTURE FINISH

BY MFR TO MATCH PT-1

CARPET

CPT-1: NOT USED

CPT-2: MANUFACTURER: PATCRRAFT

STYLE: REACT

COLOR: ARTFULLY RUSTED

SIZE: 12" X 48"

APPLICATION: ADM & HHS - SEE FINISH PLANS

CPT-3: MANUFACTURER: PATCRRAFT

STYLE: ETCHED

COLOR: ARTFULLY RUSTED

SIZE: 12" X 48"

APPLICATION: ADM & HHS - SEE FINISH PLANS

CPT-4: MANUFACTURER: PATCRRAFT

STYLE: PATINA

COLOR: ARTFULLY RUSTED

SIZE: 12" X 48"


APPLICATION: ADM & HHS - SEE FINISH PLANS

CPT-5: MANUFACTURER: INTERFACE

STYLE: SL80

COLOR: GRAPHITE FADE

SIZE: 25 CM X 1 M

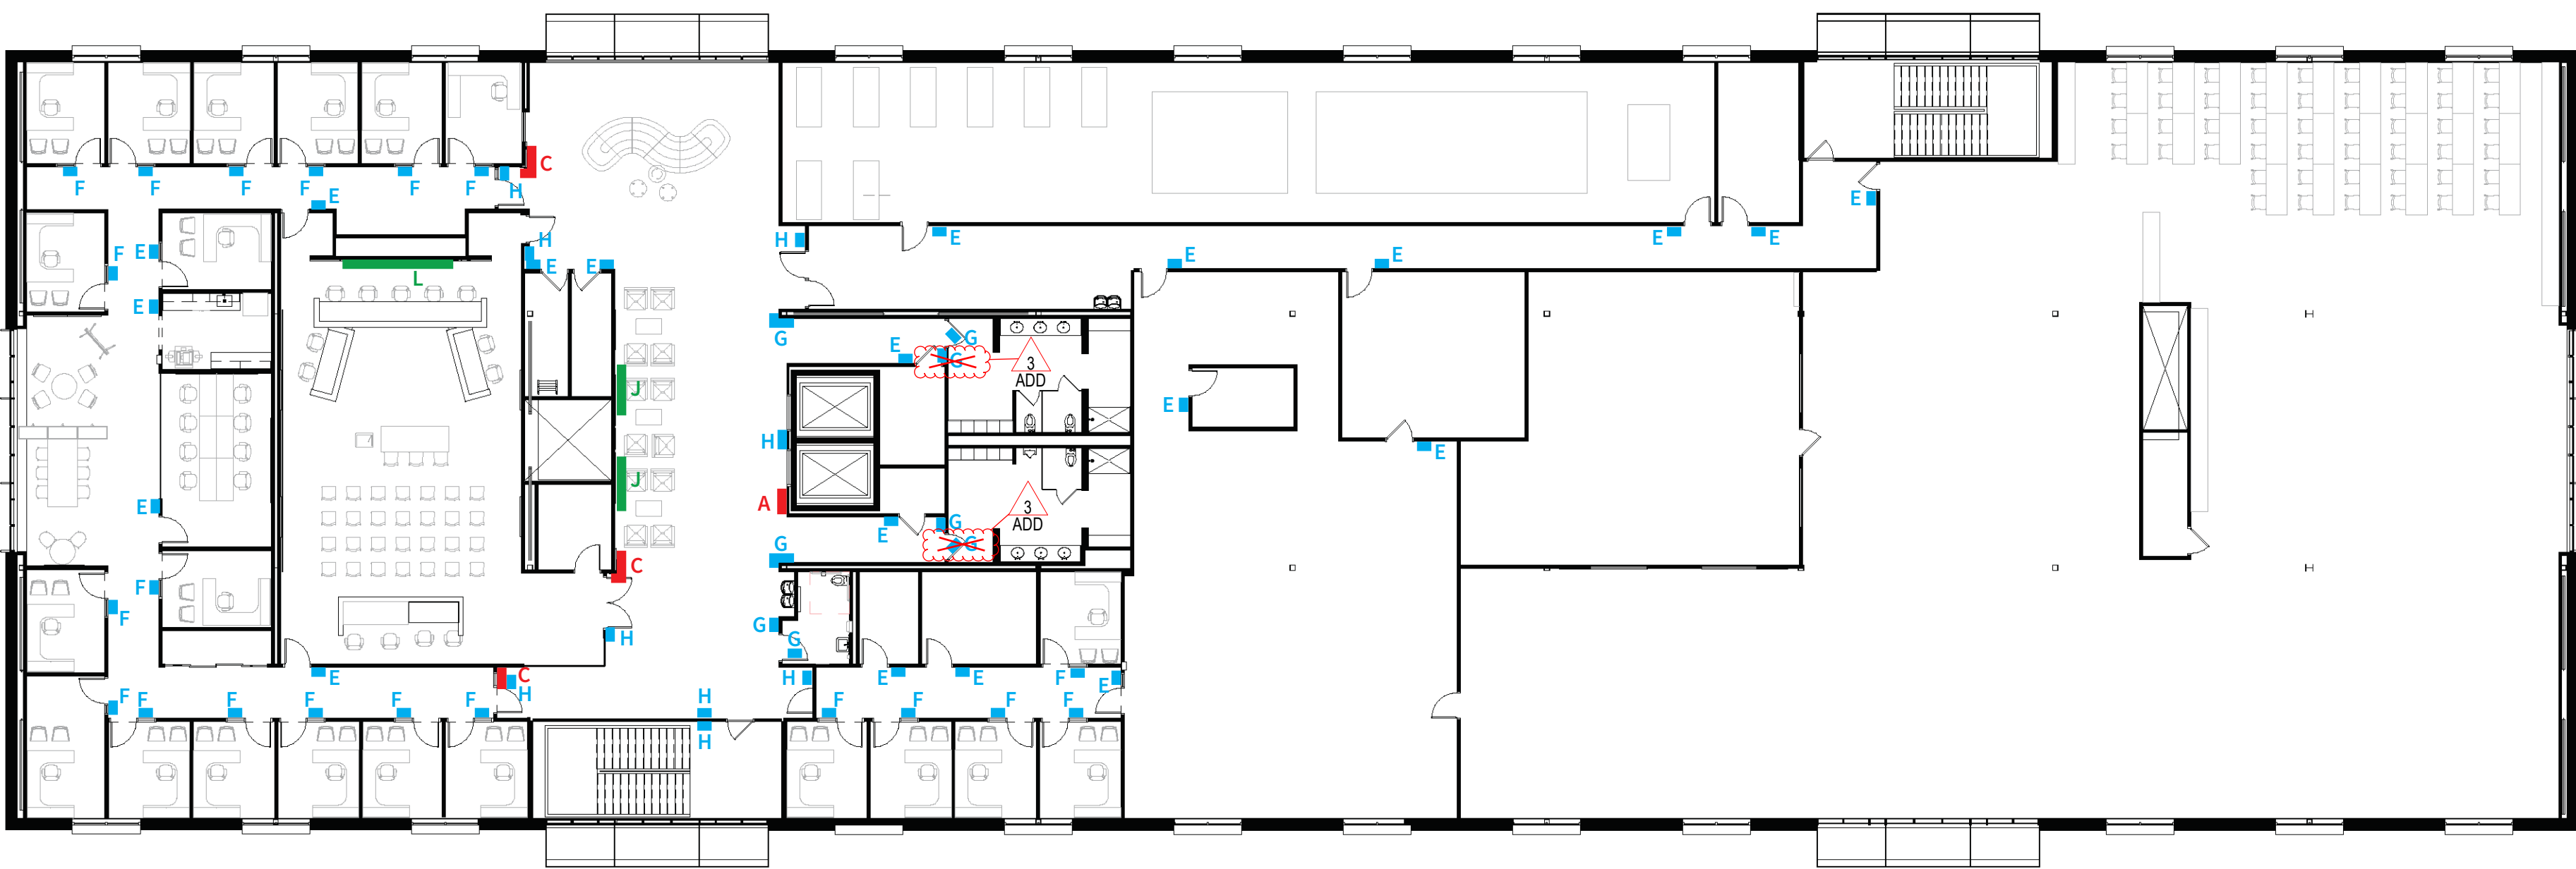

3 HHS - LEVEL 3 FLOORPLAN
1/16" = 1'-0"

Sign Location Plans

Legend

WAYFINDING

Directories, Directional, and Destination signs to aid building navigation and identify departments.

Sign Types:

- A: DIRECTORY
- B: DIRECTIONAL
- C: DEPARTMENT
- D: OVERHEAD

ROOM SIGN (ADA)

Basic room signs with ADA compliant raised lettering and braille;

Sign Types:


- E: ROOM IDENTIFICATION
- F: OFFICE (name insert)
- G: RESTROOM
- H: REGULATORY

FEATURE MURAL/GRAPHICS


Themed Iowa/Johnson County printed images, graphics, or text onto material substrates such as fabric, aluminum, pvc, vinyl, or wallpaper.

Sign Types:

- I: INTERPRETIVE
- J: IMAGE PANELS
- K: PRIVACY VINYL
- L: DIMENSIONAL LETTERS

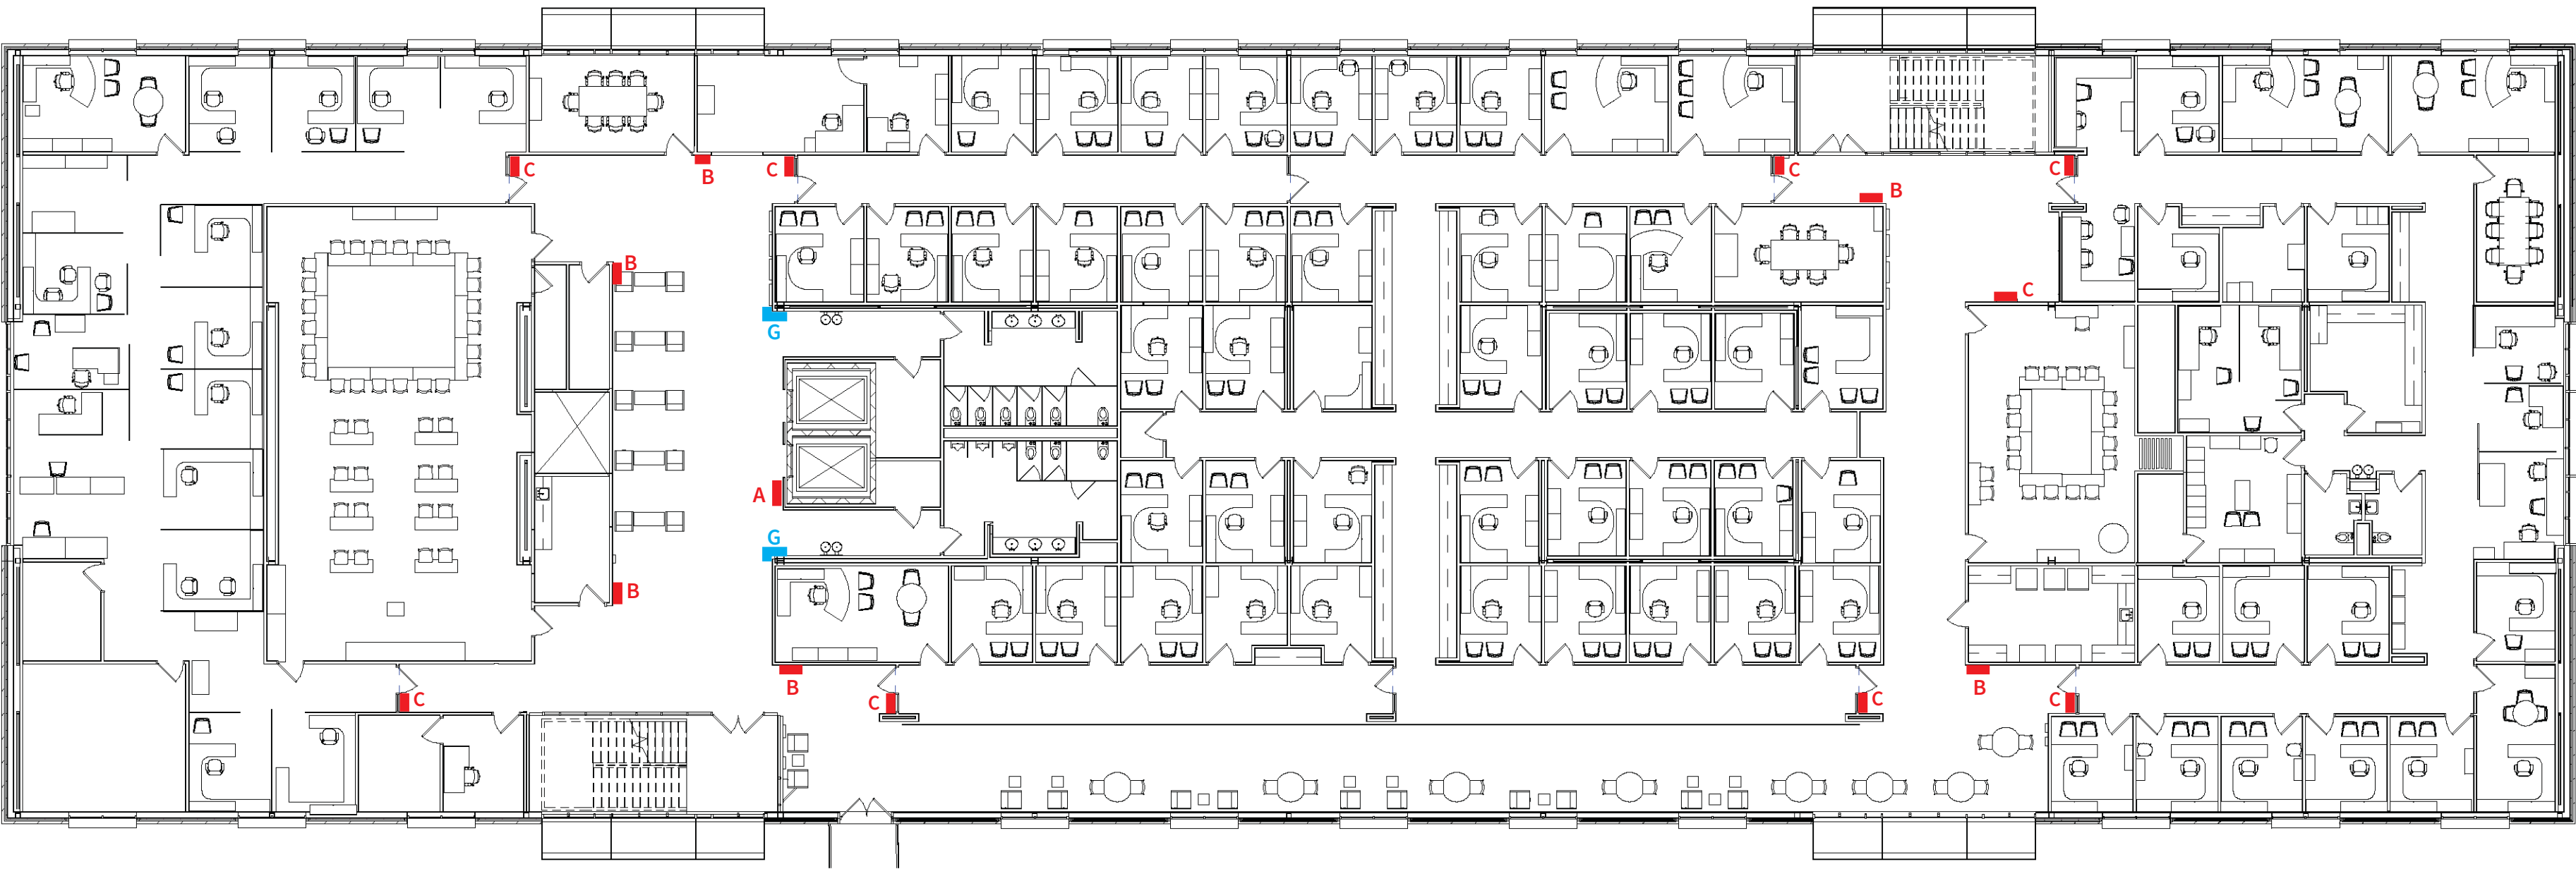


2 HHS EXISTING - LEVEL 2 FLOORPLAN
1/16" = 1'-0"

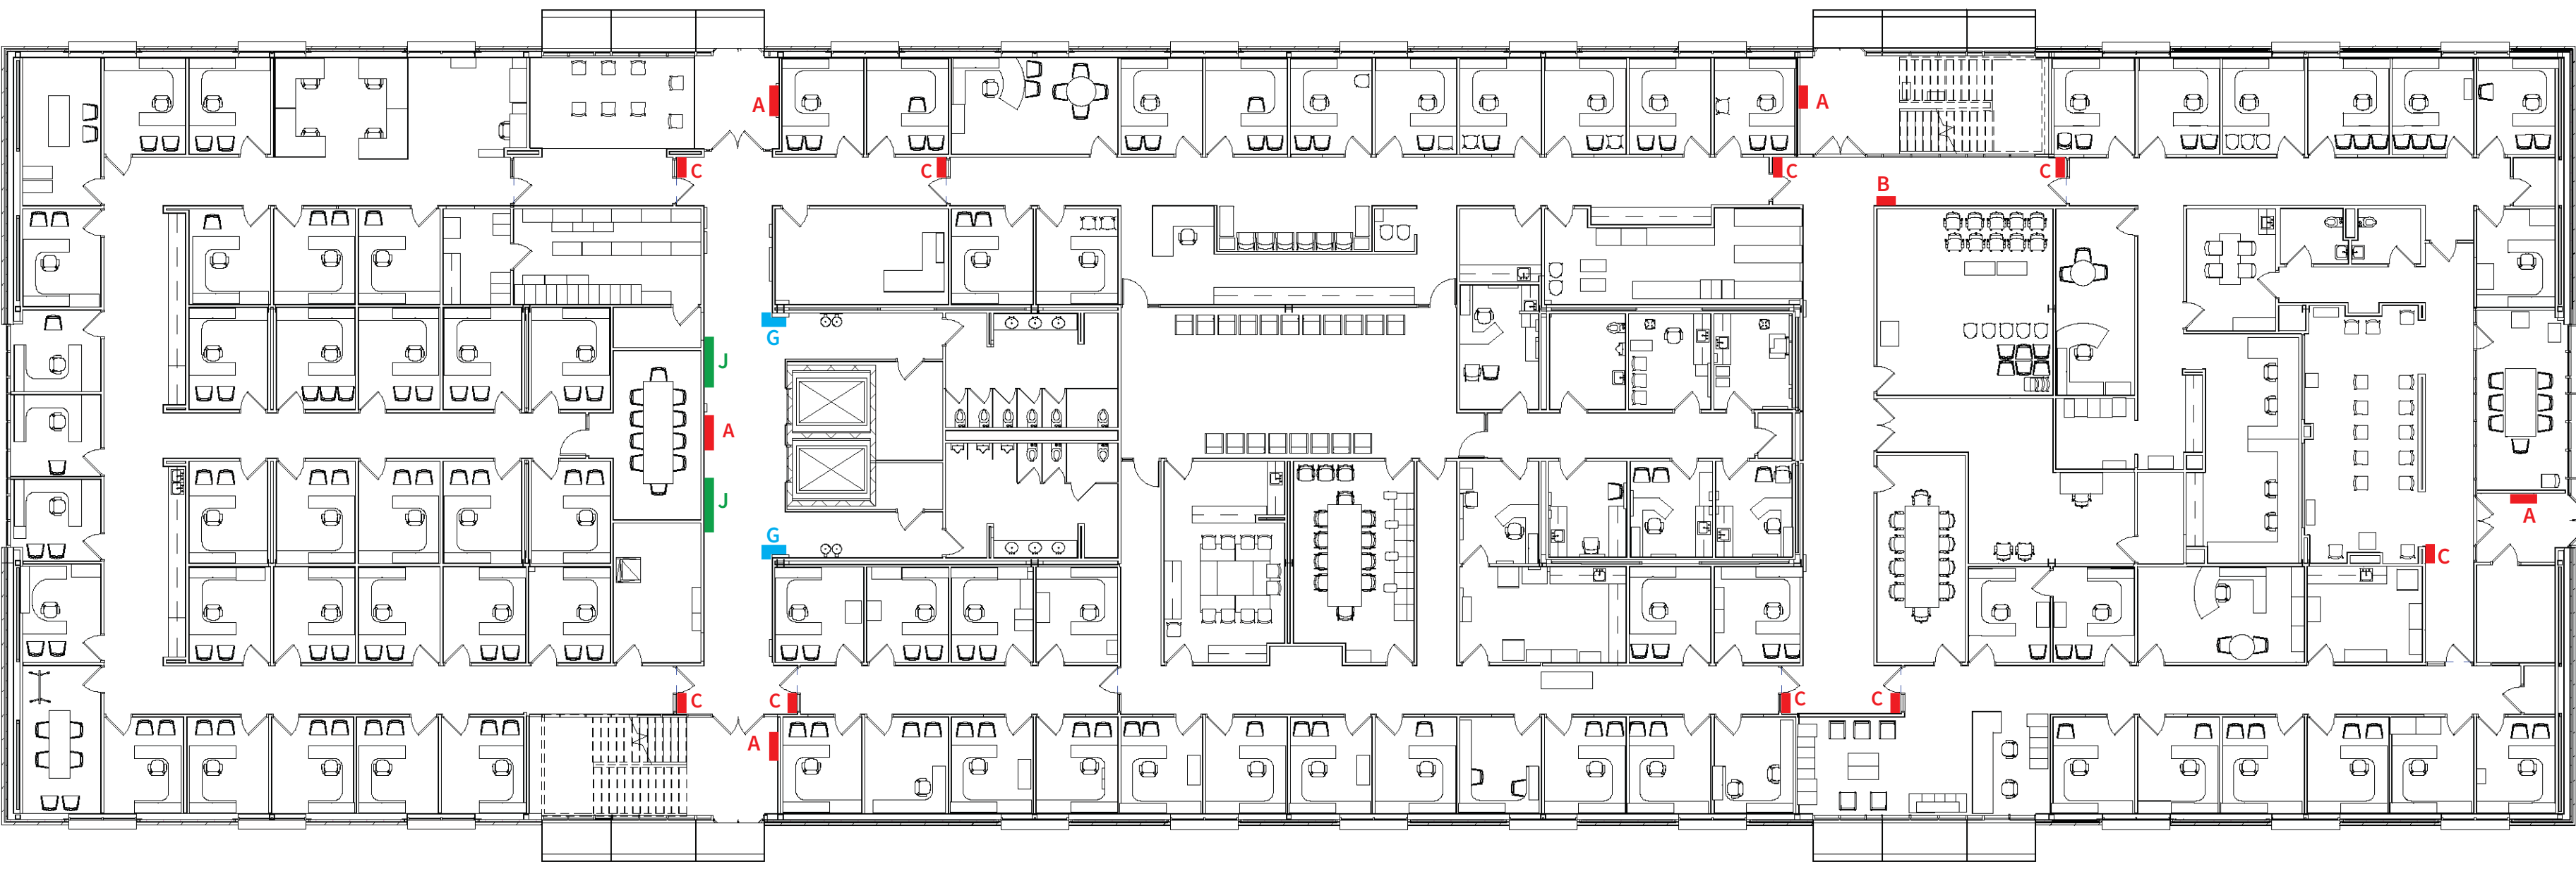

1 HHS EXISTING - LEVEL 1 FLOORPLAN
1/16" = 1'-0"

Key Plan:

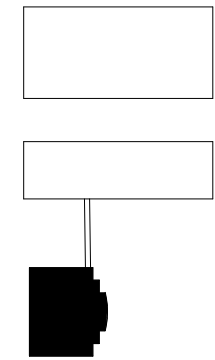


Revision	Description	Date
ADD 1	Addendum 1	06/02/2023

OPN Project No.
23412000


Sheet Issue Date:
BID DOCUMENTS 06/06/23

Sheet Name:
SIGN LOCATION PLANS
HHS BUILDING

Sheet Number:
AS001

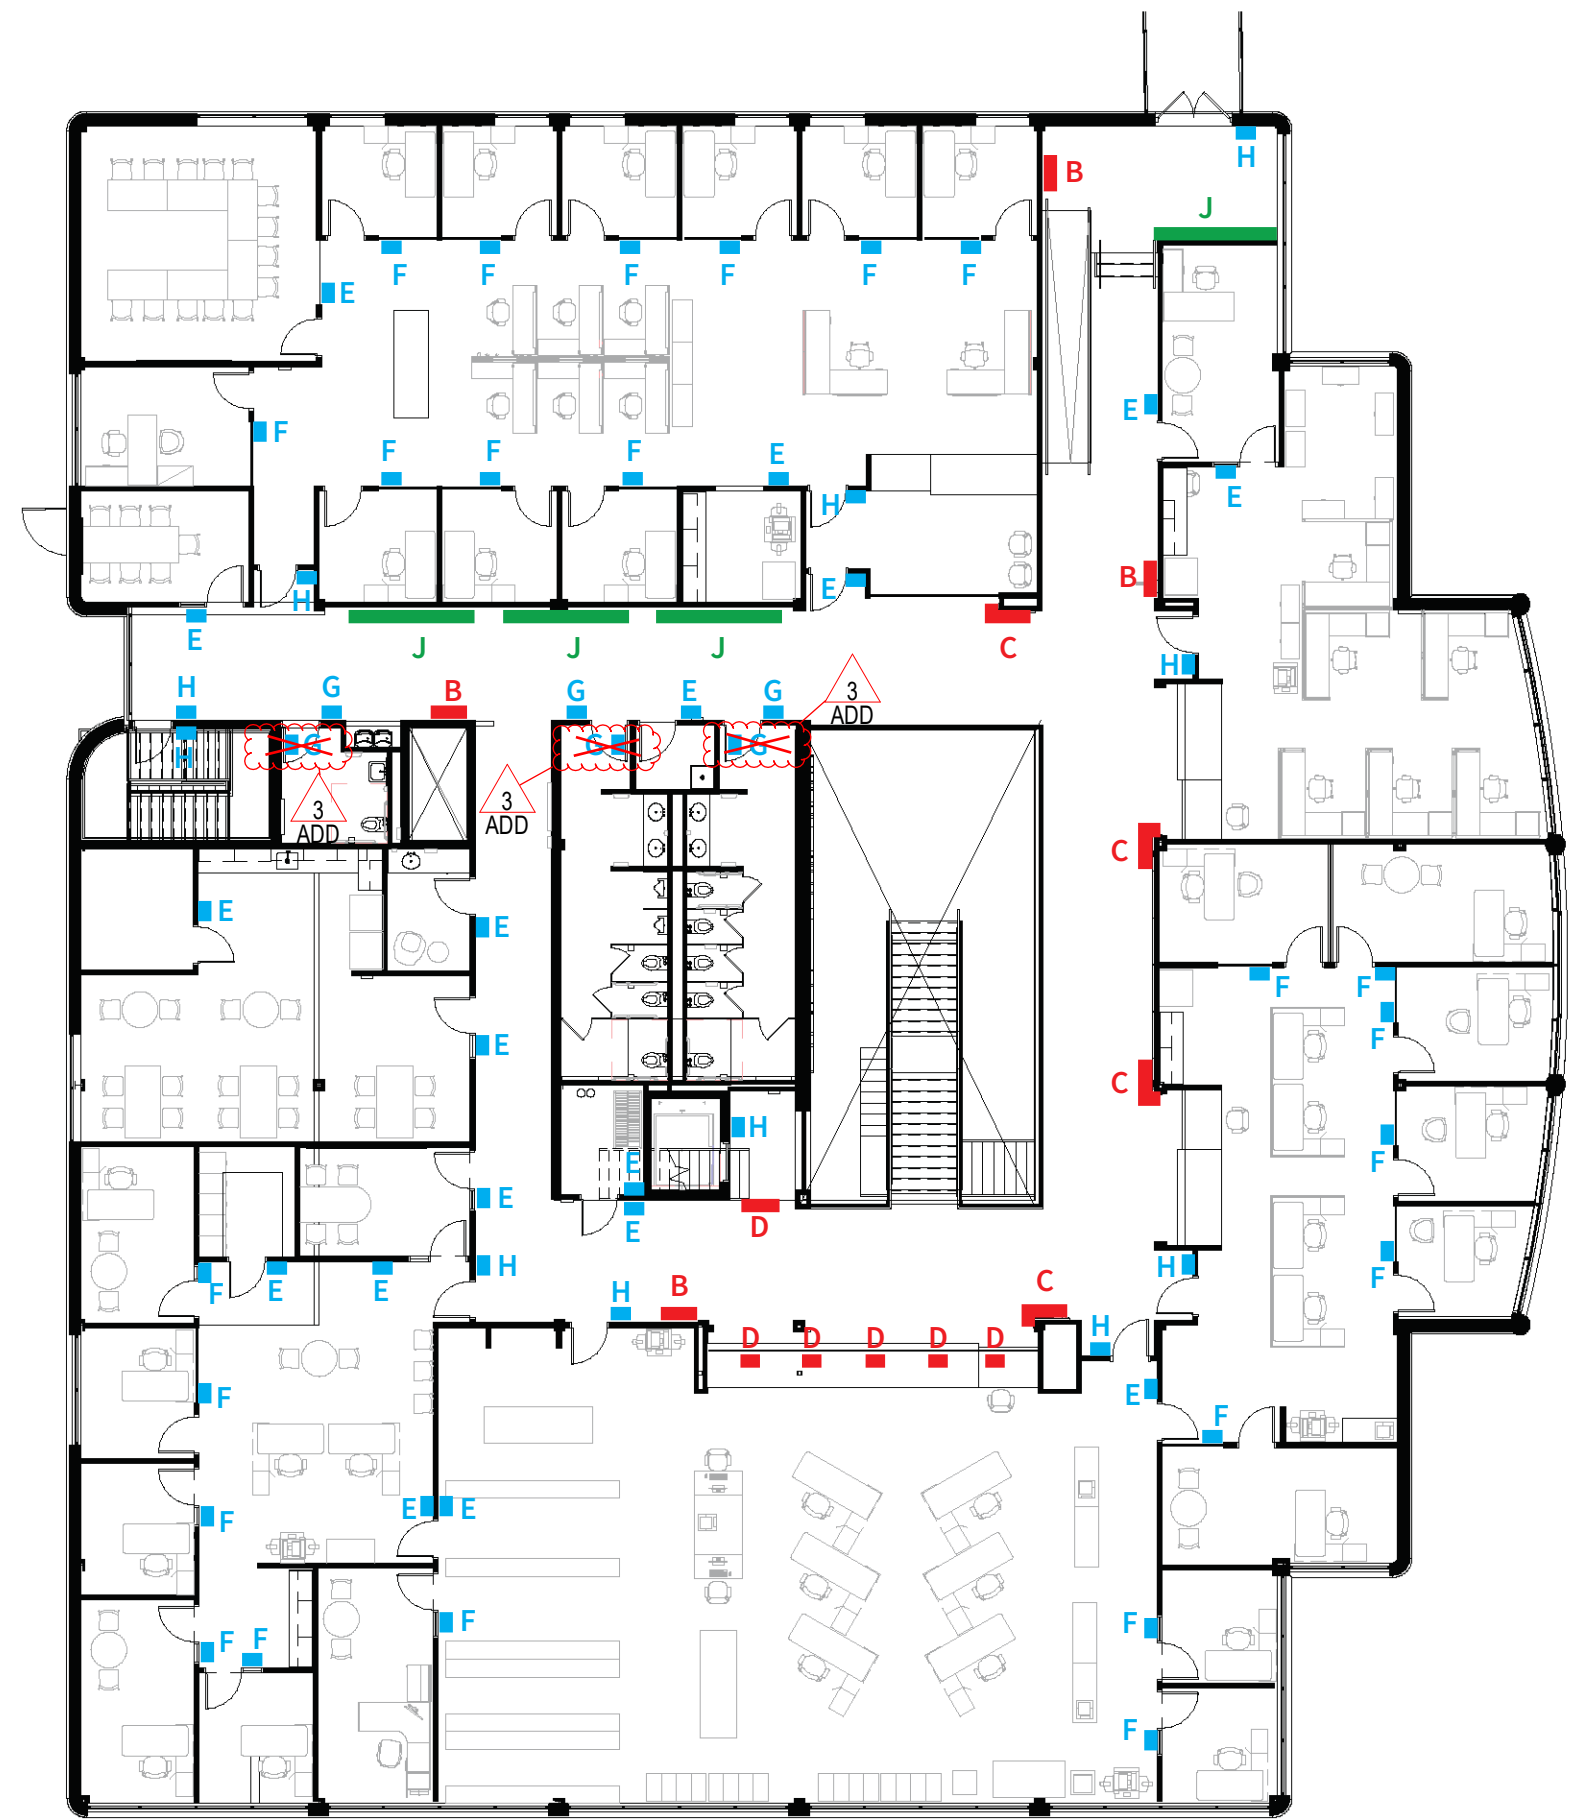

6 ADM - LEVEL 2 FLOOR PLAN
1/16" = 1'-0"

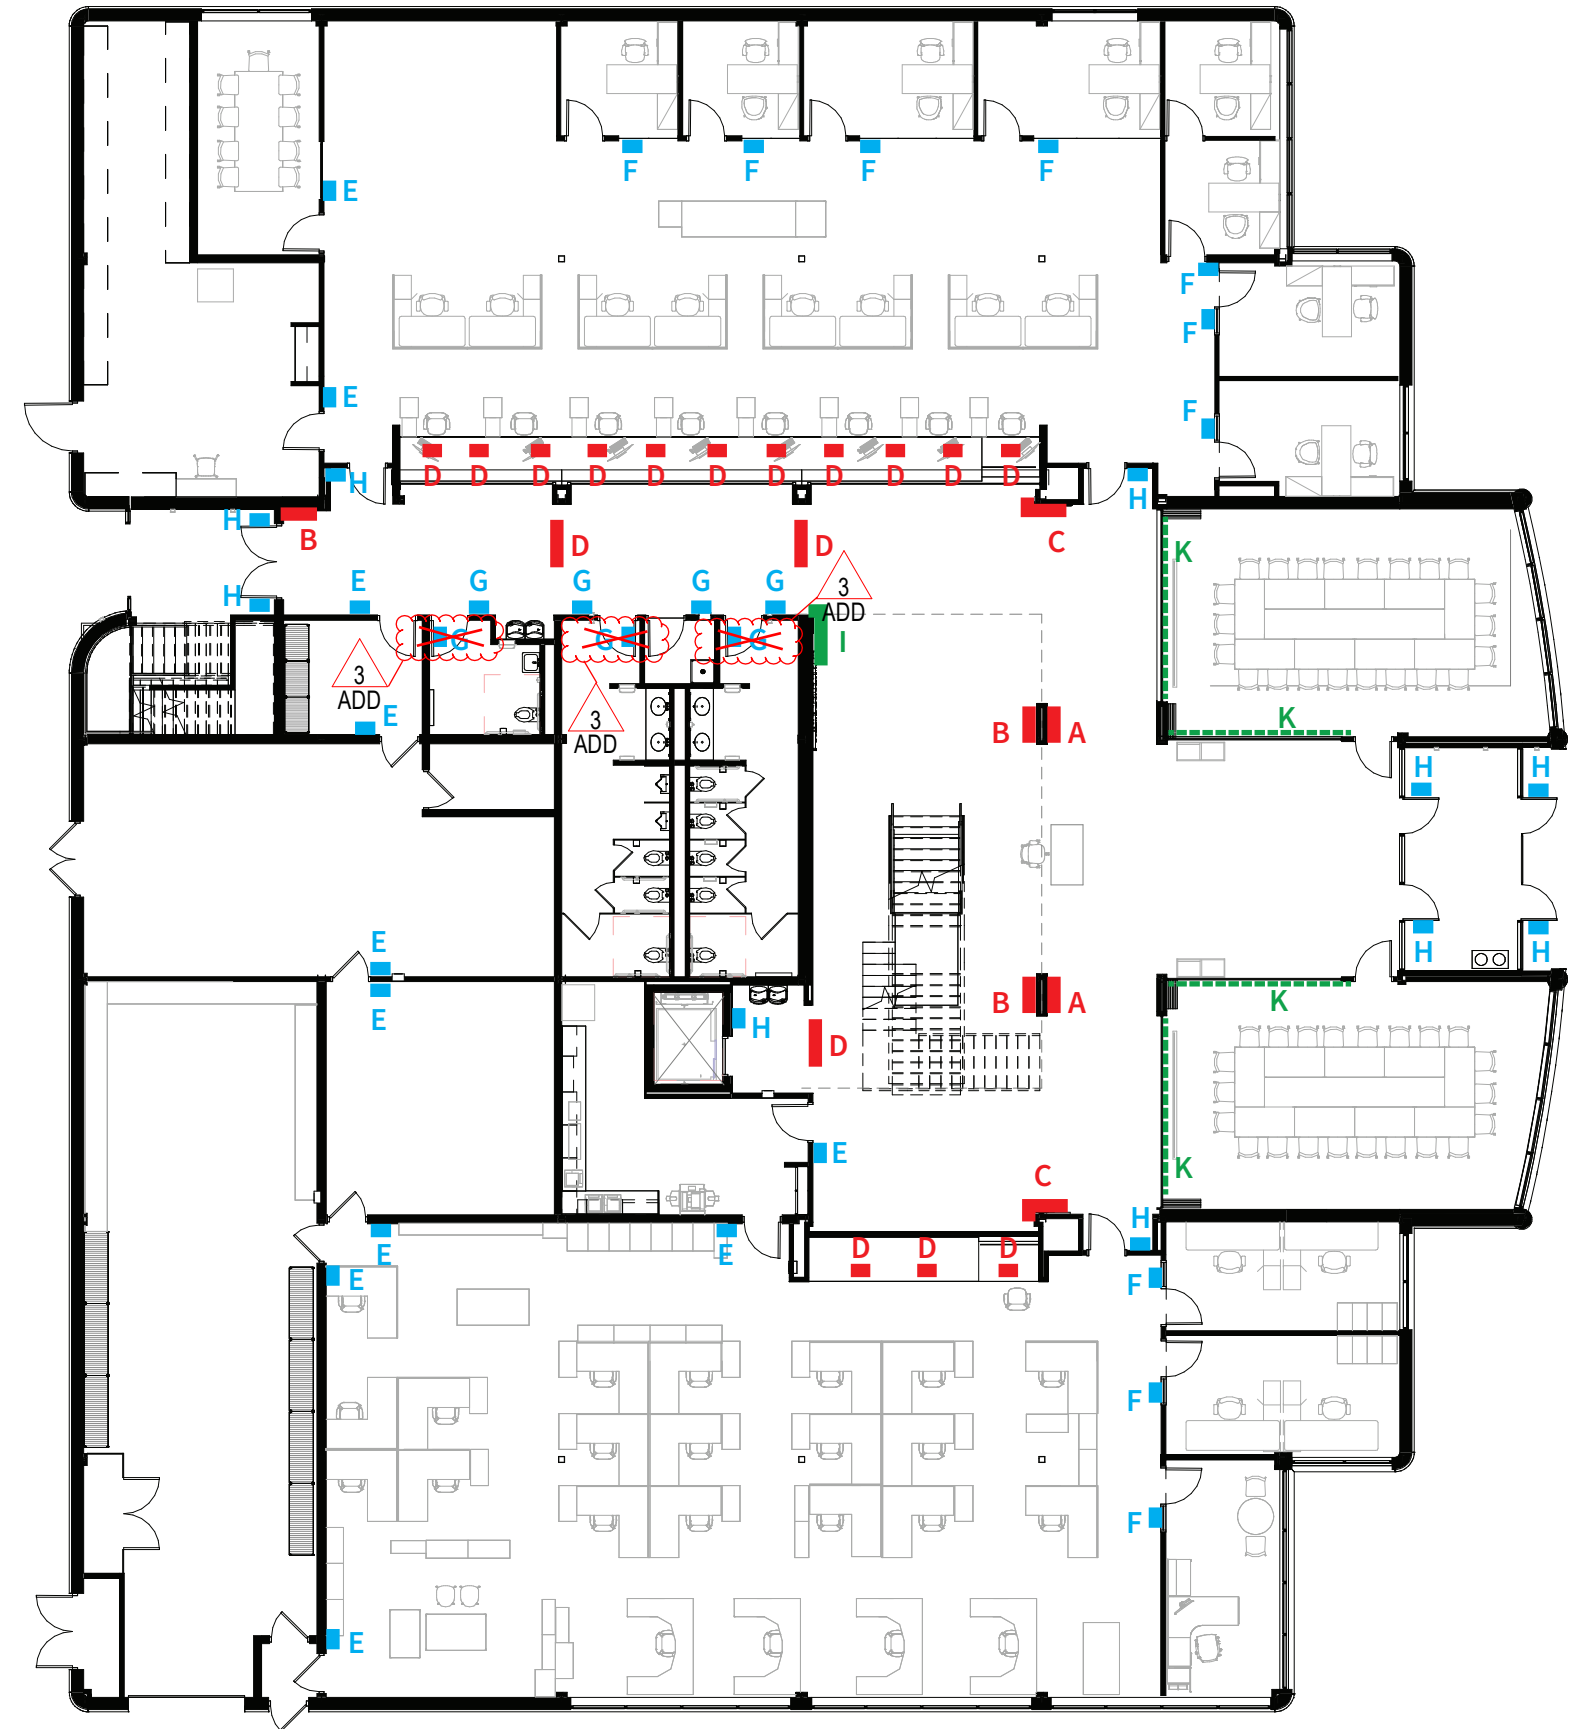

5 ADM - LEVEL 1 FLOOR PLAN
1/16" = 1'-0"

Sign Location Plans

Legend

WAYFINDING

Directories, Directional, and Destination signs to aid building navigation and identify departments.

Sign Types:

- A: DIRECTORY
- B: DIRECTIONAL
- C: DEPARTMENT
- D: OVERHEAD

ROOM SIGN (ADA)

Basic room signs with ADA compliant raised lettering and braille;

Sign Types:

- E: ROOM IDENTIFICATION
- F: OFFICE (name insert)
- G: RESTROOM
- H: REGULATORY


FEATURE MURAL/GRAPHICS

Themed Iowa/Johnson County printed images, graphics, or text onto material substrates such as fabric, aluminum, pvc, vinyl, or wallpaper.


Sign Types:

- I: INTERPRETIVE
- J: IMAGE PANELS
- K: PRIVACY VINYL
- L: DIMENSIONAL LETTERS


Key Plan:

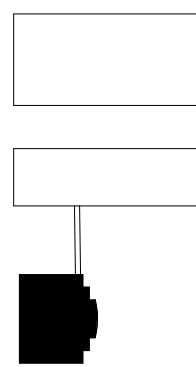


Revision	Description	Date
ADD-1	Addendum 1	06/02/2023

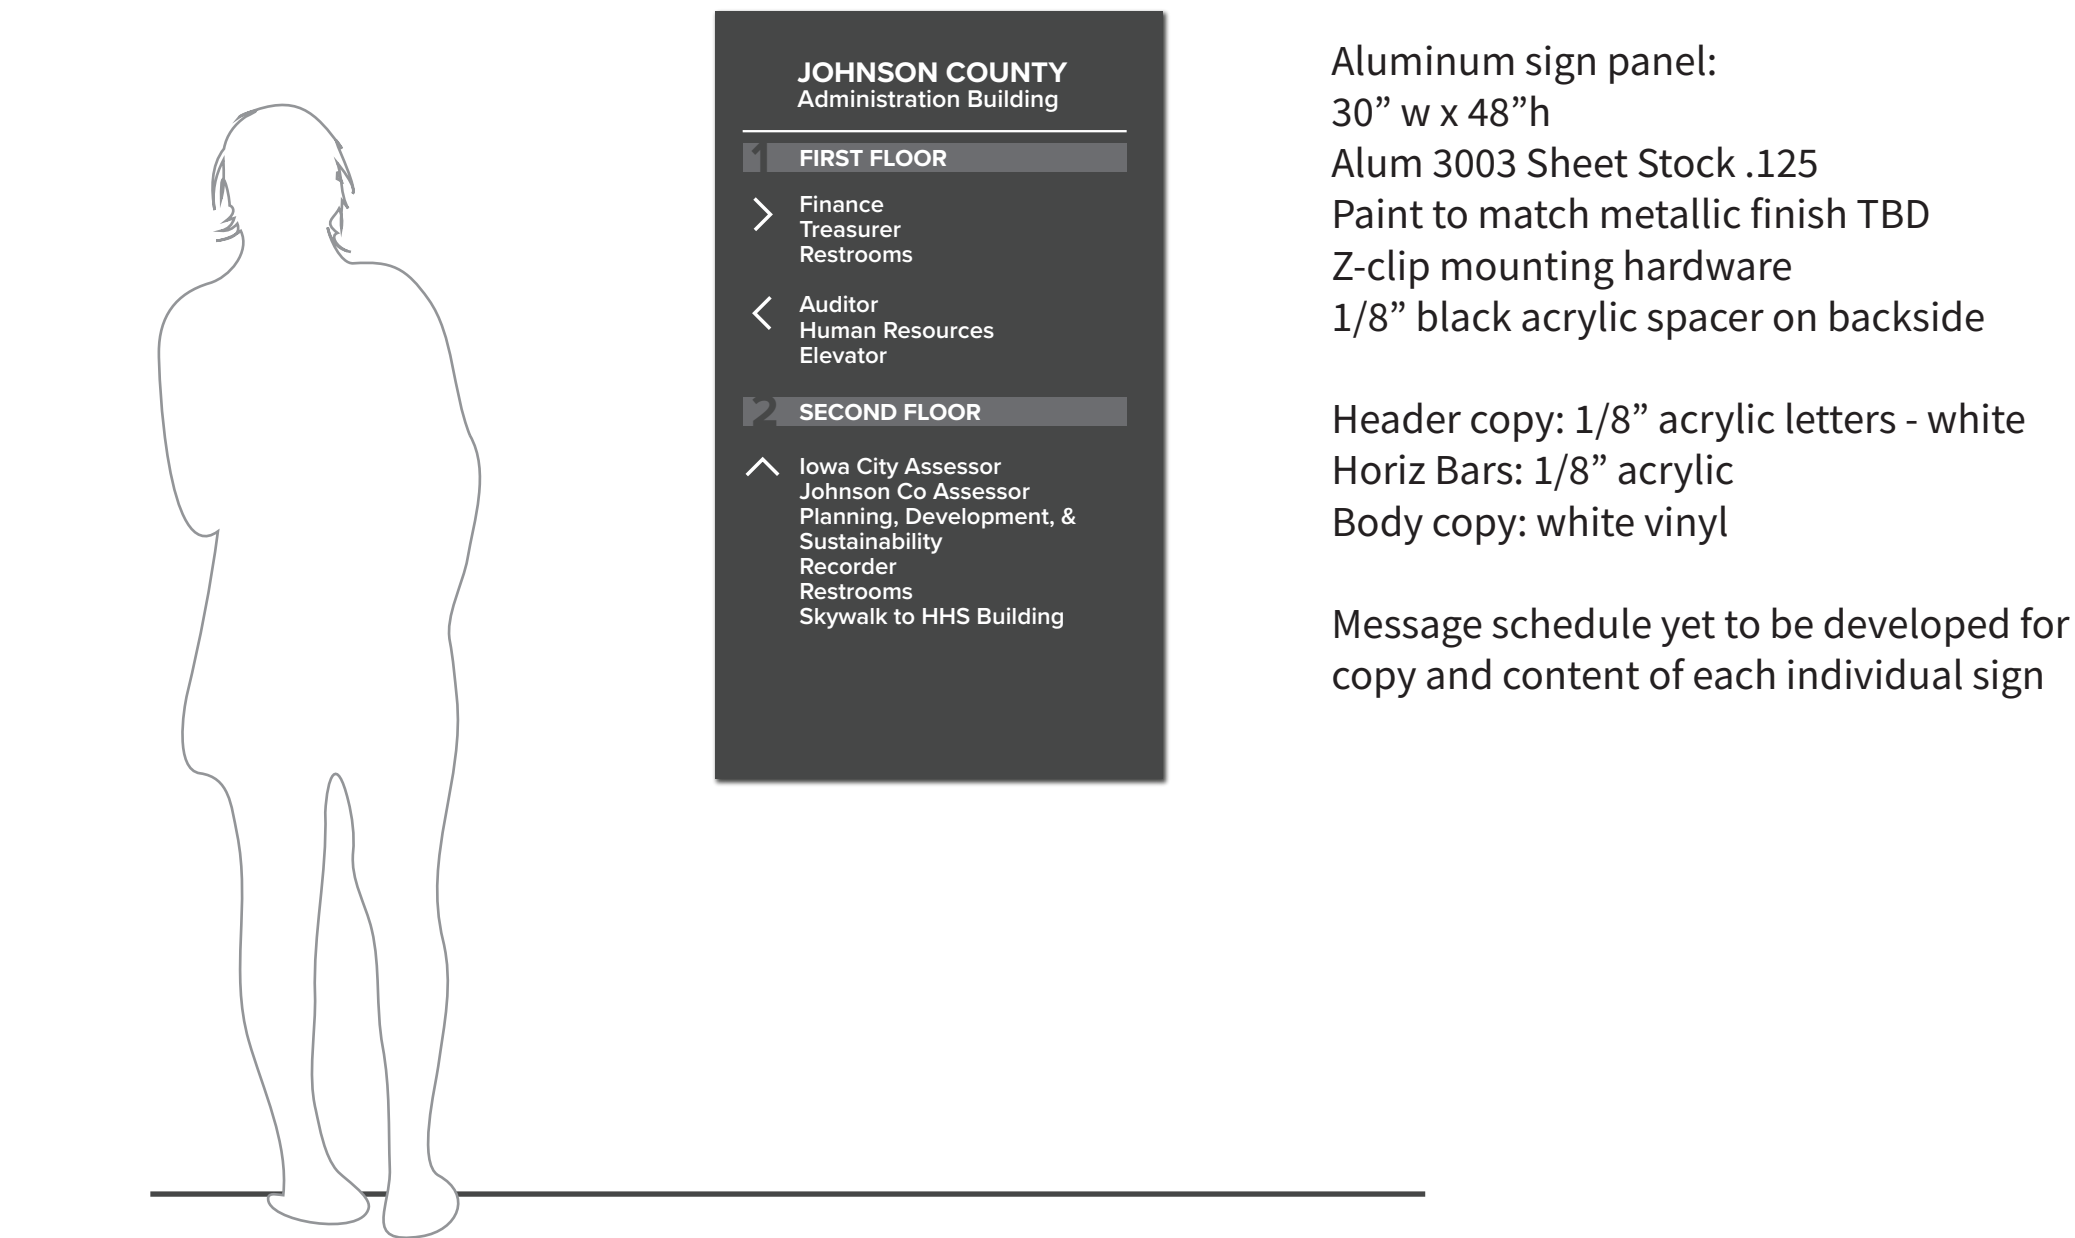


① **SIGN TYPE A: Directory / Building Information**
1"=1'-0"

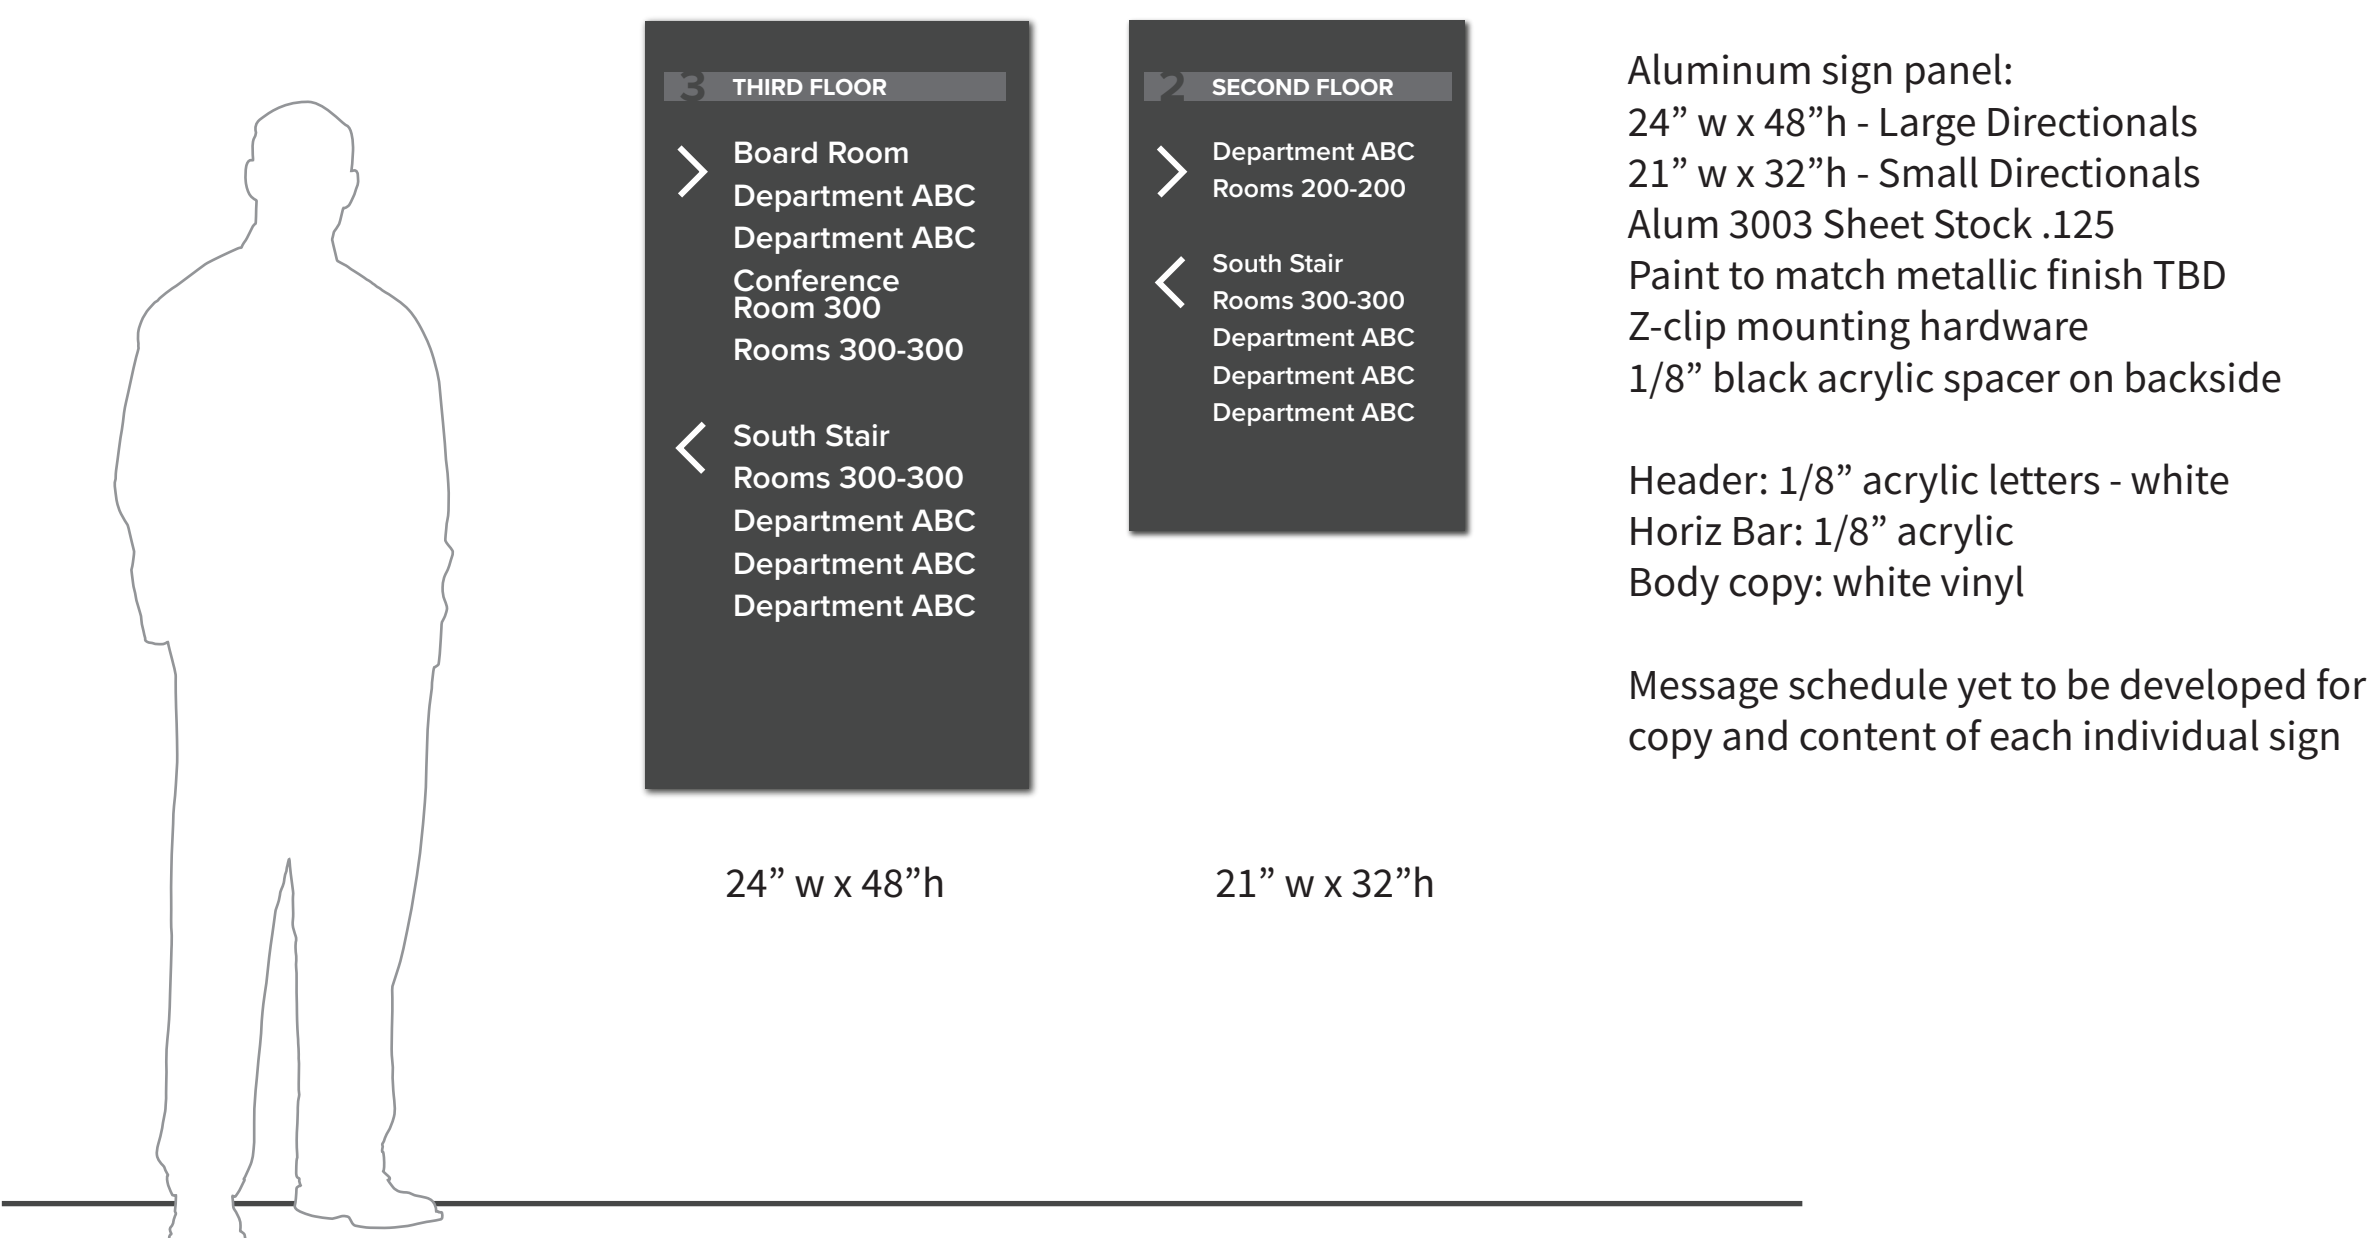


② **SIGN TYPE B: Directional**
1"=1'-0"

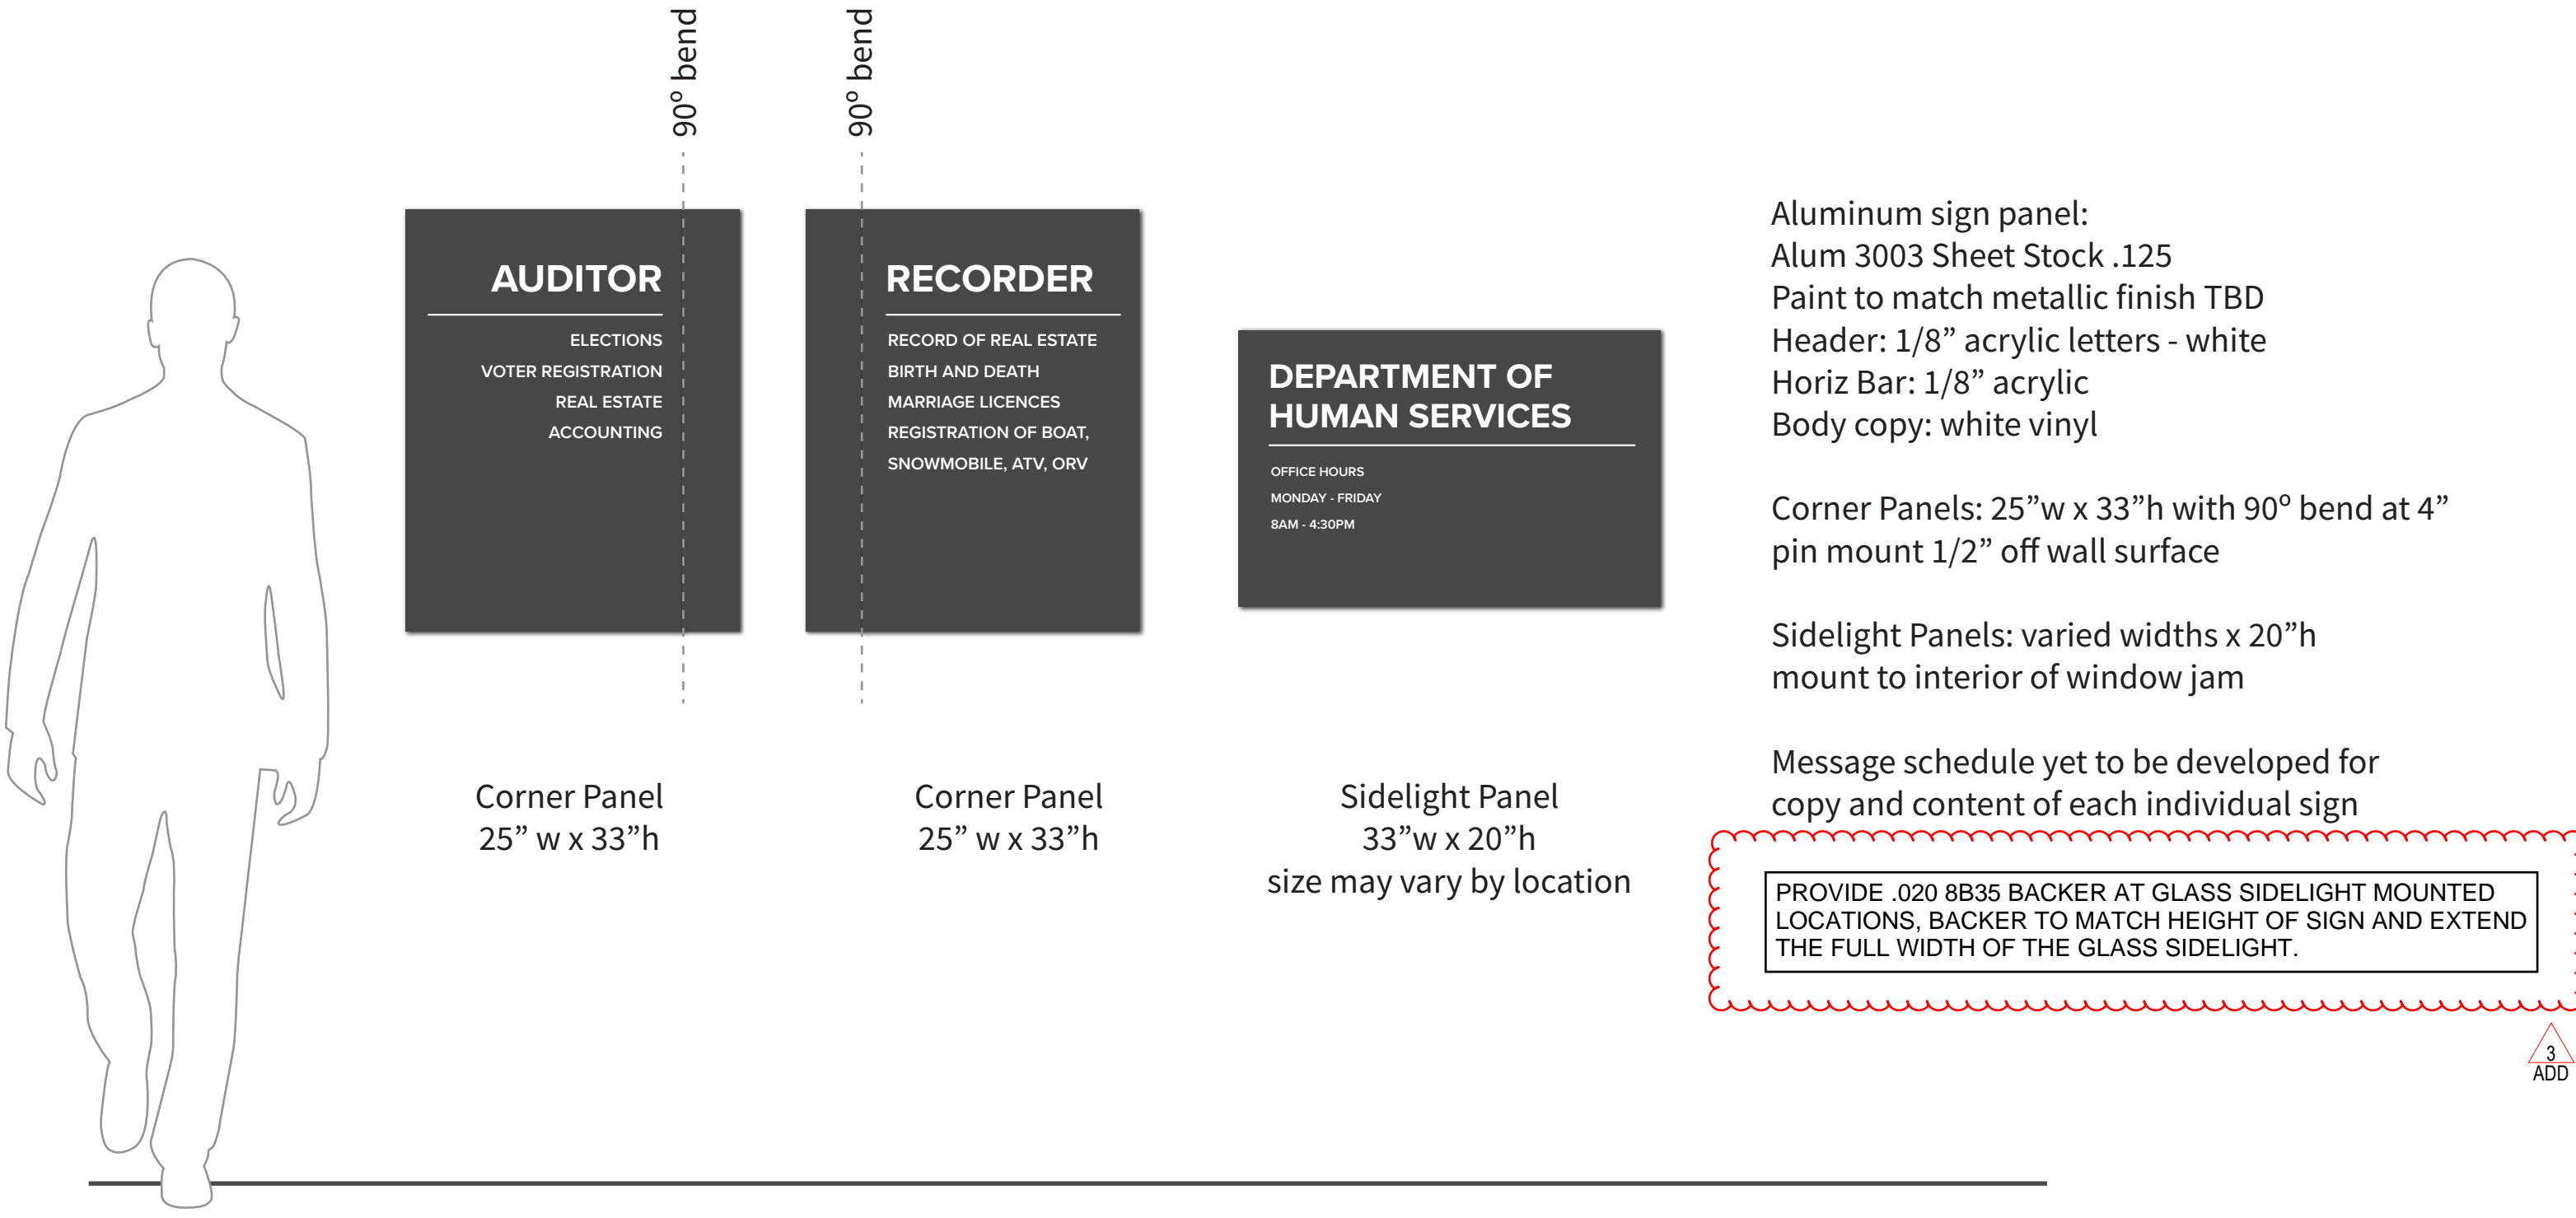

③ **SIGN TYPE C: Department**
1"=1'-0"

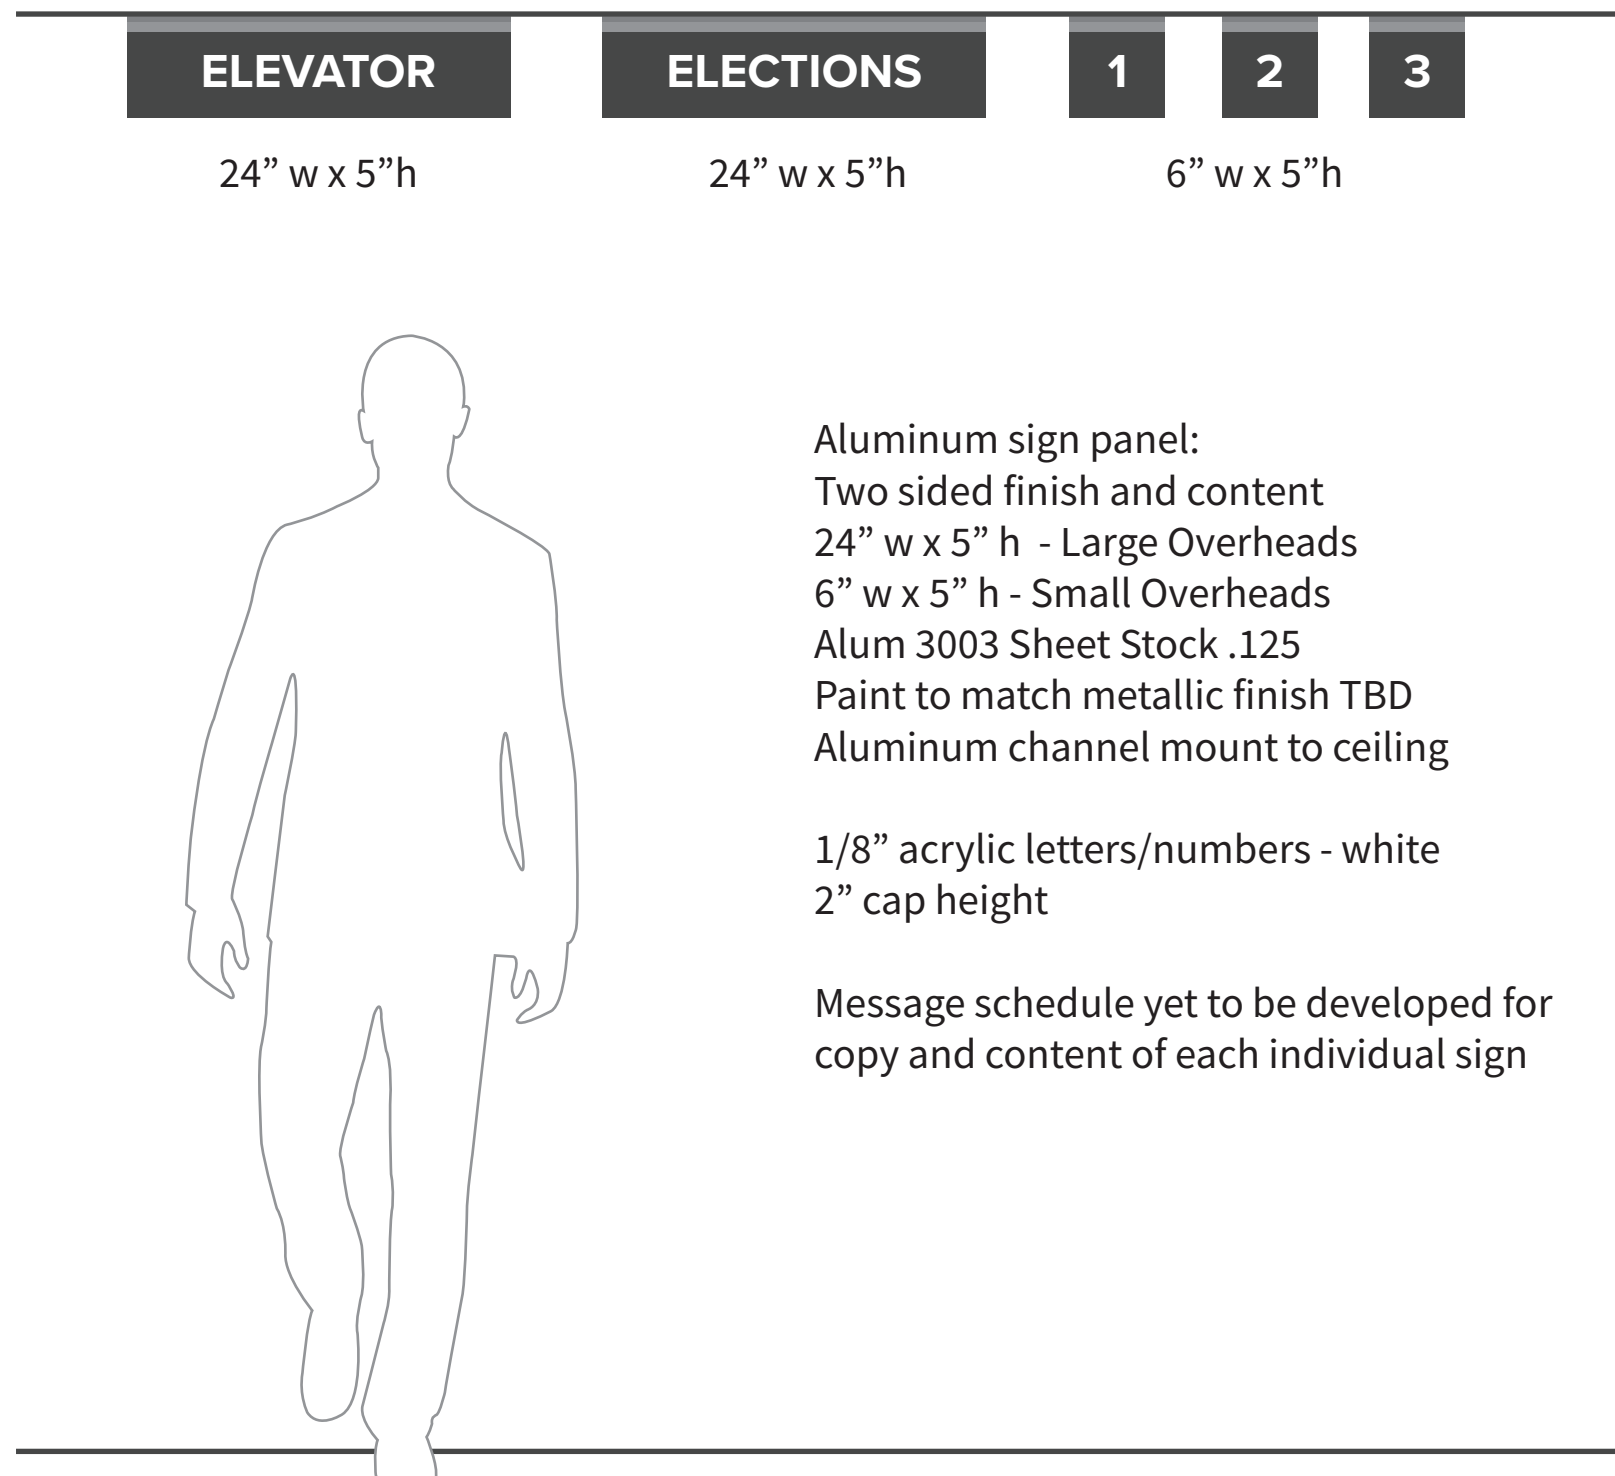


④ **SIGN TYPE D: Overhead**
1"=1'-0"

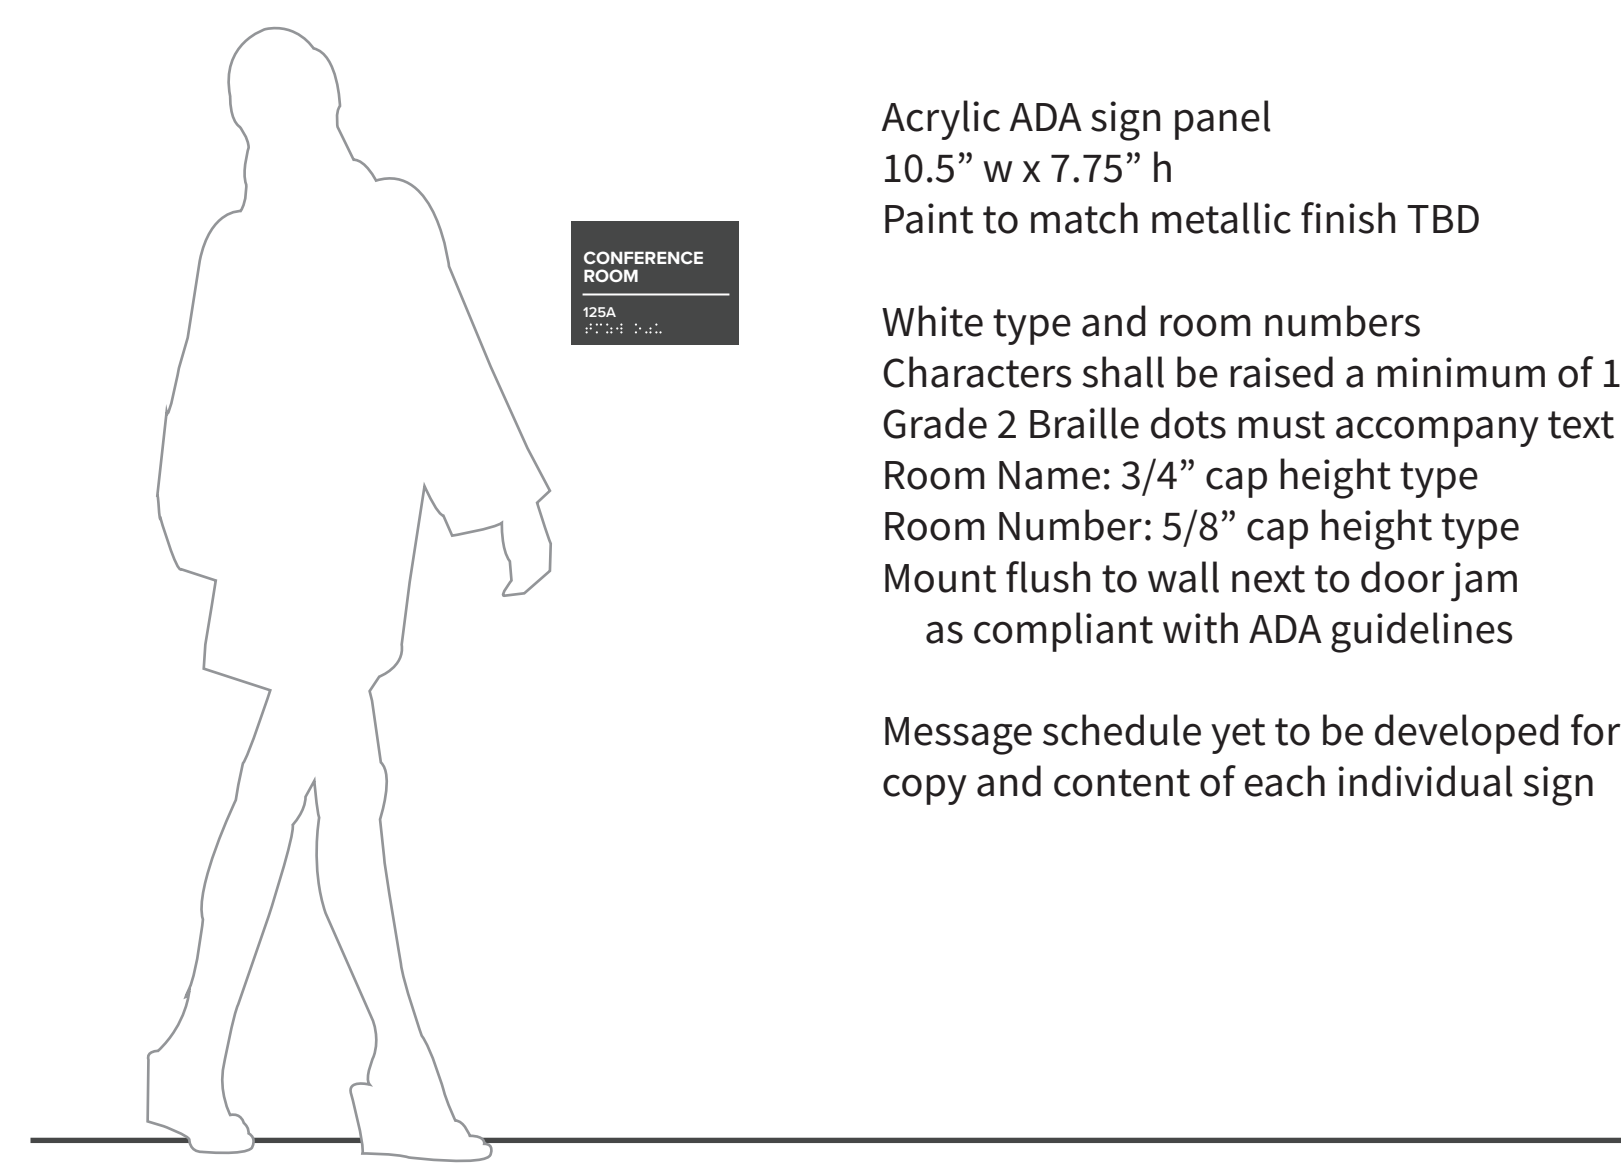


⑤ **SIGN TYPE E: Room (ADA)**
1"=1'-0"




⑥ **SIGN TYPE E: Room (ADA) - Enlarged dimensioned view**
50% Scale

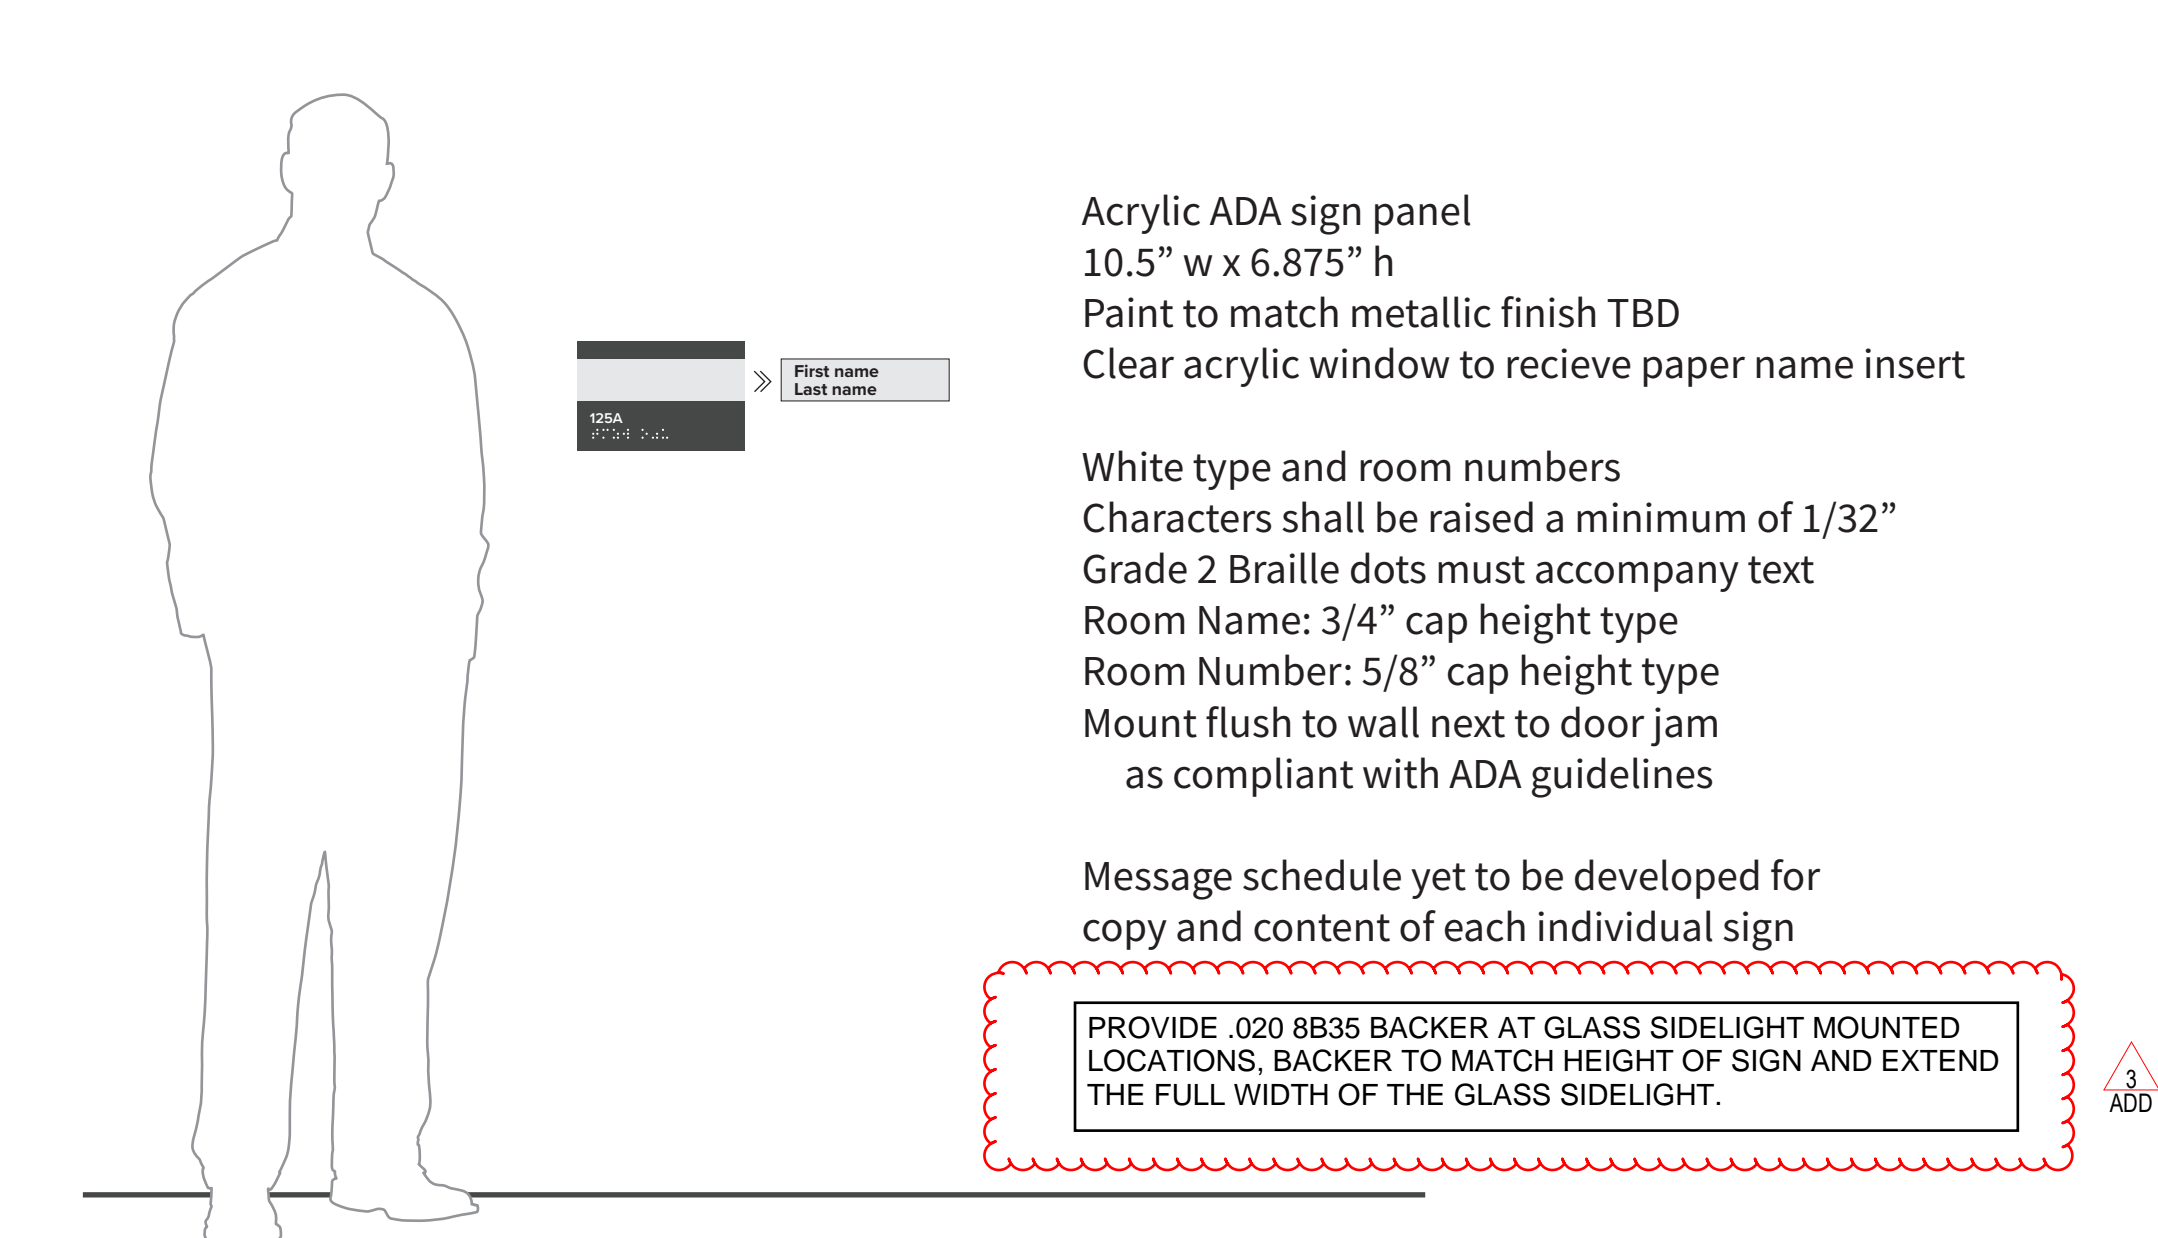

⑦ **SIGN TYPE F: Office (ADA) with Insert**
1"=1'-0"

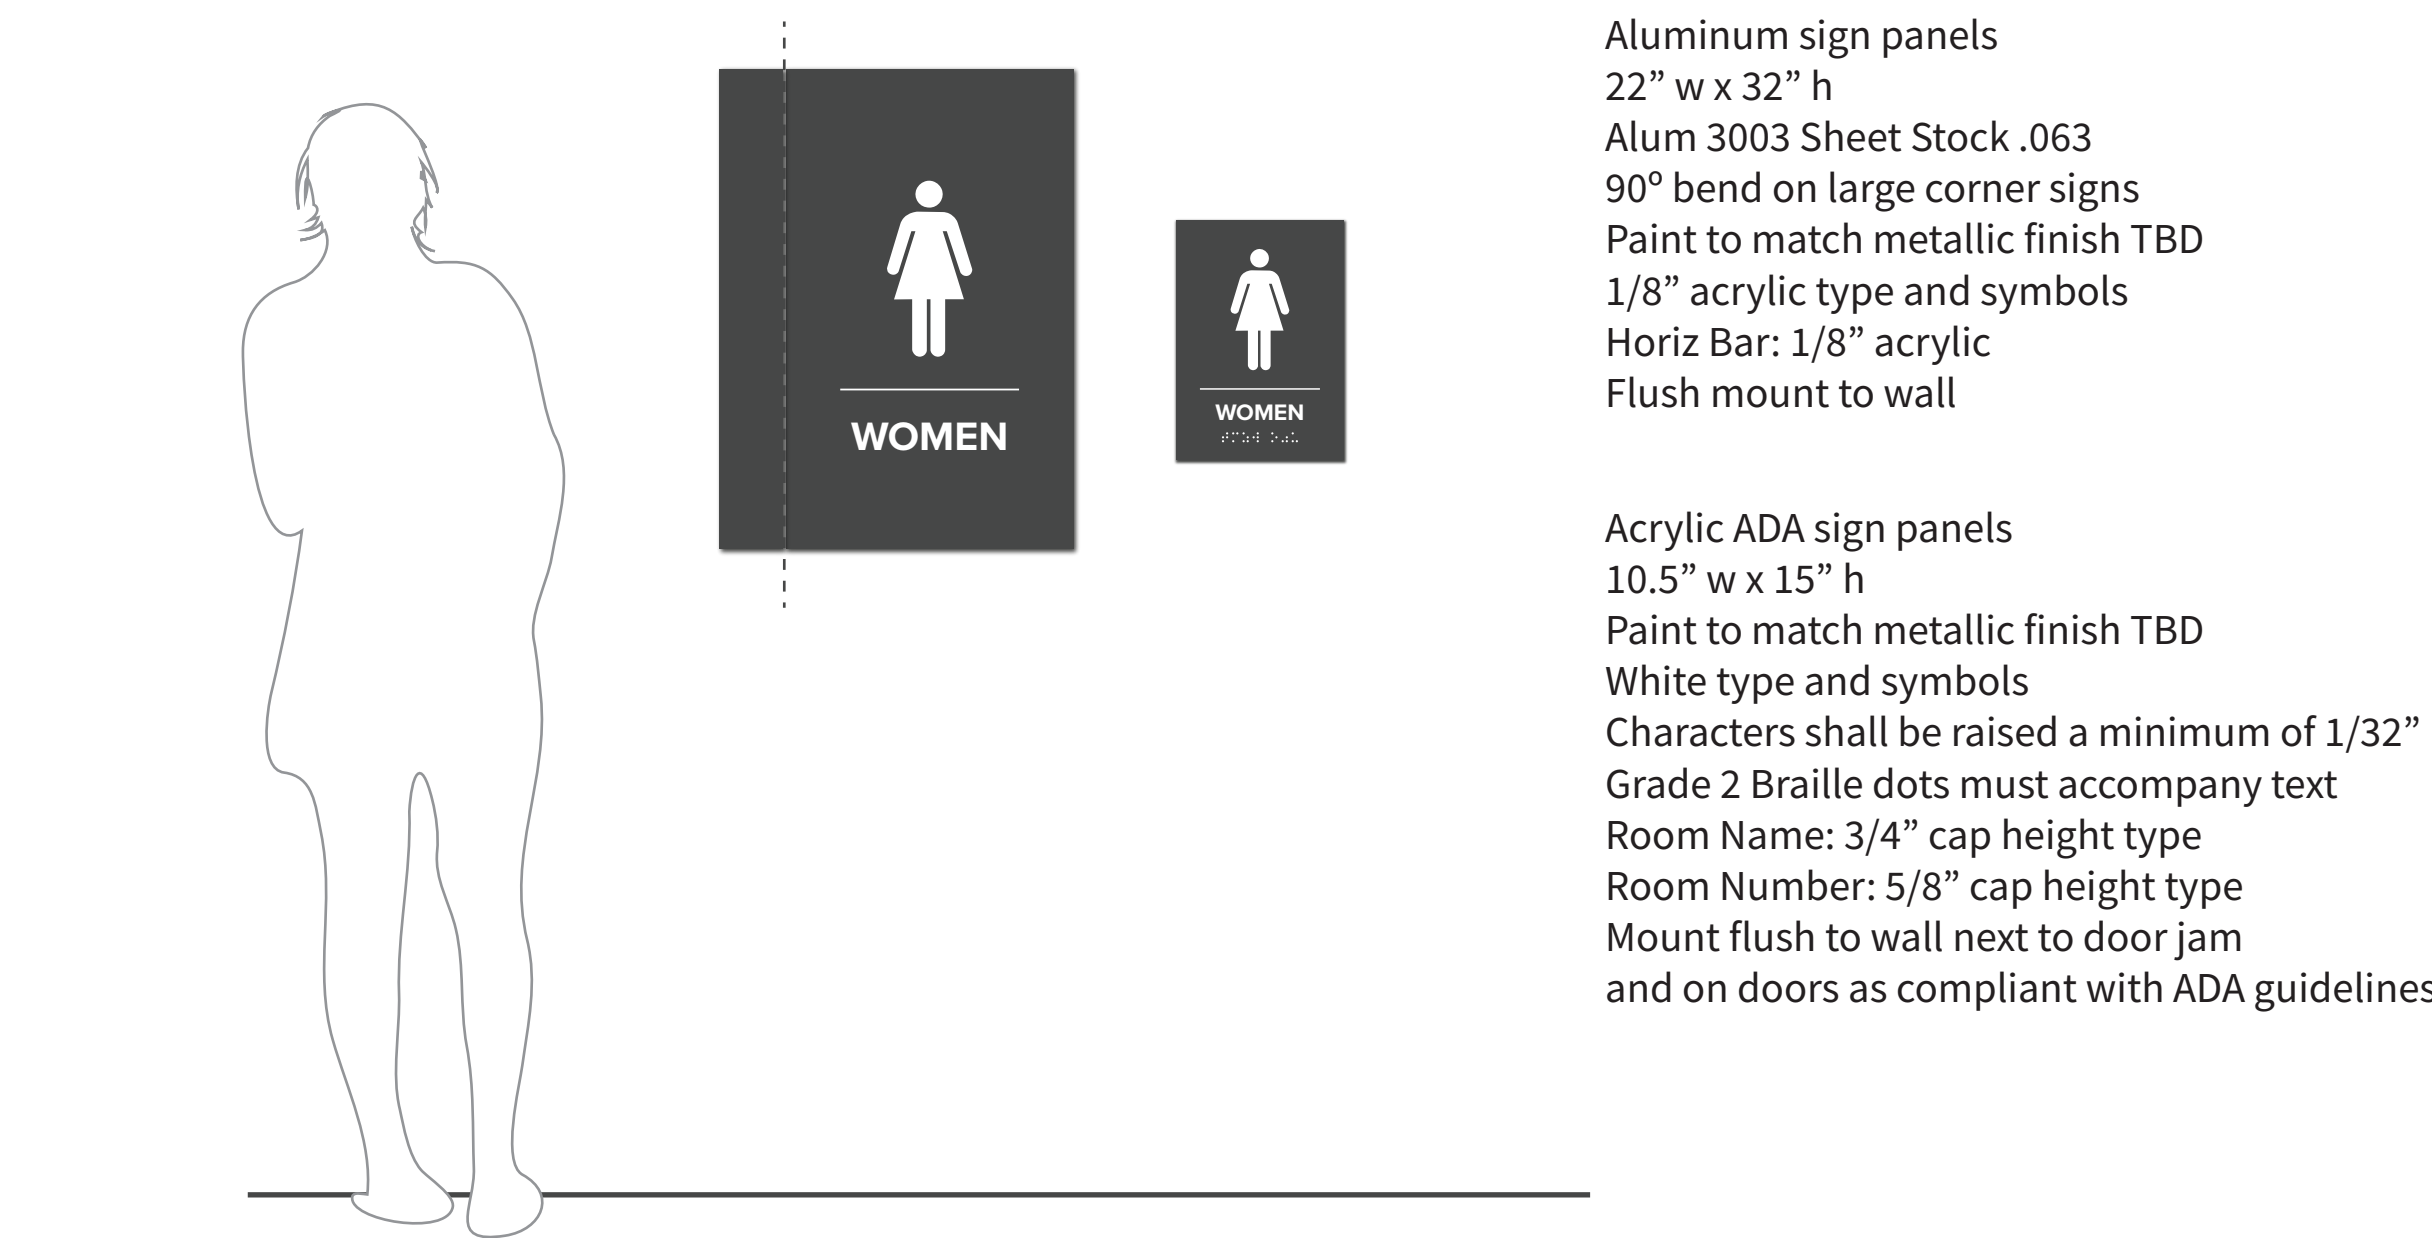

⑧ **SIGN TYPE G: Restroom**
1"=1'-0"

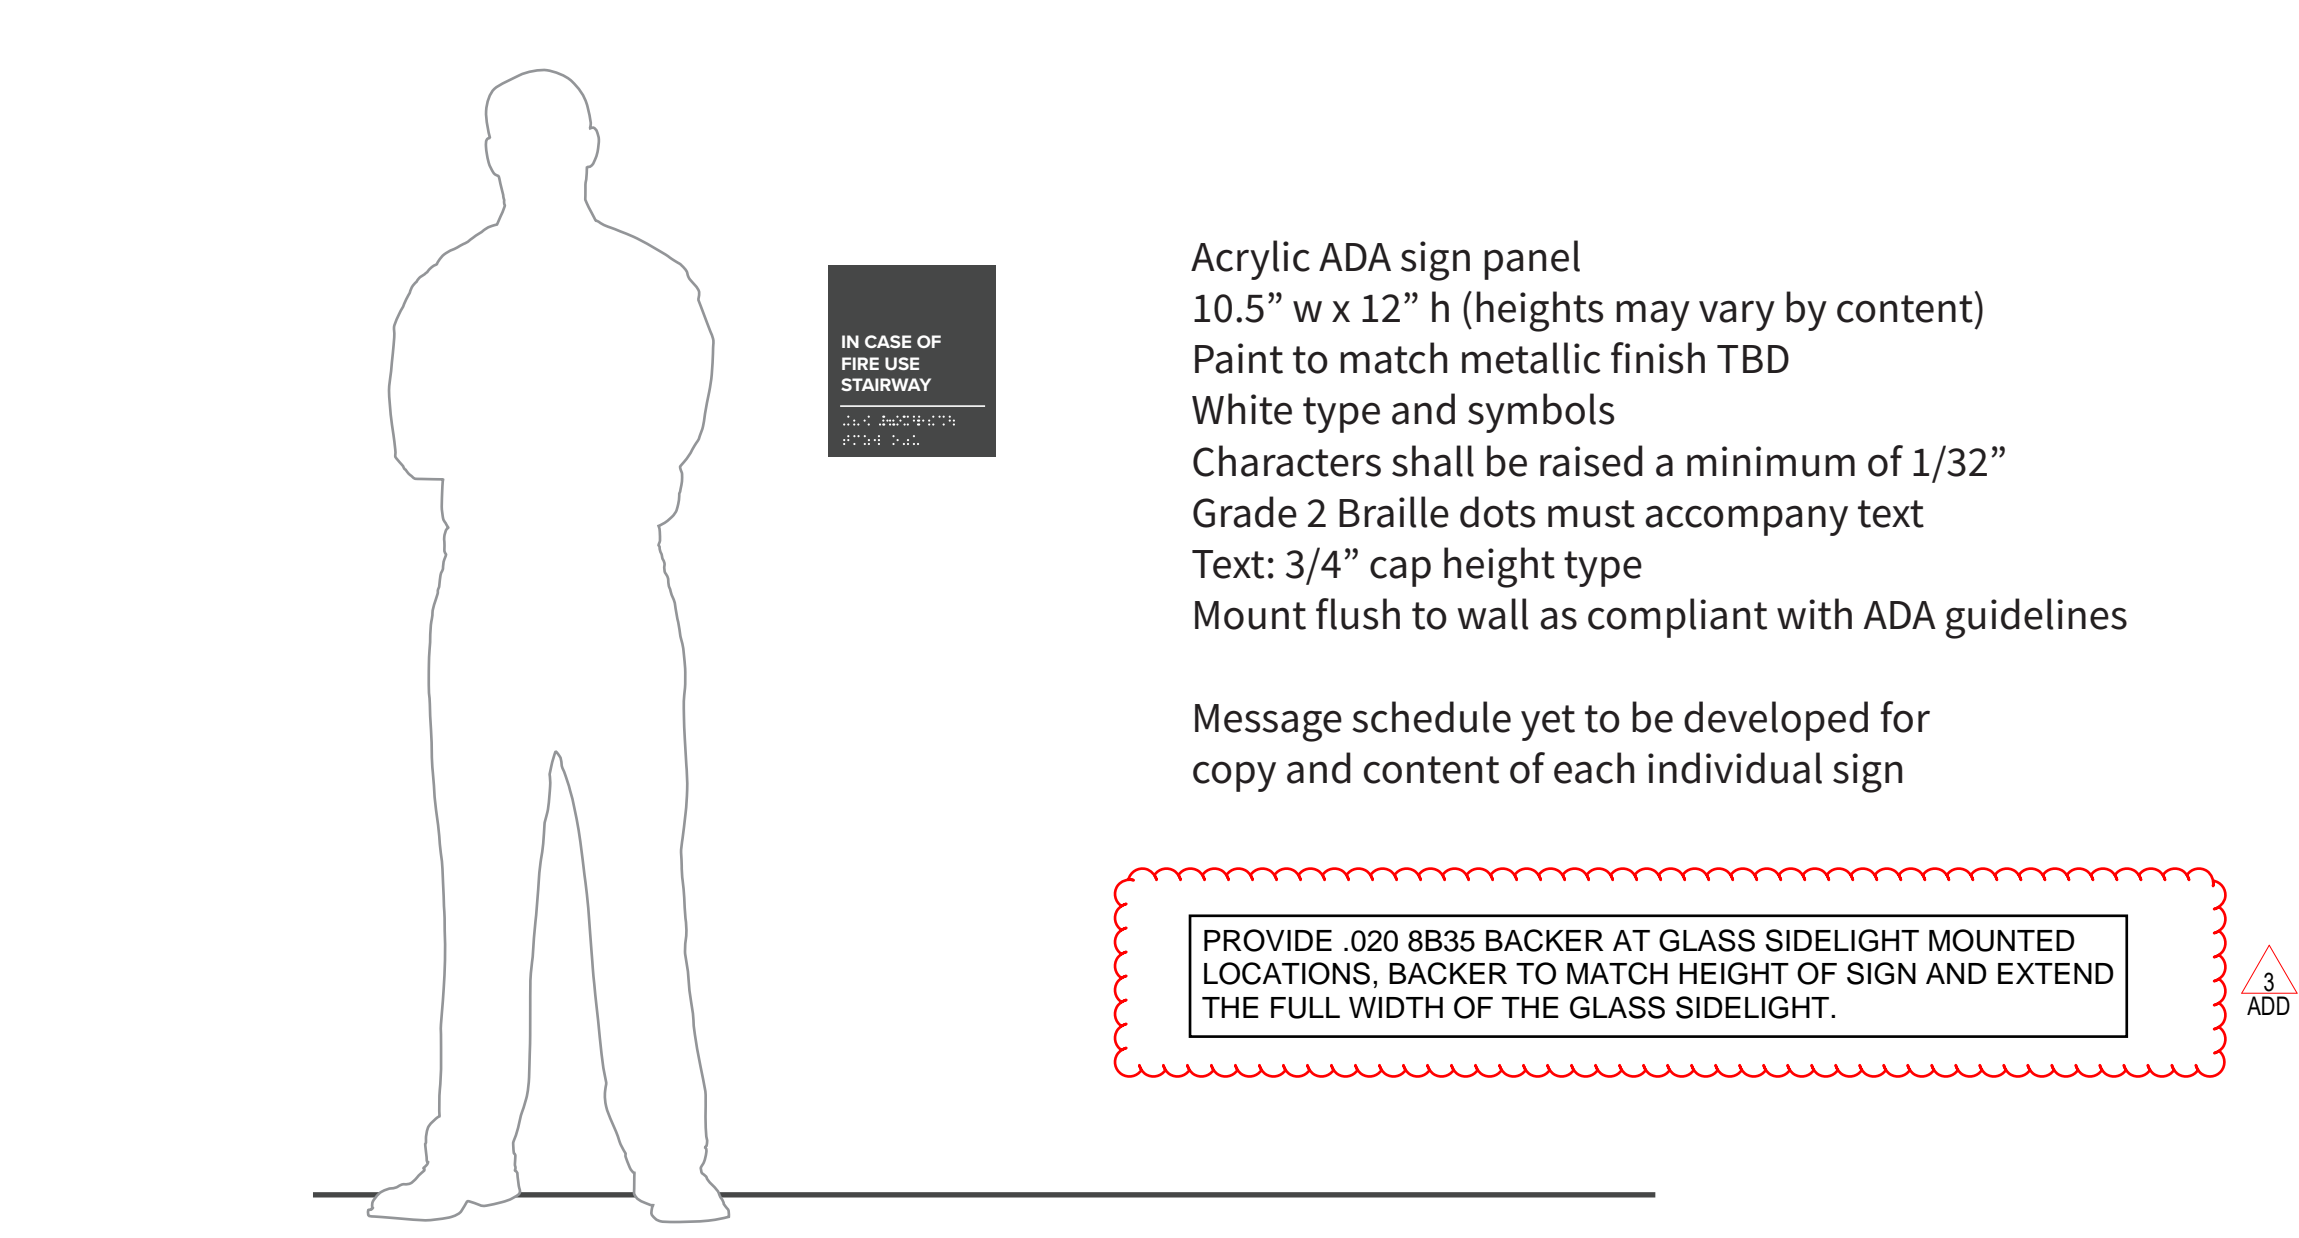

⑨ **SIGN TYPE H: Regulatory**
1"=1'-0"